


FIELD RIVETS AND BOLTS							DATE	/ /	DATE	/ /	DRAWINGS	ORDER No. H-3804 ^M	SHEET No. EF 1
							NAME	LBC	10	H 40	FABRICATION Elmira		

2

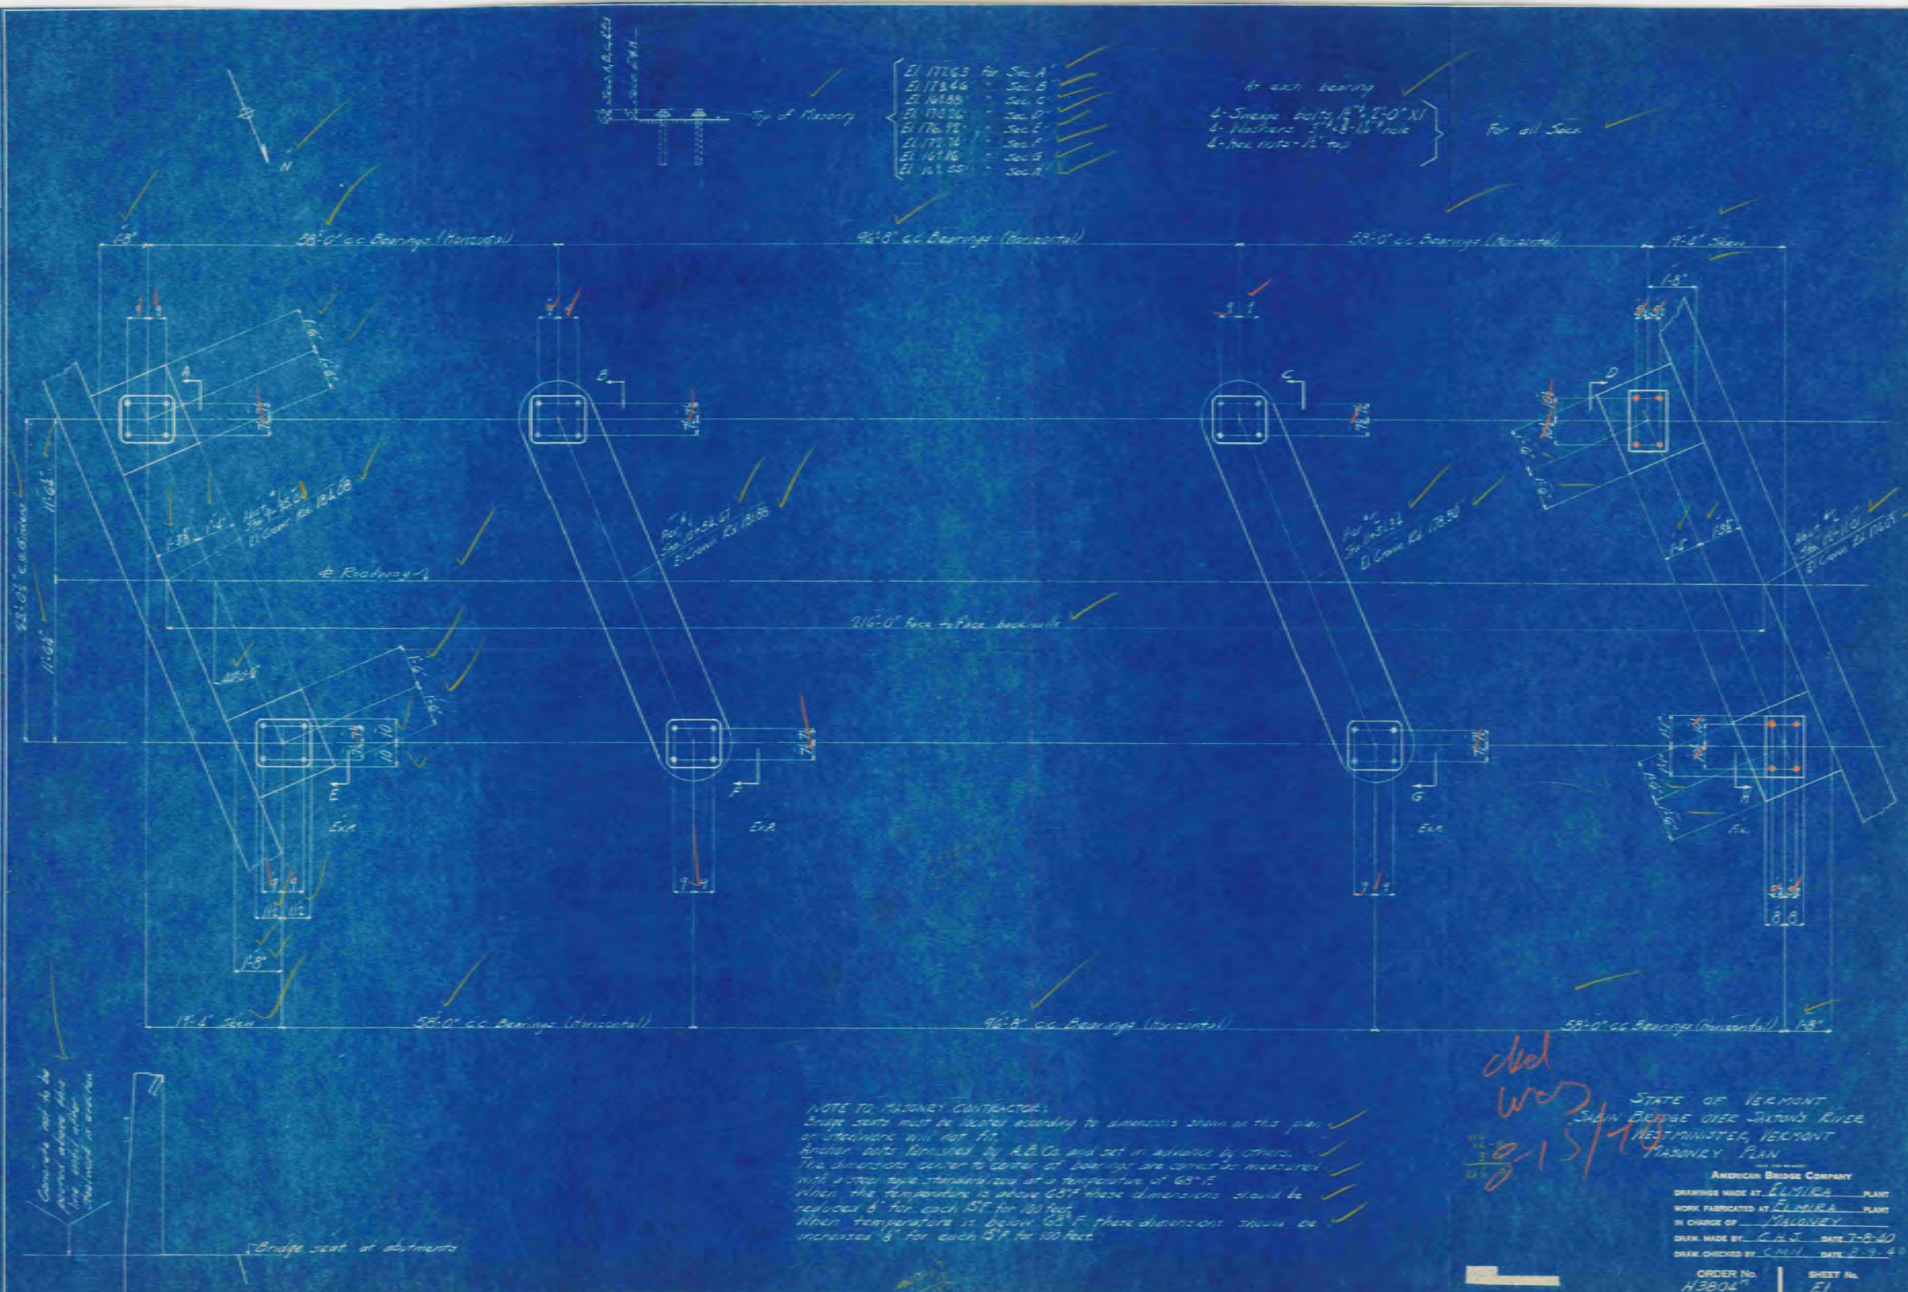

STATE OF VERMONT
SABIN BRIDGE OVER SAKON RIVER
NESTMINSTER, VERMONT
MASONRY PLAN


AMERICAN BRIDGE COMPANY
DRAWINGS MADE AT ELMIRA PLANT
WORK FABRICATED AT ELMIRA PLANT
IN CHARGE OF MALONEY
DRAWN BY C.H.J. DATE 7-8-40
CHECKED BY C.M.H. DATE 8-9-40

ORDER No. H3804 ⁷	SHEET No. E1
---------------------------------	-----------------



El. 177.63	for Sec. A
El. 178.46	" Sec. B
El. 181.85	" Sec. C
El. 170.36	" Sec. D
El. 176.92	" Sec. E
El. 175.74	" Sec. F
El. 167.16	" Sec. G
El. 167.65	" Sec. H

At each bearing
 4- Sledge bolts $1\frac{1}{2}'' \times 8'-0'' \times 1'$
 4- Washers $5'' \times 8'-0''$ hole
 4- Hex nuts $1\frac{1}{2}''$ top
 For all Secs.

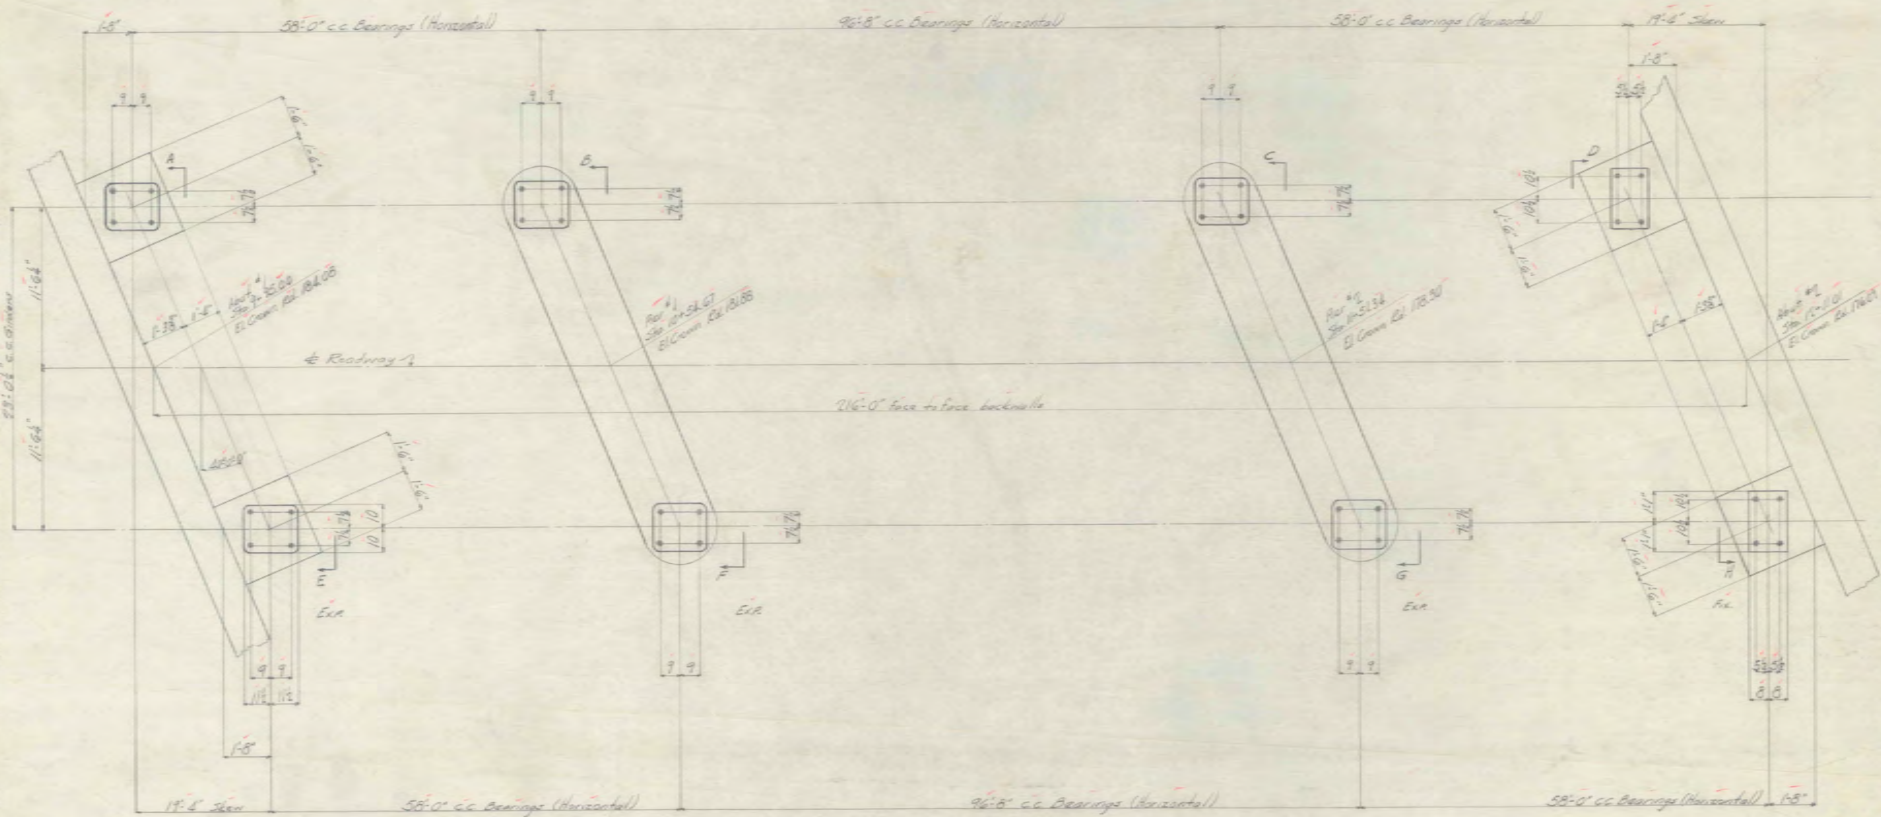




Concrete not to be
 exposed above floor
 line until after
 the road is complete

Bridge seat at abutments

NOTE TO MASONRY CONTRACTOR:
 Bridge seats must be located according to dimensions shown on this plan or steelwork will not fit.
 Anchor bolts furnished by A.B. Co. and set in advance by others.
 The dimensions center to center of bearings are correct as measured with a steel tape standardized at a temperature of 68°F.
 When the temperature is above 68°F these dimensions should be reduced $\frac{1}{8}''$ for each 15°F for 100 feet.
 When temperature is below 68°F these dimensions should be increased $\frac{1}{8}''$ for each 15°F for 100 feet.

STATE OF VERMONT
 SABIN BRIDGE OVER JANTON'S RIVER
 WESTMINSTER, VERMONT
 MASONRY PLAN

AMERICAN BRIDGE COMPANY
 DRAWING MADE AT ELIZABETH, N.J.
 WORK FURNISHED BY ELIZABETH, N.J.
 IN CHARGE OF J. H. MASONRY
 DRAWN BY C. A. J. DATE 7-5-40
 CHECKED BY C. A. J. DATE 8-9-40
 ORDER NO. 13804 SHEET NO. 51

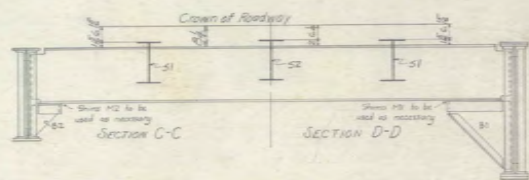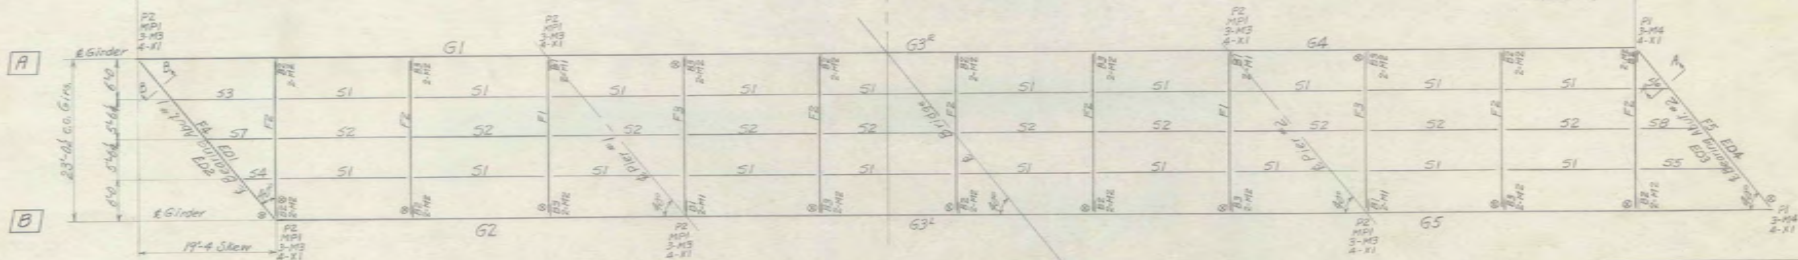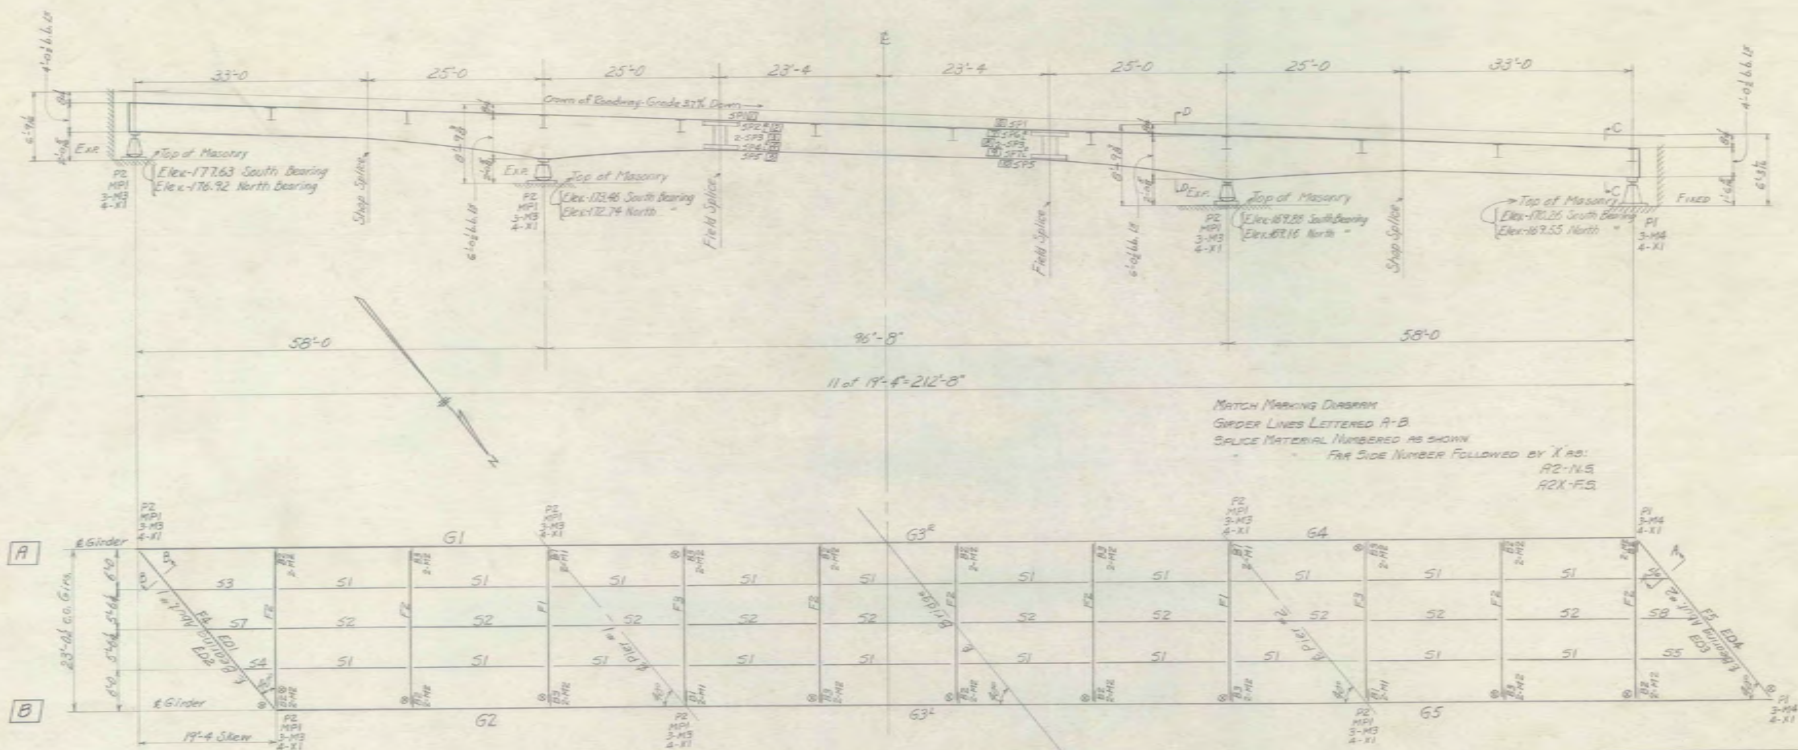

LIST OF SHEETS	
F1	Masonry Plan
F2	Erection Diagram
G1	Girders
G2	Floorbeams & Stringers
G3	End Dam
C1	Anchor Bolts
C2	Duck
C3	Turned Bolts
D1	Shoes
F1	Shoes
F2	Shoes
F3	Shoes
F4	Brackets


Note:
Field Connections Riveted

STATE OF VERMONT
SABIN BRIDGE
WESTMINSTER, VT.

ERECTION DIAGRAM

BRIDGE NO. 1000
DESIGNED BY ELMIRA
WORK FABRICATED BY ELMIRA
IN CHARGE OF MALONEY
DRAWN BY C.S.R. DATE 8-15-40
CHECKED BY G.W. DATE

ORDER NO. H3804
DRAWING NO. E2

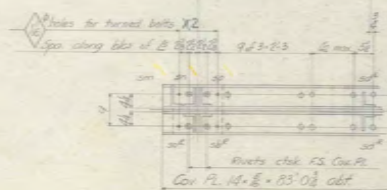

Re: 9/10/60 CWH
sent 3rd spl and ac
changed to
3rd 3rd sp and ac

STATE OF VERMONT
SABIN BRIDGE OVER SAXTON'S RIVER
WESTMINSTER VERMONT
GIRDEES

AMERICAN BRIDGE COMPANY

DRAWINGS MADE AT Elmora PLANT


WORK FURNISHED AT Elmora PLANT

IN CHARGE OF Maloney


QUAN. MADE BY R.M.H. DATE 7/1/10

QUAN. CHECKED BY T.J.K. DATE 7-4-10

ORDER No.	SHEET
H3804 ^A	1AF

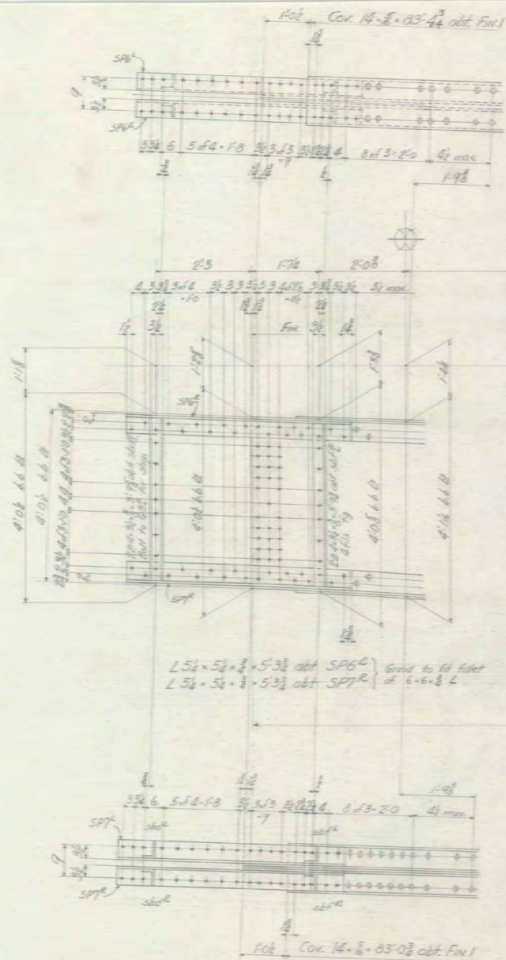


Cov. 14'-0" x 20'-3" obt.

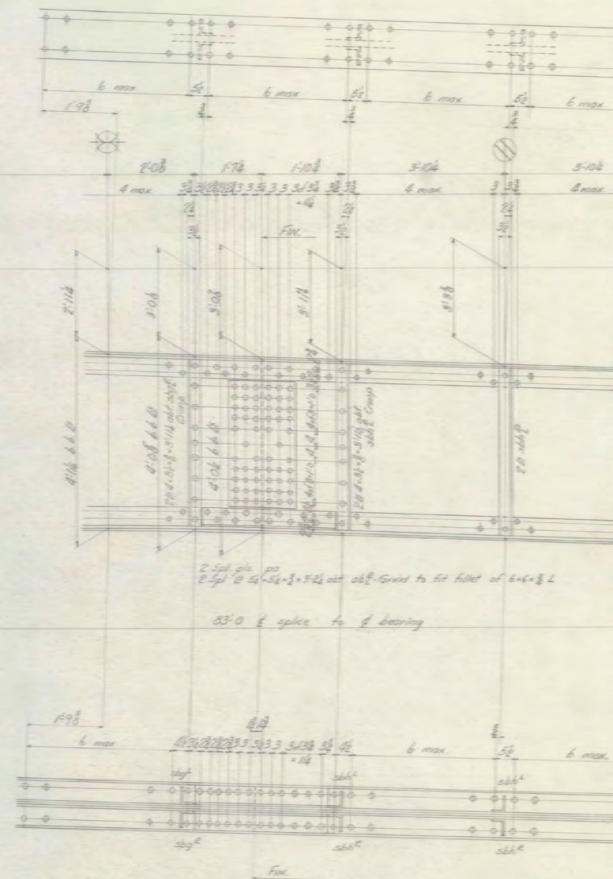

STATE OF VERMONT
SABIN BRIDGE OVER SEXTON'S RIVER
WESTMINSTER, VERMONT
GIRDERS


AMERICAN BRIDGE COMPANY
DRAWINGS MADE AT: BURLINGTON, VERMONT
WORK FABRICATED AT: BURLINGTON, VERMONT
IN CHARGE OF: R. H. H. H.
CHECKED BY: J. K. H. H.
ORDER NO. H3804H
SHEET NO. 1EF

Rev. 10/10/1914
Dimensions for parts not shown changed from 4'-0" to 4'-2"

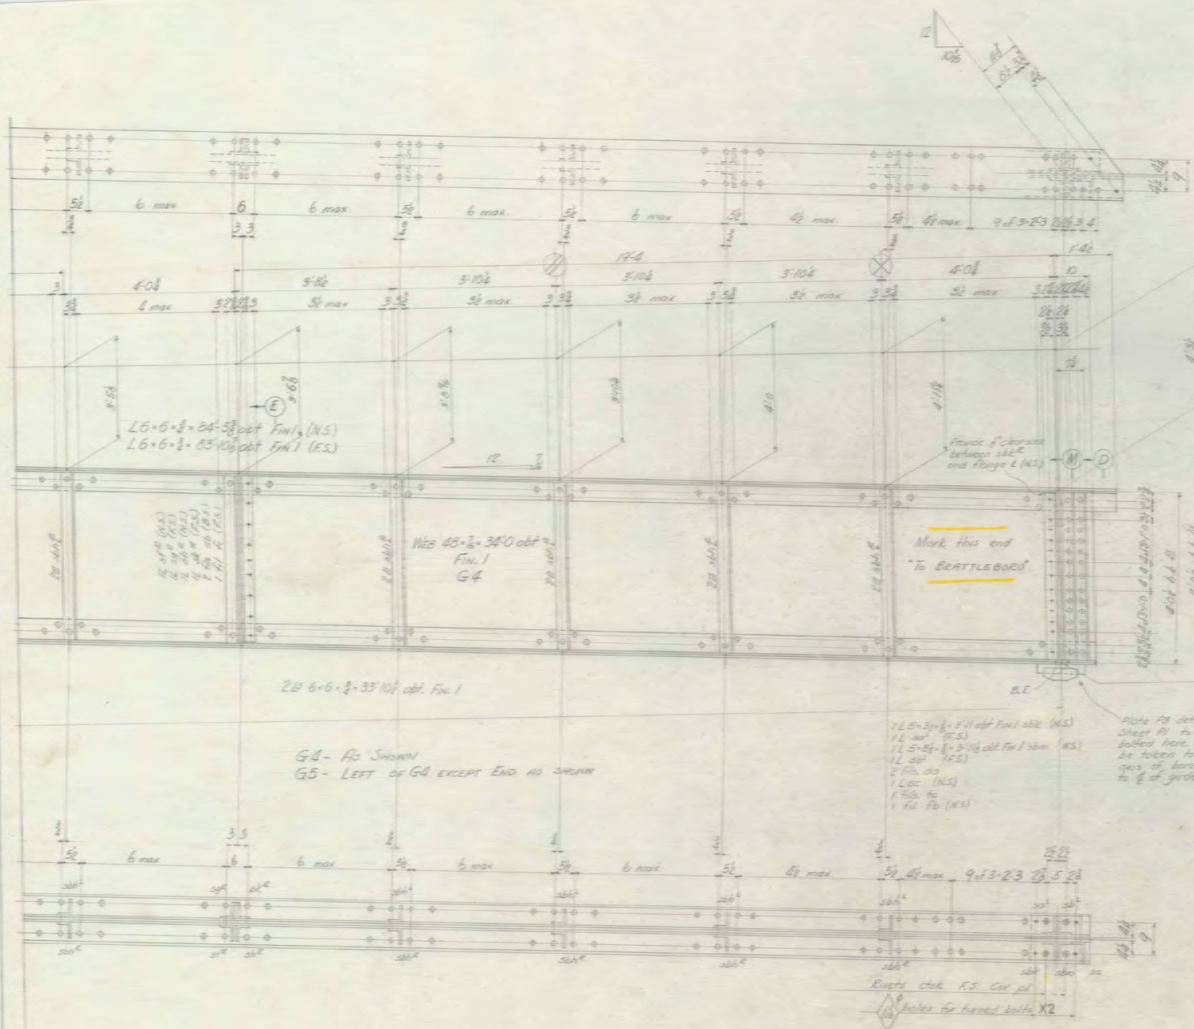

2L 6-6-3/4-33-10 1/2 det. Fin. 1

G4 - AS SHOWN
G5 - LEFT OF G4 EXCEPT END AS SHOWN

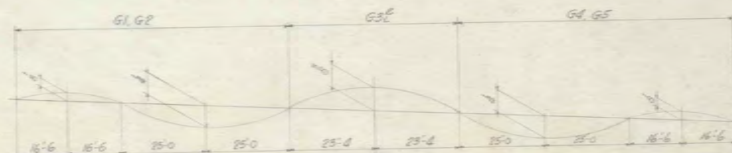


Camber Diagram

Dist. of top flange
width before
welding

Notes:
Beams 1
Holes 1/8" unless noted
B.E. indicates bearing end of stiffeners
Holes for field splices to be sub-punches 1/8" and
reamed to 1/4" while parts are temporarily
assembled and workmarked.
Paint - Yes
Surfaces riveted in contact in shop - No
Surfaces riveted in contact in field or in
contact with concrete - Yes

See "H460 EKH
Notes noted
To BEATTLEBROS"

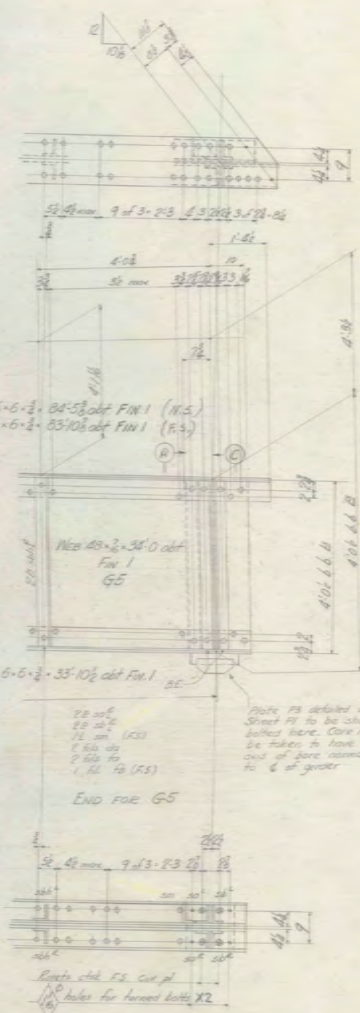

L6-6-3/4-84-53/8 det. Fin. 1 (NS)
L6-6-3/4-83-10 1/2 det. Fin. 1 (ES)

2L 6-6-3/4-33-10 1/2 det. Fin. 1

2L 6-6-3/4-33-10 1/2 det. Fin. 1
END FOR G5

STATE OF VERMONT
SABIN BRIDGE OVER SUTTON'S RIVER
WESTMINSTER, VERMONT
GIRDERS

REQUIRED	
1	GIRDER
1	G2
1	G3
1	G4
1	G5
4	SPACE PLATES
2	SP4
2	SP5
2	SP6
2	SP7
2	SP8
2	SP9
2	SP10
2	SP11
2	SP12
2	SP13
2	SP14
2	SP15
2	SP16
2	SP17
2	SP18

Mark this end
To BEATTLEBROS

AMERICAN BRIDGE COMPANY
DRAWINGS MADE AT: BOSTON
WORK FABRICATED AT: BOSTON
IN CHARGE OF: M. J. H.
DATE: 1914
CHECKED BY: T. J. K.
DATE: 1-1-15
ORDER NO.: H.3804
SHEET NO.: 1F

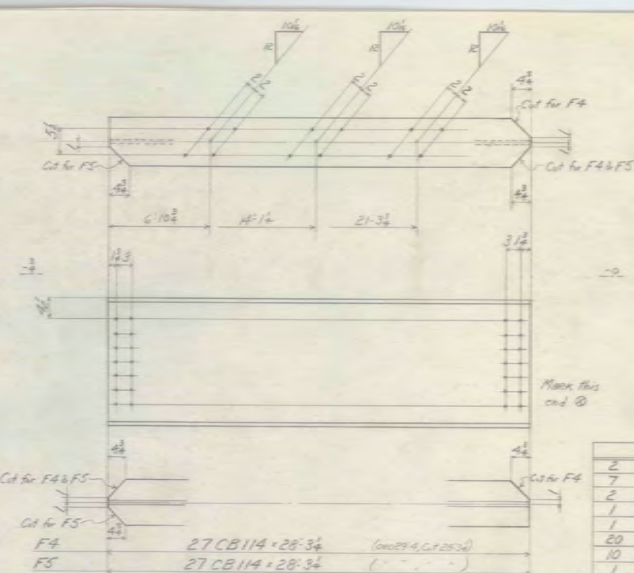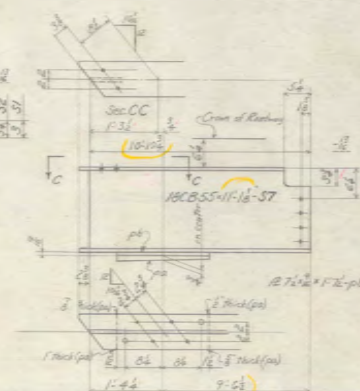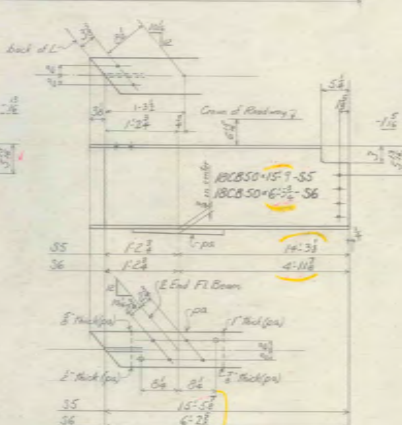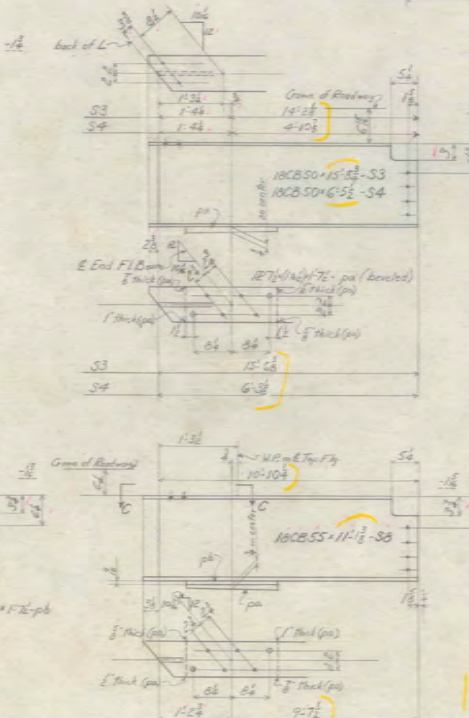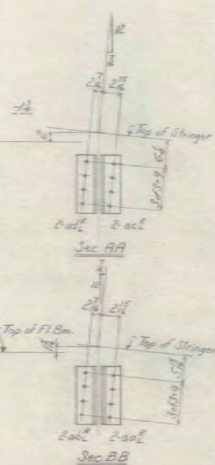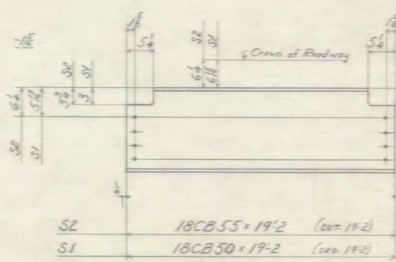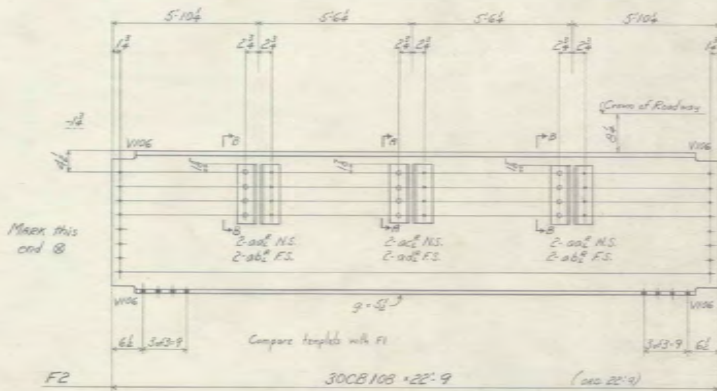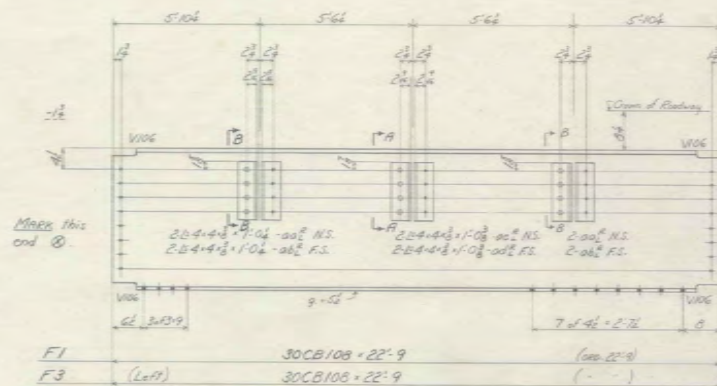

REQUIRED		
2	FLANGE BEAMS	F1
7	-	F2
2	-	F3
1	-	F4
1	-	F5
20	STRINGERS	S1
10	-	S2
1	-	S3
1	-	S4
1	-	S5
1	-	S6
1	-	S7
1	-	S8

NOTES:
 Rivets: 7"
 Holes: 18"
 MATERIAL over 8" thick to be drilled.
 Paint: Yes
 Surfaces rivets in contact in shop Yes
 Surfaces rivets in contact in field or in contact with concrete: Yes

Rev. 7-19-40
 Dimension 10-10 1/2 on
 S7 changed to 10-10 1/2

