

State of Vermont
Policy, Planning & Intermodal Development Division
Policy, Planning and Research Bureau
Development Review & Permitting Services Section

One National Life Drive
Montpelier, VT 05633-5001
vtrans.vermont.gov

[phone] 802-828-2653
[fax] 802-828-2456
[ttd] 800-253-0191

Agency of Transportation

May 13, 2015

Town Of Castleton
Mark Shea
P.O. Box 727, 1655 Main Street
Castleton, VT 05735

Subject: Castleton, VT30, L.S. 0080+25 ~ 0095+04 RT
(Permit Revision Letter #1)

Dear Mr. Shea:

Your request to extend the limits of construction along VT30 to L.S. 98+10 RT (+/- 300') for the construction of a new 8" sewer force main has been reviewed and approved. All work shall be in accordance with the attached plan dated May 7, 2015 and last revised May 12, 2015.

This permit revision letter becomes a part of the originally issued permit and should be attached to your copy.

The work must be completed under the **same conditions as set forth in the original permit #39229.**



Please feel free to contact Theresa Gilman at (802) 828-2473 if you have questions or comments

Sincerely,



Craig S. Keller, P.E.
Chief of Permitting Services
Permitting Services Section

cc: District Transportation Office #3
Belden Company
Rachel Marvin, Aldrich & Elliott

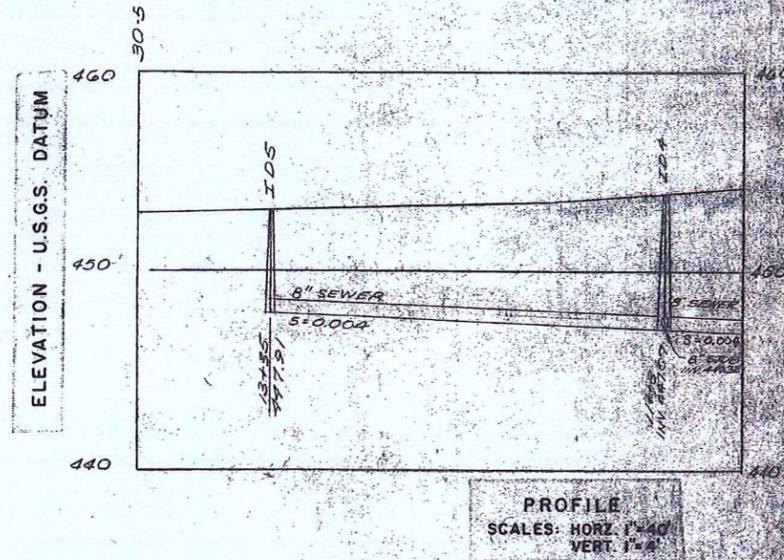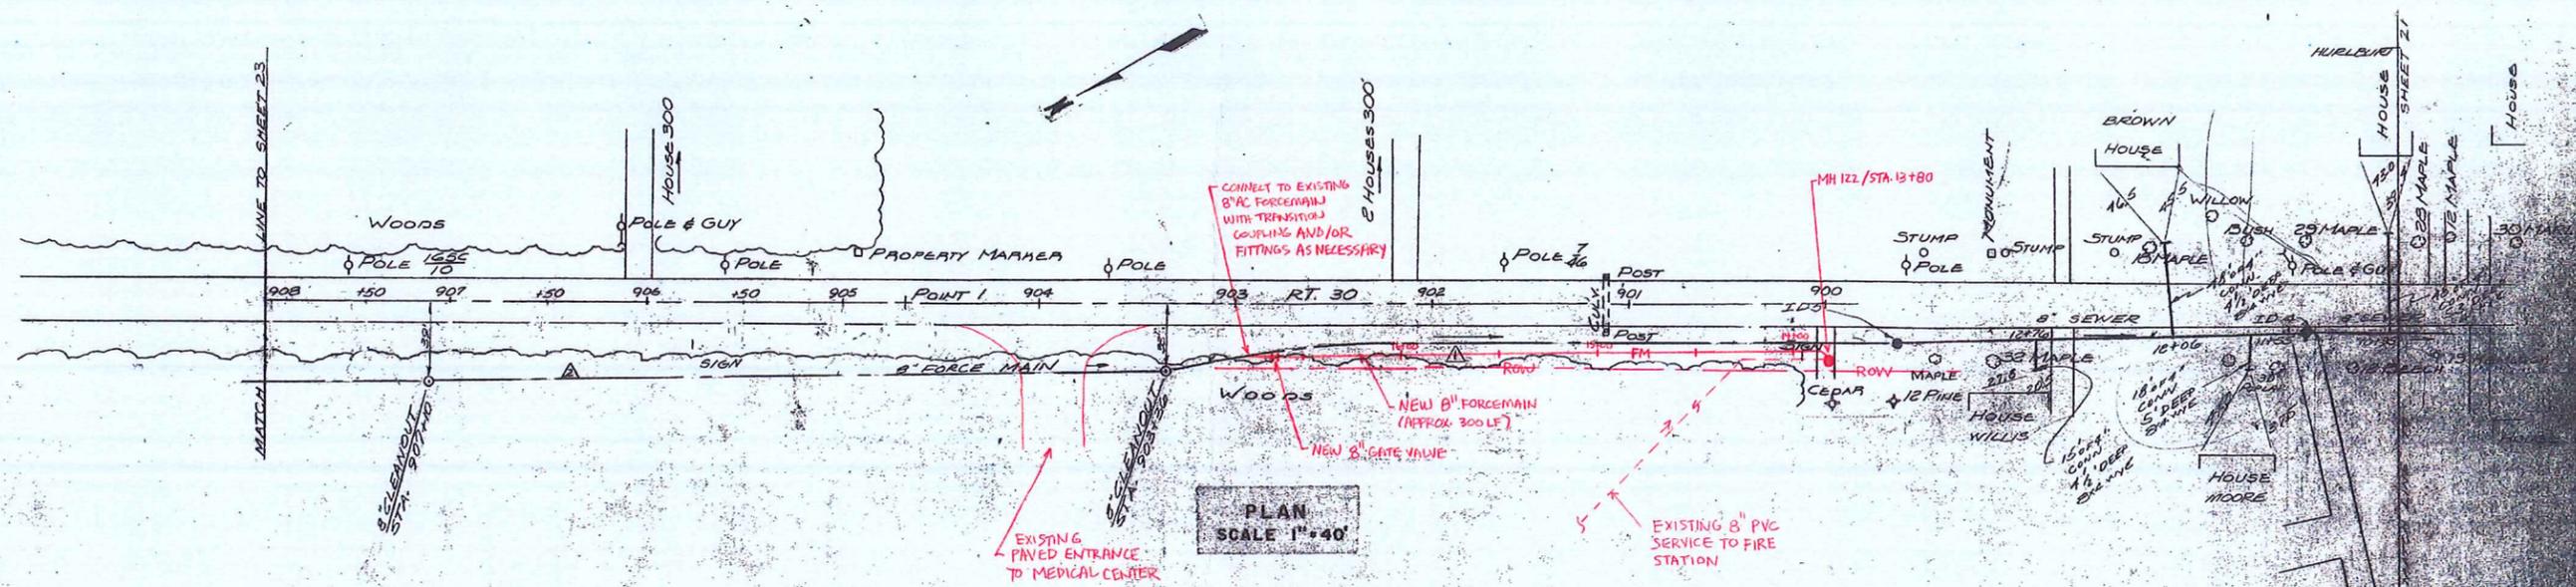

SKETCH OF PROPOSED FORCE MAIN REPLACEMENT NORTH TO MEDICAL CENTER

DRAWN BY R. MARVIN
ALDRICH + ELLIOTT, PC
5/7/15 (REVISED 5/12/15)

NOTE - SCALE DOES NOT APPLY WHEN DRAWING SIZE HAS BEEN CHANGED BY REPRODUCTION

NO.	DATE	REVISIONS	BY	CHECKED
1	AS BUILT			
2	REVISED 5/12/15			
3	REVISED 5/12/15			
4	REVISED 5/12/15			



D&K
DUBOIS & KING
ENGINEERS
RANDOLPH, VERMONT

TOWN OF CASTLETON, VERMONT
SANITARY SEWER SYSTEM
PLAN AND PROFILE

AS BUILT

DATE	5/12/15
SCALE	AS SHOWN
DATE	