

J . P . C A R R A R A & S O N S , I N C .
P R E C A S T / P R E S T R E S S E D C O N C R E T E P R O D U C T S

REQUEST FOR INFORMATION

TO:	Artie St. Onge	FROM:	Mike Davis / Mike Weigand
COMPANY:	A.L. St. Onge Contractor	DATE:	5/19/16
FAX NUMBER:	802-326-4005	TOTAL NO. OF PAGES INCLUDING COVER:	1 plus Attachment
PHONE NUMBER:	802-326-4792	SENDER'S REFERENCE NUMBER:	RFI #8
RE:	Waitsfield BRF 013-4(39) - Bridge No. 177; VT 100 over Mad River Waitsfield, VT		

URGENT FOR REVIEW PLEASE COMMENT PLEASE REPLY FOR YOUR USE


PLEASE PROVIDE AND/OR CLARIFY THE FOLLOWING:

**RFI #8: Abutment #2: Proposed Uniform Spacing of
Reinforcement in Back Wall Mark No. 'MD-BW4'**

J. P. Carrara & Sons, Inc. "JPC" proposes to modify the spacing of the 'MD-525S' projecting #5 bent bars and the 'MD-527S' corbel #5 bent bars from an uneven spacing as shown in the reinforcing plan view in form 1/BW4.1 in the approved-as-noted shop drawings to 12" +/- on center in the attached sketch. This change is in the interest of forming of the back wall. The overall quantity of each type of bar is unchanged, with a total of (15) 'MD-525S' required and a total of (14) 'MD-527S' required.

Please contact us at 802-388-6363 with any questions or to discuss.

5/19/16
 J. P. Carrara & Sons, Inc.
 Waitsfield BRF 013-4(39)
 Partial JPC Drawing BW4.1
 JPC RFI #8:
 Proposed Layout of #5 Bent
 Reinforcing Bars:
 '525S' & '527S'

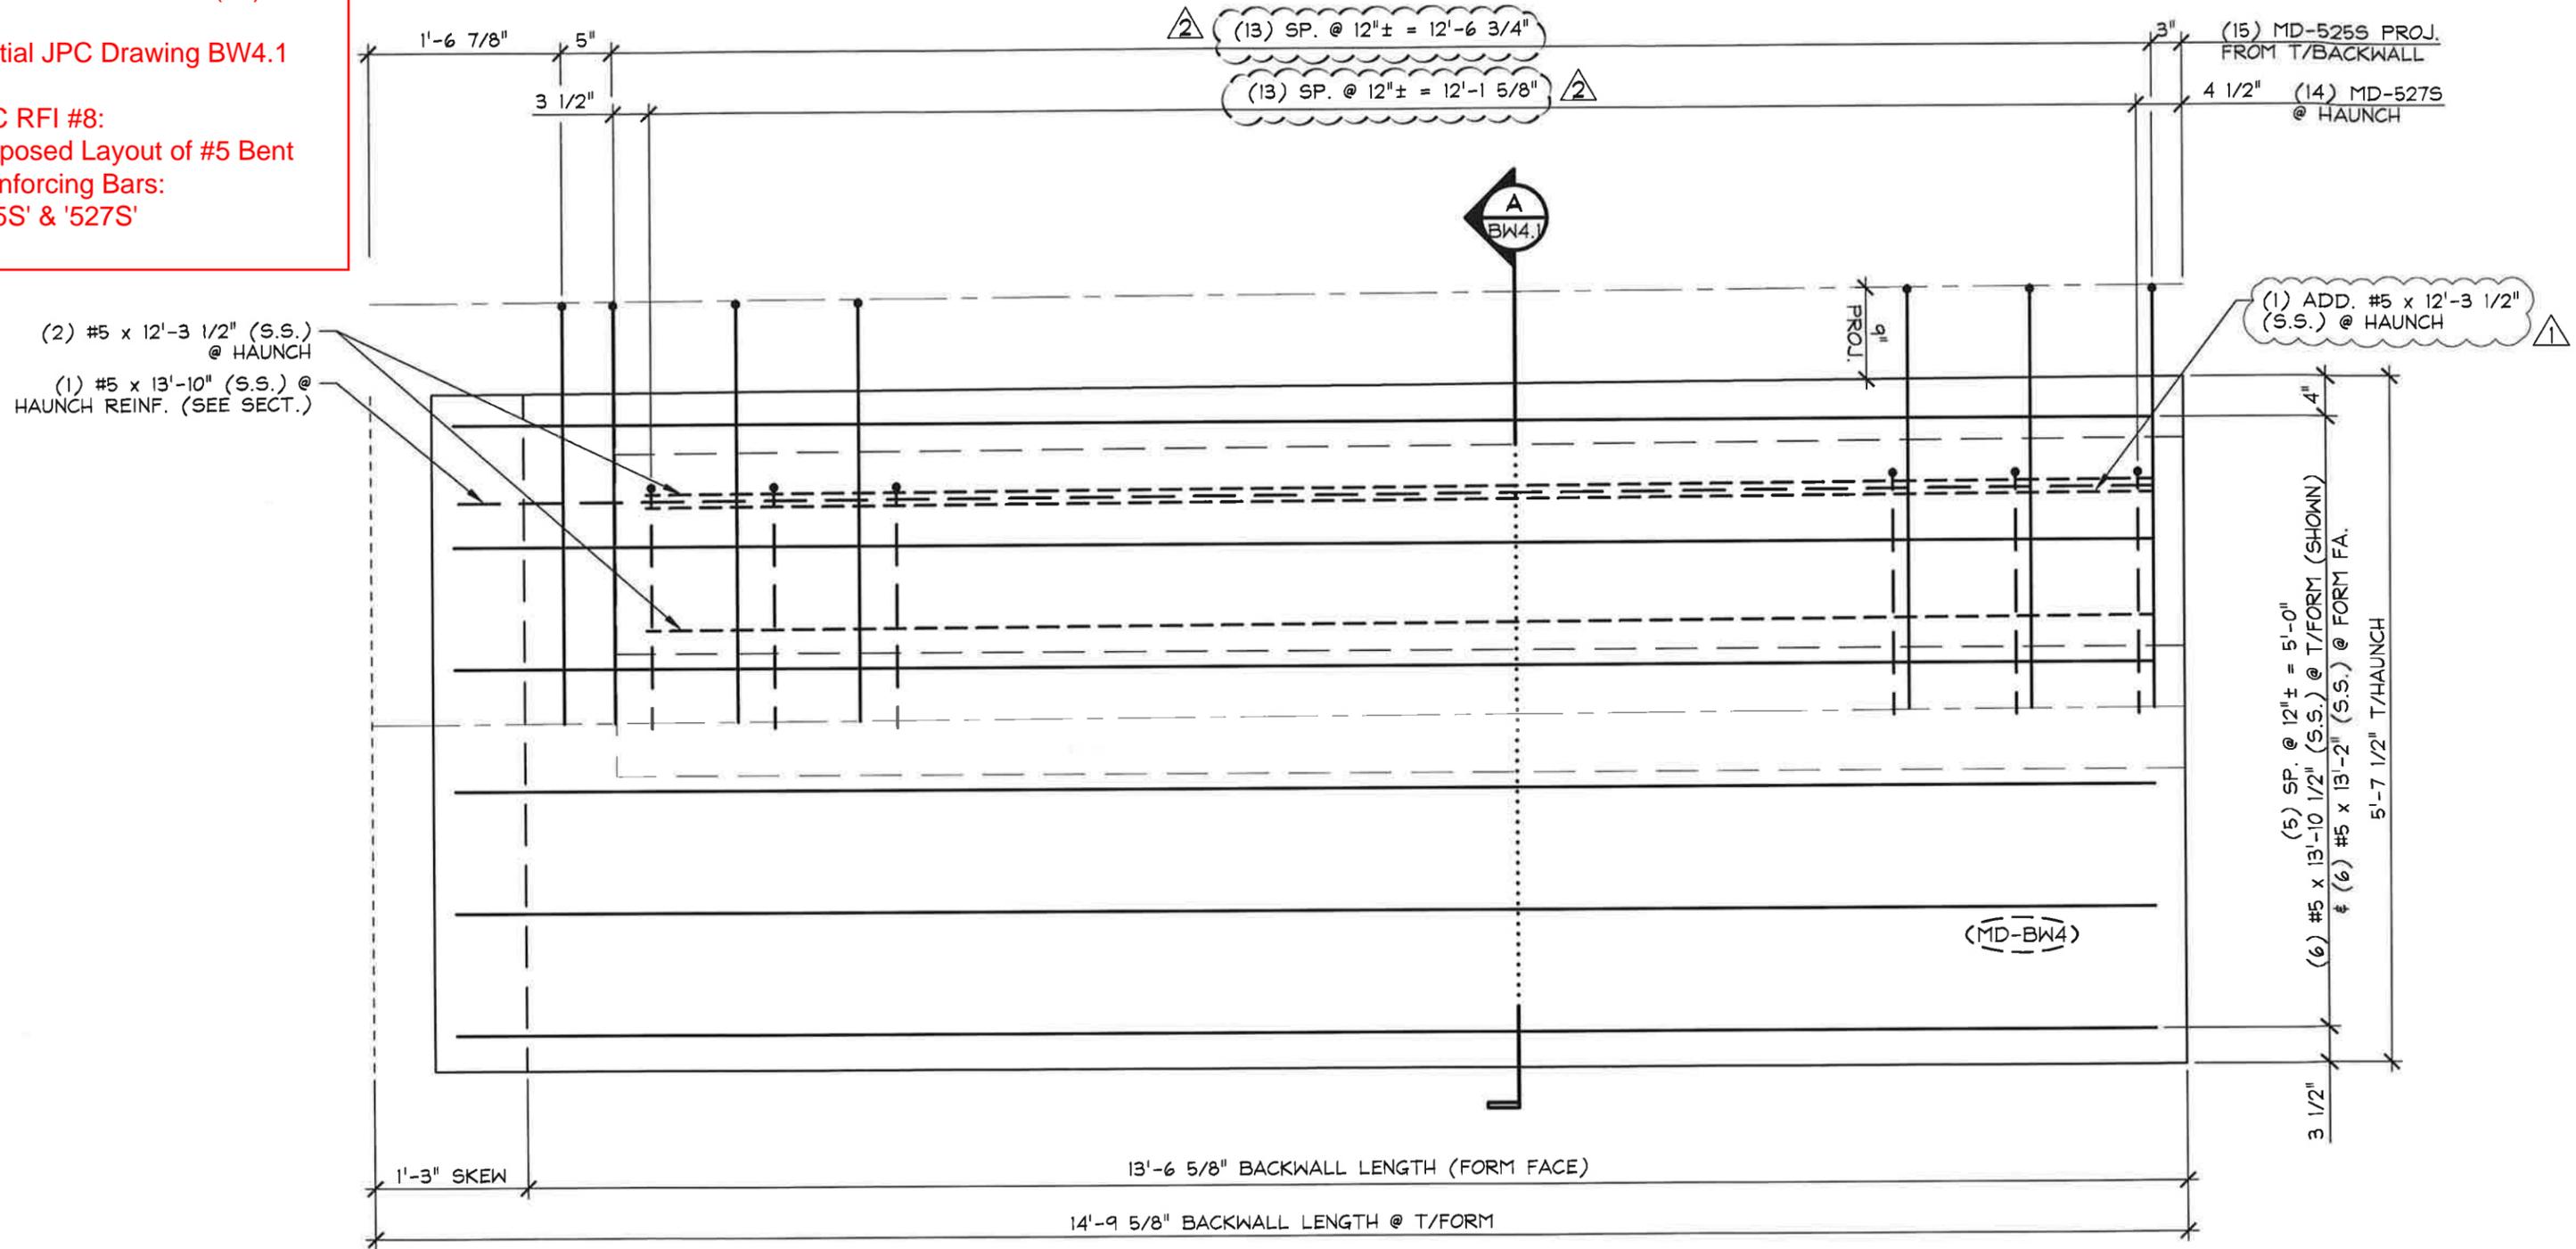

1 REINFORCING PLAN VIEW IN FORM
 BW4.1
 3/4" = 1'-0"

TOWN OF WAITSFIELD
 VT ROUTE 100 (MINOR ARTERIAL)
 BRIDGE NO.: 177 PROJECT NO.: BRF 013-4(39)
 JPC JOB #: 23480-016