



PLAN VIEW

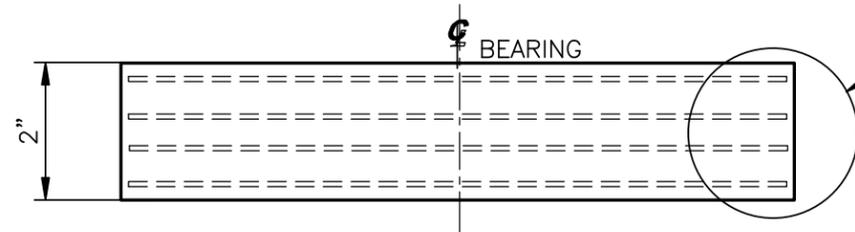

ELEVATION VIEW

LAMINATED ELASTOMERIC BEARING PADS
LEP1
 8 LOCATED AT ABUTMENT NO.1
 8 LOCATED AT ABUTMENT NO.2
 (16) TOTAL REQUIRED

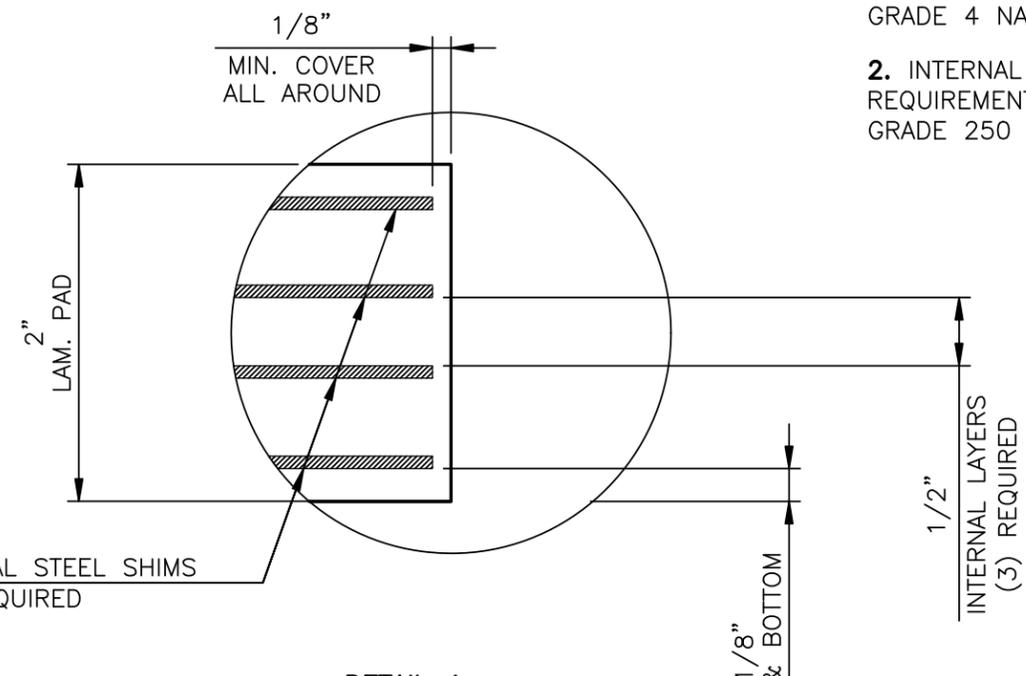

DETAIL 1

2" X 11 1/2" X 11 1/2"
 LAMINATED ELASTOMERIC BEARING PAD
 60 DUROMETER NATURAL RUBBER
 (16) REQUIRED

TEST PADS

2" X 11 1/2" X 11 1/2"
 LAMINATED ELASTOMERIC BEARING PAD
 60 DUROMETER NATURAL RUBBER
 (2) REQUIRED

14 GA (.0747") INTERNAL STEEL SHIMS
 (4) TOTAL REQUIRED


GENERAL NOTES:

1. ALL ELASTOMER SHALL BE 60 DUROMEEER GRADE 4 NATURAL RUBBER.
2. INTERNAL SHIMS SHALL CONFORM TO THE REQUIREMENTS OF AASHTO M 270M/M 270, GRADE 250 (ASTM A1011, GRADE 40).

Vermont Agency of Transportation
RECEIVED
 ON: **January 20, 2016**
 and Checked for
CONFORMANCE
 BY: **Jennifer Fitch** DATE: **02/04/2016**

SHOP DRAWING REVIEW	
<input type="checkbox"/> REVIEWED AS REQUIRED BY THE CONSTRUCTION CONTRACT DOCUMENTS AND APPROVED, BUT ONLY FOR CONFORMANCE TO THE DESIGN CONCEPT OF THE WORK, AND SUBJECT TO FURTHER LIMITATIONS AND REQUIREMENTS CONTAINED IN THE CONSTRUCTION CONTRACT DOCUMENTS.	<input type="checkbox"/> FURNISH AS CORRECTED
<input type="checkbox"/> REJECTED	<input checked="" type="checkbox"/> REVISE AND RESUBMIT
CORRECTIONS OR COMMENTS MADE ON THE SHOP DRAWINGS DURING THIS REVIEW DO NOT RELIEVE CONTRACTOR FROM COMPLIANCE WITH REQUIREMENTS OF THE DRAWINGS AND SPECIFICATIONS. THIS CHECK IS ONLY FOR REVIEW OF GENERAL CONFORMANCE WITH THE DESIGN CONCEPT OF THE PROJECT AND GENERAL COMPLIANCE WITH THE INFORMATION GIVEN IN THE CONTRACT DOCUMENTS. THE CONTRACTOR IS RESPONSIBLE FOR: CONFIRMING AND CORRELATING ALL QUANTITIES AND DIMENSIONS; SELECTING FABRICATION PROCESSES AND TECHNIQUES OF CONSTRUCTION; COORDINATING HIS WORK WITH THAT OF ALL OTHER TRADES; AND PERFORMING HIS WORK IN A SAFE AND SATISFACTORY MANNER.	
40 IDX Drive Building 100, Suite 200 South Burlington, VT 05403 802.497.6100	Job Number: BF 013-2(13) Reviewed By: E.F. LAWES Date: 02-02-2016

PLEASE PROVIDE TOLERANCES AND INFORMATION FOR GALVANIZED STEEL SHIMS PER CONTRACT PLANS SHEET 50 OF 68, NOTE #6.

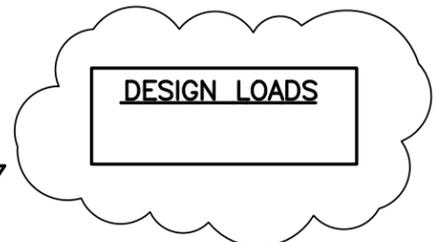

APPOVER NOTE:
 PLEASE PROVIDE DESIGN LOAD.

SEE CONTRACT PLANS SHEET 7 OF 68, NOTE #40 FOR DESIGN LOADS.

STATE OF VERMONT
 AGENCY OF TRANSPORTATION
 TOWN OF WESTON
 VT ROUTE 100
 (RURAL MINOR ARTERIAL), BRIDGE #98

STATE	COUNTY	CONTROL NO.
VT.	WINDSOR	N/A

PROJ. ID NO.: BF 013-2(13)

DYNAMIC RUBBER
LAM. ELASTOMERIC BEARING ASS'YS

1501 ROCKY RIDGE ROAD
 P.O. BOX 2159
 ATHENS, TEXAS 75751

SCALE: NONE	DRAWN BY: FM	CHECKED BY: KP
	DATE: 1/4/16	DATE: 1/5/16

SHEET 1 OF 1 **JOB NO.: 13316**

REV.	DESCRIPTION	BY	DATE	CK'D	DATE	CUSTOMER	DRAWING NUMBER	REV.
						THE BELDEN COMPANY	13316-D1	0