

APPROVED: Approval of drawings and/or procedures indicates concurrence with the information presented and does not relieve the Contractor or Fabricator of compliance with all specifications and code requirements

X



APPROVED AS NOTED

REVISE AND RESUBMIT

NOT REVIEWED

Date: 4/13/15

By: George Bogue

This review by Stantec Consulting Services Inc. is for the sole purpose of ascertaining conformance with the general design concept. This review shall not mean that Stantec Consulting Services Inc approves the detail design inherent in the shop drawings, responsibility for which shall remain with the Contractor. Submitting same, and such review shall not relieve the Contractor of his responsibility for errors or omissions in the shop drawing or of his responsibility for meeting all requirements of the Contract Documents. The contractor is responsible for dimensions to be confirmed and correlated at the job site, for information that pertains solely to the fabrication processes or to techniques of construction and installation and for coordination of the work of all subtrades.

B.I.N. BR46N
WEST SIDE RAILING ELEVATION
LOOKING AT FACE OF RAIL, FACING WEST, FROM CENTERLINE OF ROAD

~~These rails are on a horizontal curve. Please provide the radius of the bend for the rails. Comment applies to both bridges, 46N and 46S~~

REVIEWED
By Jeff Clark (jeff.clark@state.vt.us) at 8:12 am, Mar 31, 2015


Vermont Agency of Transportation

RECEIVED
ON: **March 27, 2015**
and Checked for
CONFORMANCE

BY: D Bonneau DATE: 04/13/15

No.	Initial	Remarks	Date
0	Initial submittal		3/24/15
REVISIONS - APPLIES TO SET			

HIGHWAY SAFETY CORP	
GLASTONBURY, CT 860-633-9445	
ITEM 525.33 2-RAIL BRIDGERAIL GALVANIZED BRIDGE REHABILITATION I-89 OVER STOWE ST. & THATCHER BROOK B.I.N. BR46N/BR46S P.I.N. IM 089-2(43) TOWN OF WATERBURY, WASHINGTON COUNTY	
CERTIFIED FABRICATOR	2033
1 of 7	
CONTRACTOR LAFAYETTE	DATE 03-20-15

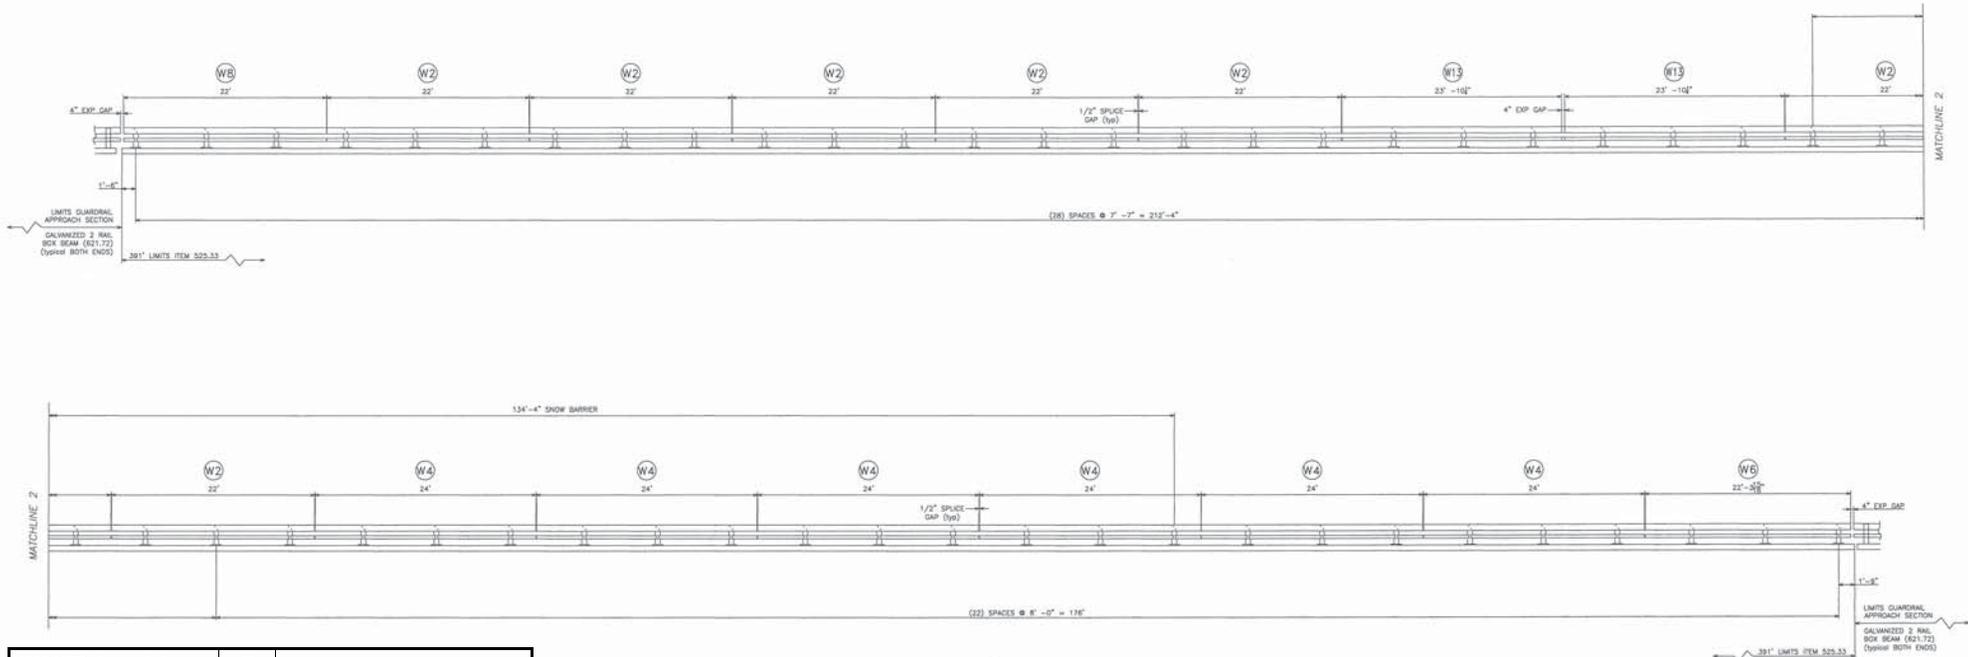


APPROVED: Approval of drawings and/or procedures indicates concurrence with the information presented and does not relieve the Contractor or Fabricator of compliance with all specifications and code requirements	X	
APPROVED AS NOTED		
REVISE AND RESUBMIT		
NOT REVIEWED		
Date: 4/13/15		
By: George Bogue		
<p>This review by Stantec Consulting Services Inc. is for the sole purpose of ascertaining conformance with the general design concept. This review shall not mean that Stantec Consulting Services Inc approves the detail design inherent in the shop drawings, responsibility for which shall remain with the Contractor. Submitting same, and such review shall not relieve the Contractor of his responsibility for errors or omissions in the shop drawing or of his responsibility for meeting all requirements of the Contract Documents. The contractor is responsible for dimensions to be confirmed and correlated at the job site, for information that pertains solely to the fabrication processes or to techniques of construction and installation and for coordination of the work of all subtrades.</p>		

B.I.N. BR46N
 EAST SIDE RAILING ELEVATION
 LOOKING AT FACE OF RAIL, FACING EAST, FROM CENTERLINE OF ROAD

REVIEWED
 By Jeff Clark (jeff.clark@state.vt.us) at 8:12 am, Mar 31, 2015

Vermont Agency of Transportation
RECEIVED
 ON: **March 27, 2015**
 and Checked for
CONFORMANCE
 BY: D Bonneau DATE: 04/13/15

 HIGHWAY SAFETY CORP GLASTONBURY, CT 860-633-9445		CERTIFIED FABRICATOR
ITEM 525.33 2-RAIL BRIDGERAIL GALVANIZED BRIDGE REHABILITATION I-89 OVER STOWE ST. & THATCHER BROOK B.I.N. BR46N/BR46S P.I.N. 1M 089-2(43) TOWN OF WATERBURY, WASHINGTON COUNTY		
GENERAL CONTRACTOR LAFAYETTE		DOC. JOB NO. 2033
DRAWN MKT CHECKED DATE 03-20-15 SCALE NONE SIZE D		SHEET NO. 2 of 7

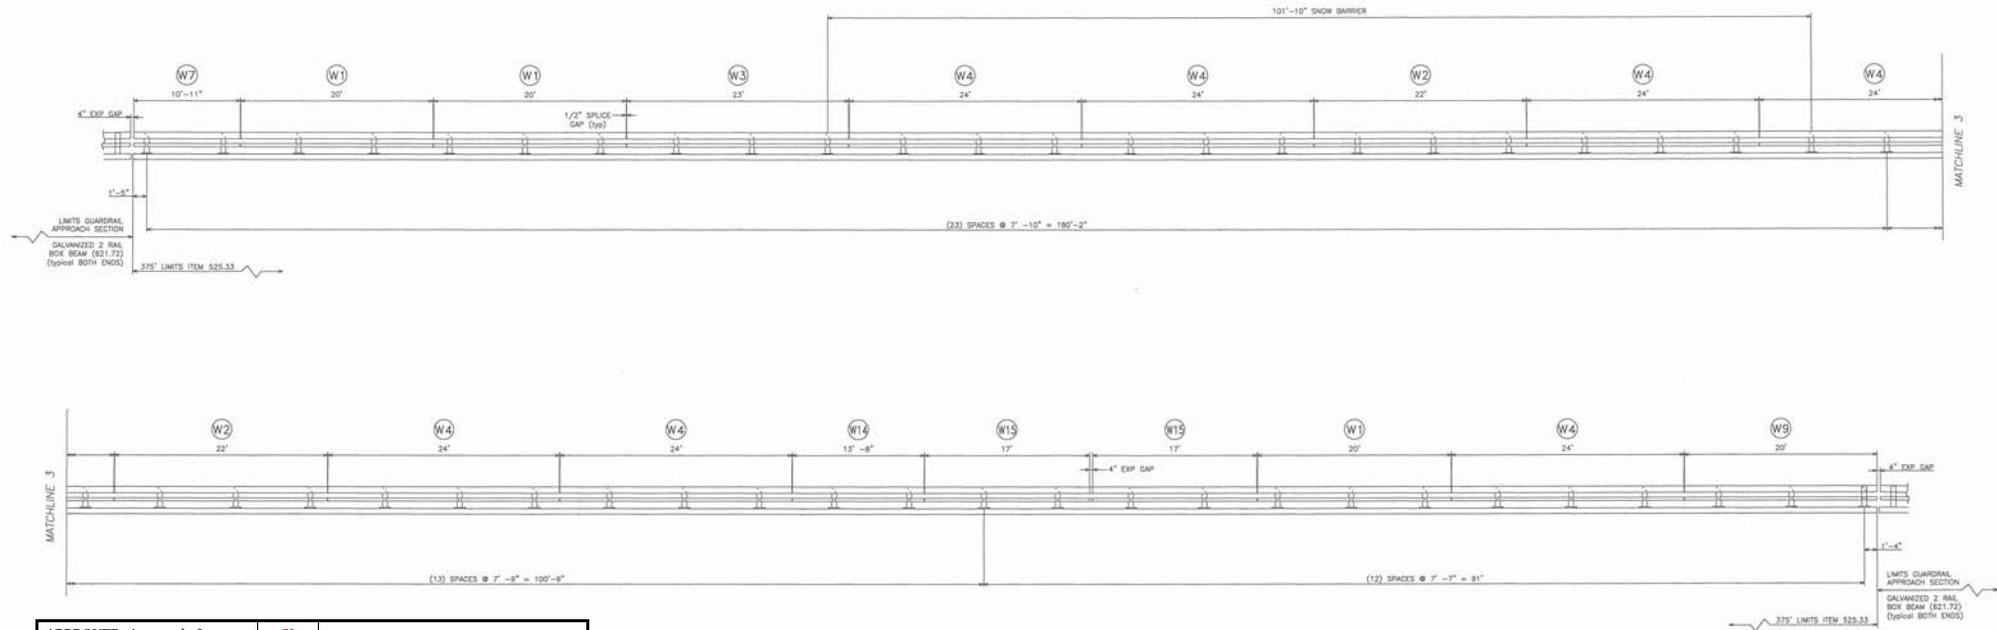

APPROVED: Approval of drawings and/or procedures indicates concurrence with the information presented and does not relieve the Contractor or Fabricator of compliance with all specifications and code requirements

X



APPROVED AS NOTED
REVISE AND RESUBMIT
NOT REVIEWED

Date: 4/13/15

By: George Bogue

This review by Stantec Consulting Services Inc. is for the sole purpose of ascertaining conformance with the general design concept. This review shall not mean that Stantec Consulting Services Inc approves the detail design inherent in the shop drawings, responsibility for which shall remain with the Contractor. Submitting same, and such review shall not relieve the Contractor of his responsibility for errors or omissions in the shop drawing or of his responsibility for meeting all requirements of the Contract Documents. The contractor is responsible for dimensions to be confirmed and correlated at the job site, for information that pertains solely to the fabrication processes or to techniques of construction and installation and for coordination of the work of all subtrades.

Vermont Agency of Transportation

RECEIVED
ON: **March 27, 2015**
and Checked for
CONFORMANCE

BY: D Bonneau DATE: 04/13/15


B.I.N. BR46S
WEST SIDE RAILING ELEVATION

LOOKING AT FACE OF RAIL, FACING WEST, FROM CENTERLINE OF ROAD

REVIEWED

By Jeff Clark (jeff.clark@state.vt.us) at 8:12 am, Mar 31, 2015

HIGHWAY SAFETY CORP	
GLASTONBURY, CT 860-633-9445	
ITEM 525.33 2-RAIL BRIDGERAIL GALVANIZED BRIDGE REHABILITATION I-89 OVER STOWE ST. & THATCHER BROOK B.I.N. BR46N/BR46S P.I.N. IM 089-2(43) TOWN OF WATERBURY, WASHINGTON COUNTY	
GENERAL CONTRACTOR	CERTIFIED FABRICATOR
JOB NO. 2033	SHEET NO. 3 of 7
CONTRACTOR LAFAYETTE	DATE 03-20-15
DRAWN MKT	CHECKED NONE
SCALE NONE	SIZE D

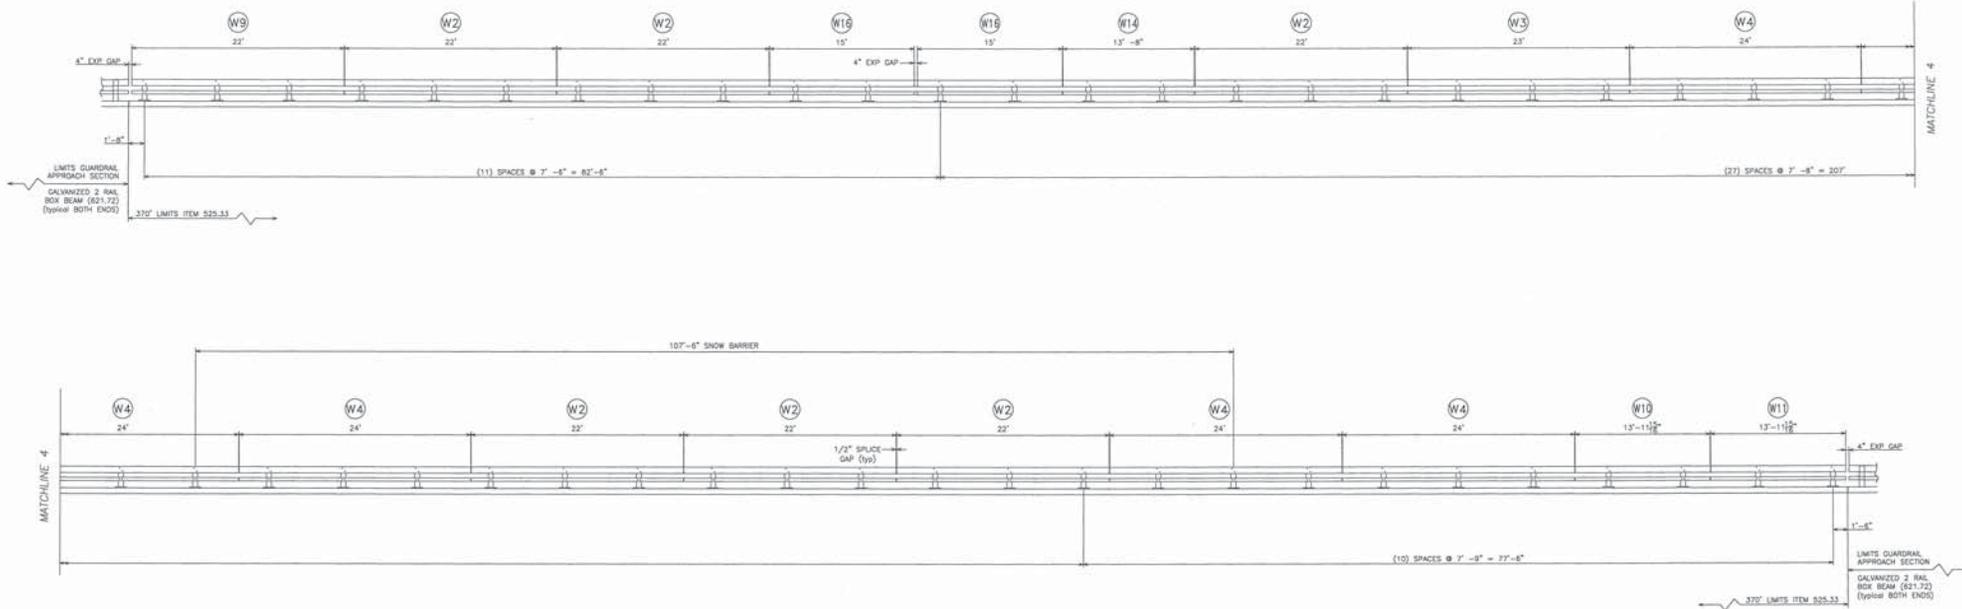

APPROVED: Approval of drawings and/or procedures indicates concurrence with the information presented and does not relieve the Contractor or Fabricator of compliance with all specifications and code requirements	X	
APPROVED AS NOTED		
REVISE AND RESUBMIT		
NOT REVIEWED		
Date: 4/13/15		
By: George Bogue		
<p>This review by Stantec Consulting Services Inc. is for the sole purpose of ascertaining conformance with the general design concept. This review shall not mean that Stantec Consulting Services Inc approves the detail design inherent in the shop drawings, responsibility for which shall remain with the Contractor. Submitting same, and such review shall not relieve the Contractor of his responsibility for errors or omissions in the shop drawing or of his responsibility for meeting all requirements of the Contract Documents. The contractor is responsible for dimensions to be confirmed and correlated at the job site, for information that pertains solely to the fabrication processes or to techniques of construction and installation and for coordination of the work of all subtrades.</p>		

B.I.N. BR46S
 EAST SIDE RAILING ELEVATION
 LOOKING AT FACE OF RAIL, FACING EAST, FROM CENTERLINE OF ROAD

Vermont Agency of Transportation
RECEIVED
 ON: **March 27, 2015**
 and Checked for
CONFIRMANCE
 BY: **D Bonneau** DATE: **04/13/15**

REVIEWED
 By Jeff Clark (jeff.clark@state.vt.us) at 8:12 am, Mar 31, 2015

 HIGHWAY SAFETY CORP GLASTONBURY, CT 860-633-9445	
ITEM 525.33 2-RAIL BRIDGERAIL GALVANIZED BRIDGE REHABILITATION I-89 OVER STOWE ST. & THATCHER BROOK B.I.N. BR46N/BR46S P.I.N. IM 089-2(43) TOWN OF WATERBURY, WASHINGTON COUNTY	
GENERAL CONTRACTOR LAFAYETTE	REG. JOB NO. 2033
DRAWN MKT CHECKED DATE 03-20-15 SCALE NONE BOX D	SHEET NO. 4 of 7
	

