

Stantec Consulting Services Inc.

55 Green Mountain Drive
South Burlington VT 05403
Tel: (802) 864-0223
Fax: (802) 864-0165

To:	Douglas E. Bonneau, P.E.	From:	Thomas Knight
Company:	VTrans	<input type="checkbox"/>	For Your Information
Address:	Douglas.Bonneau@state.vt.us	<input type="checkbox"/>	For Your Approval
Phone:	(802) 828-3874	<input type="checkbox"/>	For Your Review
Date:	February 18, 2015	<input checked="" type="checkbox"/>	As Requested
File:	Waterbury IM 089-2(43) - 195310438		
Delivery:	Electronic		

Reference: Bridge 46 South – hardware for replacement radius bearing

Attachment:

Copies	Doc Date	Pages	Description
1	12/23/2014	1	ANCHOR ROAD ABUTMENT 2 BRIDGE 46 S

Status:

- 46 S bearing hardware – **APPROVED – No Exception Taken**


STANTEC CONSULTING SERVICES INC.

Tom Knight
Sr. Structural Engineer
Phone: (802) 497-6409
Fax: 802-864-0165
tom.knight@stantec.com

MK	QTY	DESCRIPTION	MATERIAL	LENGTH	REMARKS	WT*	REV
2A	2	SWEDGED ROD					7
2ar1	2	Ø1.250" X 19.500" SWEDGED ROD	F1554 GR 36		4.000" THRD, 11.000" SWEDGED; A153-HDG		7
2B	2	HEX NUT					< 1
2hn1	2	Ø1.250" HEX NUT	A563-DH OR A194-2H HEAVY HEX		A153-HDG, DRY LUBE & DYE		< 1
2C	2	WASHER PLATE					1
2wp1	2	0.375" X 4.000"	A36	2.500"	Ø1.313" HOLE CTR; A123-HDG		1
					*Approx. Gross Wt. Lbs Per Single Unit		12/22/14 12:13:33 PM

No exception.

PLEASE VERIFY MATERIAL

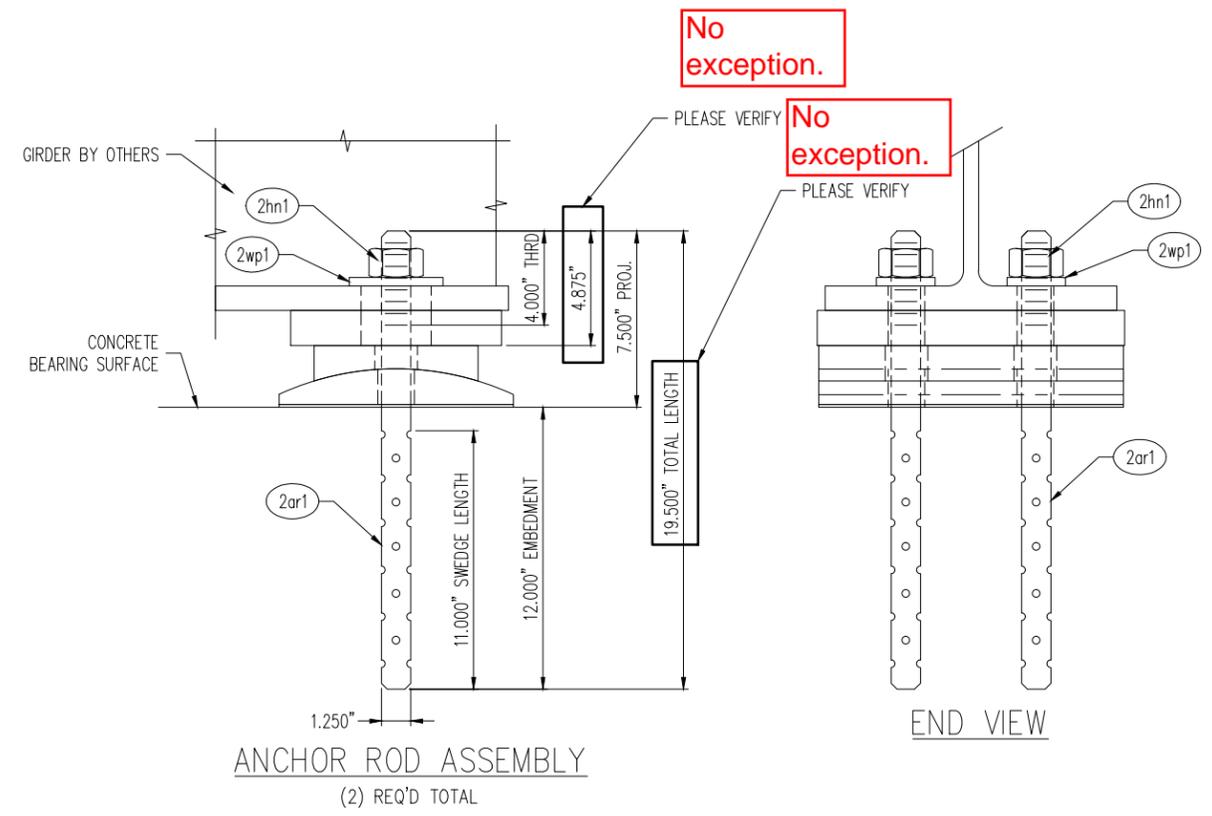

No exception.

No exception.

APPROVED: Approval of drawings and/or procedures indicates concurrence with the information presented and does not relieve the Contractor or Fabricator of compliance with all specifications and code requirements	X	
APPROVED AS NOTED		
REVISE AND RESUBMIT		
NOT REVIEWED		
Date: 2/18/2015		
By: <i>John E. Kirsch</i>		
<small>This review by Stantec Consulting Services Inc. is for the sole purpose of ascertaining conformance with the general design concept. This review shall not mean that Stantec Consulting Services Inc approves the detail design inherent in the shop drawings, responsibility for which shall remain with the Contractor. Submitting same, and such review shall not relieve the Contractor of his responsibility for errors or omissions in the shop drawing or of his responsibility for meeting all requirements of the Contract Documents. The contractor is responsible for dimensions to be confirmed and correlated at the job site, for information that pertains solely to the fabrication processes or to techniques of construction and installation and for coordination of the work of all subcontractors.</small>		

Vermont Agency of Transportation
RECEIVED
CK'D BY D Bonneau OK'D BY D Bonneau
February 17, 2015
RESUBMIT No Approved
BY D Bonneau DATE 02/19/15

DS BROWN PROJECT NO.: 44996-1121

Seismic Energy Products, Inc.
STRUCTURAL BEARINGS FOR BRIDGES & BUILDINGS
ATHENS, TX PHONE: 903-675-8571

BEARING ASSY FOR:
VERMONT AGENCY OF TRANSPORTATION

ANCHOR ROD ABUT. 2 BRIDGE 46 SB

CONTRACTOR:

FEDERAL NO.:	DRAWN: SP	DATE: 12-23-14	PO #: PO-29252
STATE NO.: IM 089-2(43)	CHECKED: -	DATE	SO NO. & ST. 60383A VT
COUNTY:	REVIEWED	DATE	SHEET - OF 2

REV.	DESCRIPTION	DATE
REVISIONS		