



SITE DEVELOPMENT, EXCAVATION, DEMOLITION
WATER AND SEWER SYSTEMS
AGGREGATE OPERATIONS

**Solid Waste Management
Landfill Sitework and Closures**
8 U.S. ROUTE 4 EAST, MENDON, VERMONT 05701 802/773-0052
FAX 802/747-7992

Submittal

To: State of Vermont Agency of Transportation
Southwest Regional Construction Office
61 Valley View
Mendon, VT 05701

Date: February 12, 2015
Project: Shrewsbury STP 1443 (44)

Contract: Shrewsbury STP 1443 (44)

Attention: Tim Pockette (RE), Bill Farley (Asst CEE)

From: Jacob Robinson

Copies	CCI Submittal Number	Specification Section	Description
Electronic	5	900.645	Special Provision Traffic Control Plan

Contractors Review and Comments

Reviewed By: Jacob Robinson/Jeff Chase

Comments: The attached Traffic Control Plan was prepared by Jacob Robinson of Casella Construction. The intention of this plan is to adhere to MUTCD and VAOT standards.

Engineers Review Stamp and Comments

Vermont Agency of Transportation

RECEIVED

Submittal 5 Traffic Control Plan, Approved as Noted 3.4.15.pdf

CK'D BY FDB OK'D BY CLB

February 27, 2015

RESUBMIT YES **Rejected**
BY C. CARSLON DATE 03/05/15

Plans need to be stamped by a Professional Engineer.

Note: Drawing is required per special provisions 900.645 (Traffic Control, All Inclusive)

Vermont Agency of Transportation

RECEIVED

Submitted 6 Traffic Control Plan, Approved as Noted 3.4.15.pdf

CK'D BY FDB

OK'D BY CLB

February 27, 2015

RESUBMIT YES

Rejected

BY C. CARSLON

DATE 03/05/15


Plans need to be stamped by a Professional Engineer.

Make sure access to this house and drive is maintained.

Please make sure sign is actually diamond shaped like the other bridge closed signs.

Please note these are VC869 signs per VTrans standard T-1 and T-28. Sheet 15 on the contract plans has a typo saying VC839.

Please note these are VC869 signs per VTrans standard T-1 and T-28. Sheet 15 on the contract plans has a typo saying VC839.

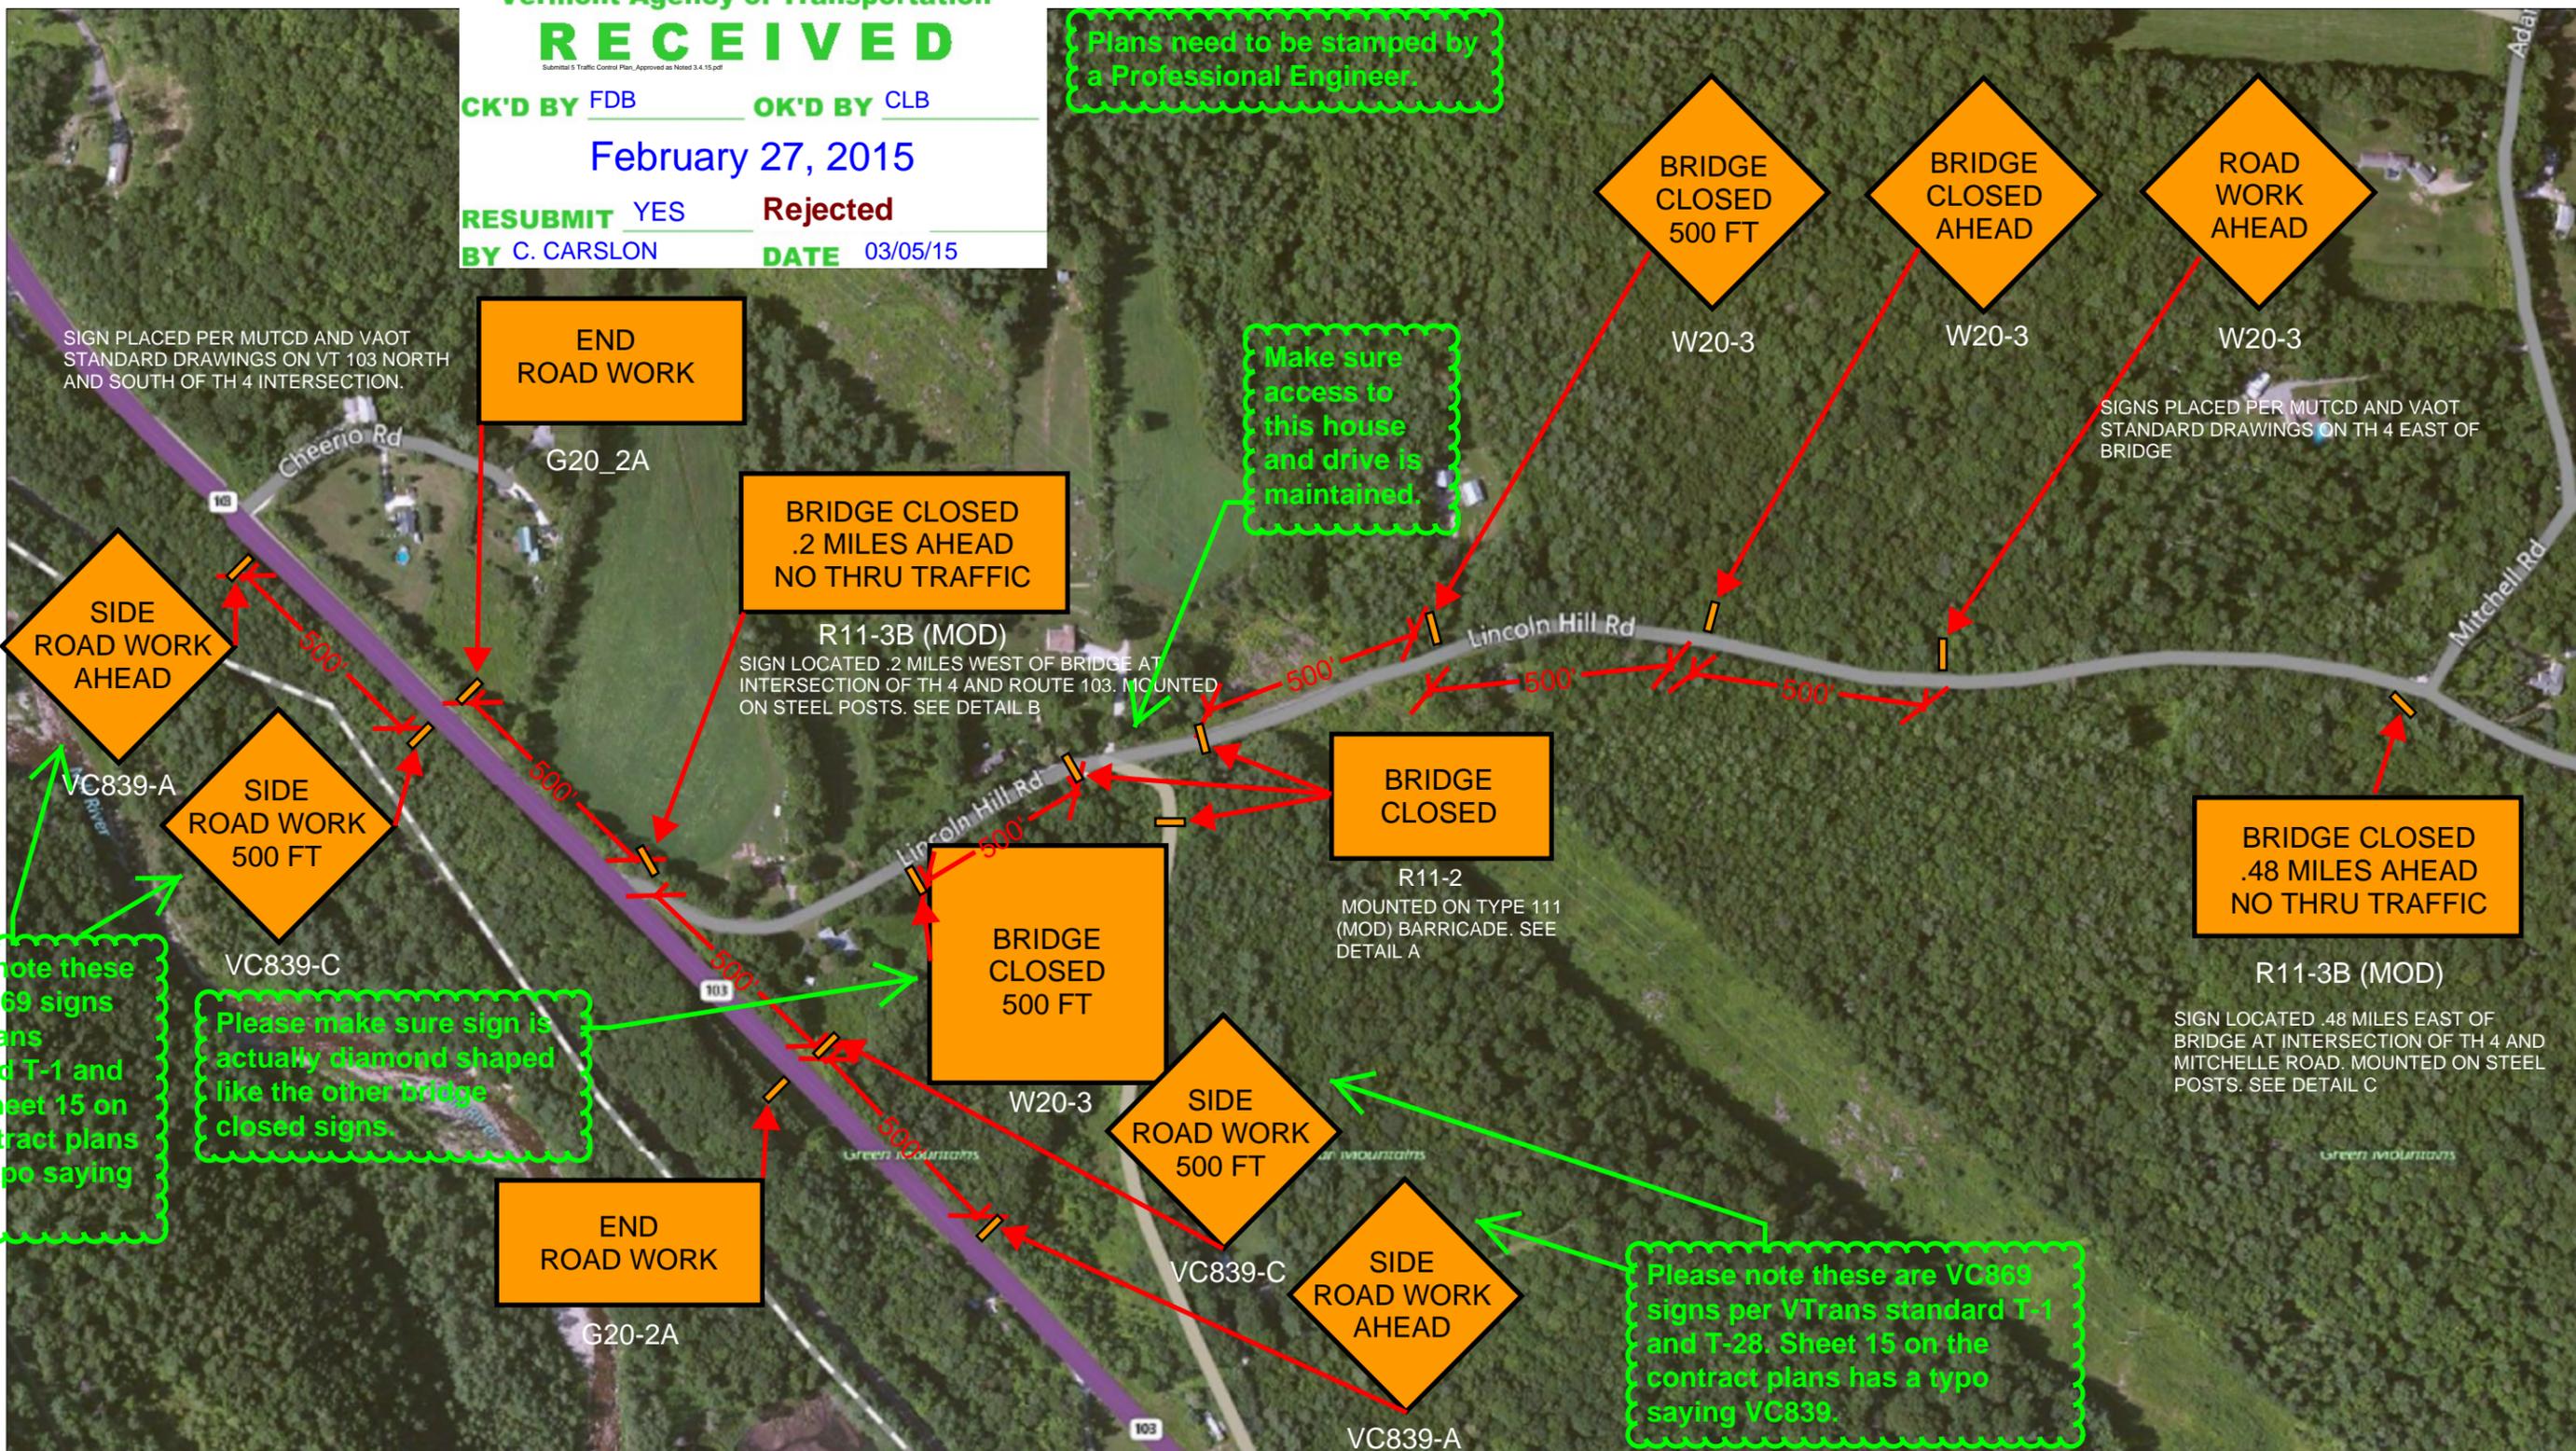

CASELLA CONSTRUCTION, INC.

25 INDUSTRIAL LANE
MENDON, VERMONT 05701

PHONE: 802.773.0052
FAX: 802.747.7992


PROJECT: SHREWSBURY STP 1443 (44)
SHREWSBURY, VERMONT

DRAWING: Traffic Control Plan

VERMONT AGENCY OF TRANSPORTATION

ONE NATIONAL LIFE DRIVE
MONTPELIER, VT 05633





DRAWN BY:	JDR
PREPARED BY:	JC, EIT
DATE:	02/11/15
DRAWING NUMBER:	1 of 2
DRAWING SCALE:	

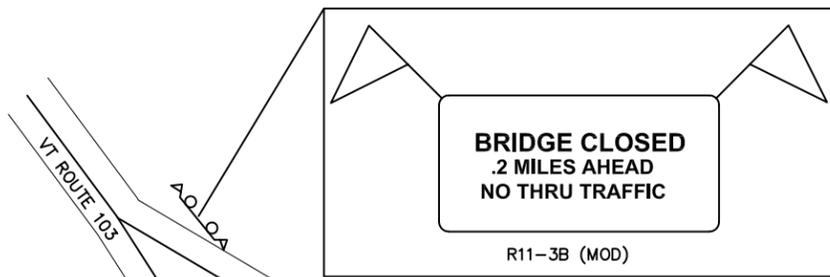

SIGN LOCATED .2 MILES WEST OF BRIDGE AT INTERSECTION OF TH 4 AND ROUTE 103. MOUNTED ON STEEL POSTS.


DETAIL B

Make sure access to this house and drive is maintained.

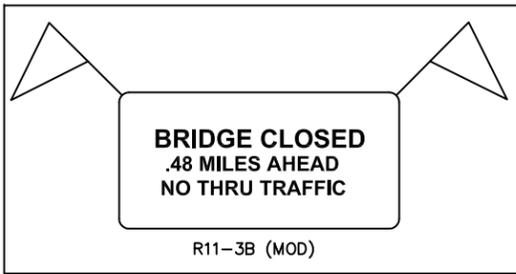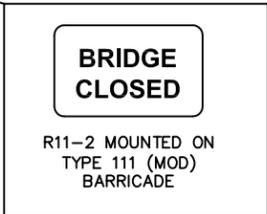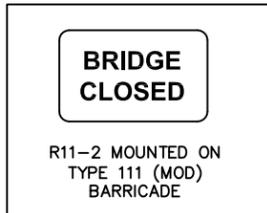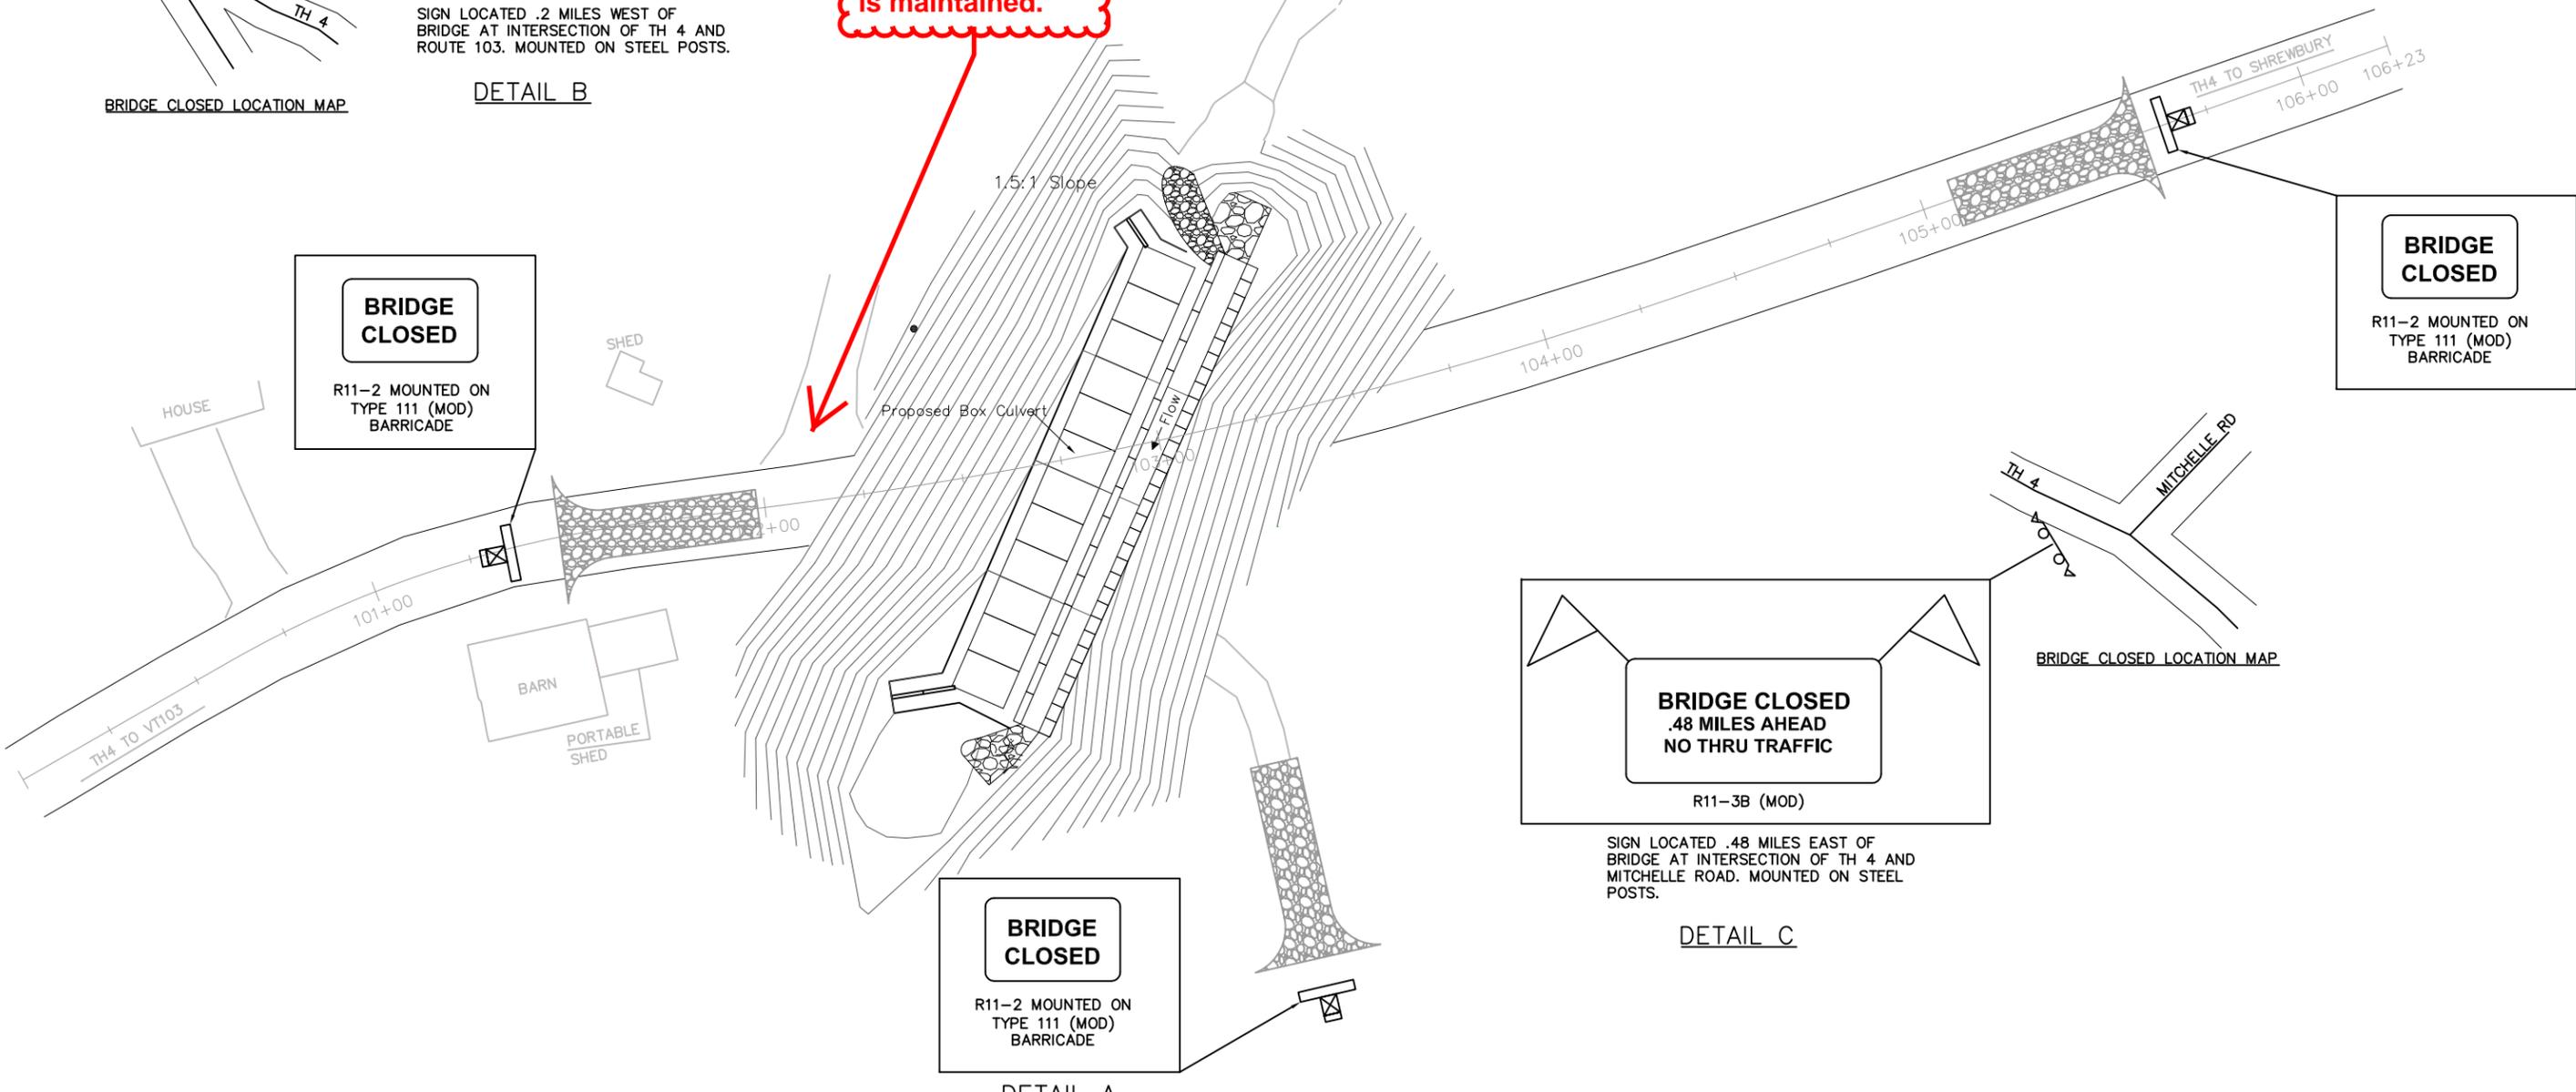

SIGN LOCATED .48 MILES EAST OF BRIDGE AT INTERSECTION OF TH 4 AND MITCHELLE ROAD. MOUNTED ON STEEL POSTS.

DETAIL C

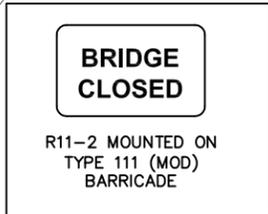

DETAIL A



CASELLA CONSTRUCTION, INC.

25 INDUSTRIAL LANE
MENDON, VERMONT 05701

PHONE: 802.773.0052
FAX: 802.747.7992

PROJECT: **SHREWSBURY STP 1443 (44)
SHREWSBURY, VERMONT**

DRAWING: Traffic Control Plan

VERMONT AGENCY OF TRANSPORTATION

**ONE NATIONAL LIFE DRIVE
MONTPELIER, VT 05633**

DRAWN BY: JDR

PREPARED BY: JC, EIT

DATE: 02/11/15

DRAWING NUMBER: 2 of 2

DRAWING SCALE: