

These Bars will need to be extended the full length of the closure pour (TYP).

Flange Thickness is 10 3/4"


The distance to provide the reinforcing is also along the skew (TYP).

The closure pour has been changed to include the cheek walls. Please provide reinforcing between the last stem to the end of each cheek wall. (TYP)

Verify lengths of ALL Horizontal bars as they will be placed along bridge skew. (TYP)

Note: All comments with (TYP) apply to both closure pours.



Note: 3 x 30'-0" Bars provide more length than required. Okay.

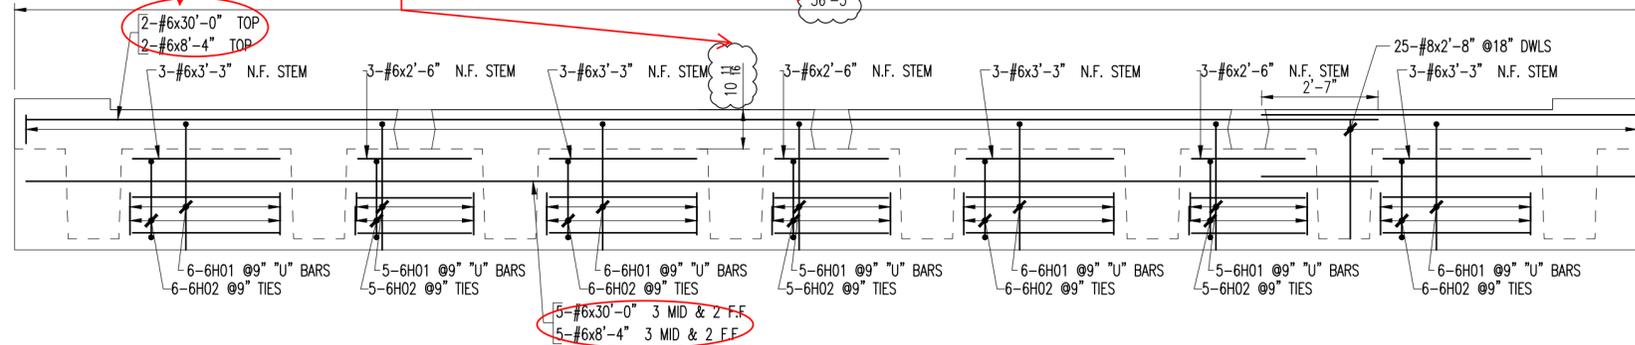

9" CLOSURE POUR  
3 RUNS OF 79'-3/4" REQ'D

#4 Bars

These Bars will need to be extended the full length of the closure pour. (TYP)

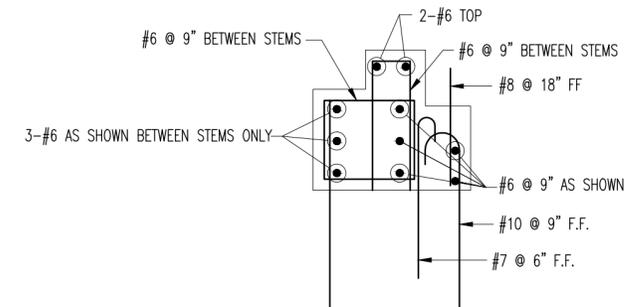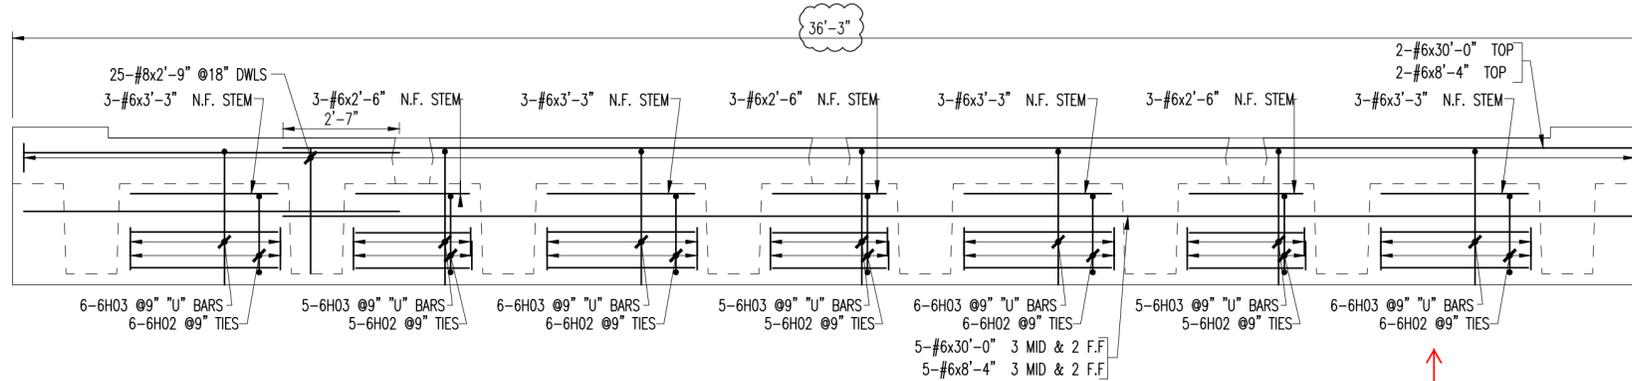

Increase Height of 6H03 and 6H02 by 1" for Next Beam in the final bay.


Drawing Sheet : R02

| BAR LIST |    | A' | B'     | C' | D' | E'     | F'    | G'     | H'    | I' | J' | K' | L' | M' |
|----------|----|----|--------|----|----|--------|-------|--------|-------|----|----|----|----|----|
| 6H01     | 39 | #6 | 6'-6"  | 17 |    | 2'-10" | 10"   | 2'-10" |       |    |    |    |    |    |
| 6H02     | 78 | #6 | 8'-10" | 11 | 8" | 1'-9"  | 2'-0" | 1'-9"  | 2'-0" |    |    |    |    |    |
| 6H03     | 39 | #6 | 6'-10" | 17 |    | 3'-0"  | 10"   | 3'-0"  |       |    |    |    |    |    |

Vermont Agency of Transportation  
**RECEIVED**  
CK'D BY JG OK'D BY WL  
March 28, 2014  
RESUBMIT YES Rejected  
BY KH DATE 4-1-2014

Please provide Grade and ASTM SPEC

ALL REINF ON THIS DWG IS DUAL COATED REINF

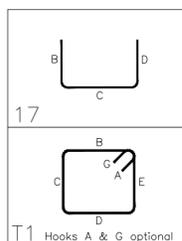

LAP CHART-U.N.O.

| SIZE | TOP BARS * | OTHER BARS |
|------|------------|------------|
| #11  |            |            |
| #10  |            |            |
| #9   |            |            |
| #8   |            |            |
| #7   |            |            |
| #6   | 2'-7"      |            |
| #5   |            |            |
| #4   | 2'-0"      |            |
| #3   |            |            |

\* -Top bars are horiz. bars with more than 12" of concrete cast below the bars.

| No.  | Description | Date                                    | By       |
|--|-------------|---|----------|
| 0  | APPROVAL    | 3-27-14                                 | TRH      |
| Revisions and Issue Record   |             |   |          |
| The full intent and purpose of this drawing is the placing of reinforcing steel bars ONLY. It is NOT to be used as a means of communication between the Architect, Engineer, Contractor or any other Sub-trades. |             |   |          |
| THIS DRAWING IS NOT TO BE SCALED.  |             |   |          |
|  |             | DETAILED AT:<br>CANAAN<br>NEW HAMPSHIRE |          |
| Project: PITTSFIELD ER BRF 022-1(33)<br>PITTSFIELD, VT   |             |   |          |
| Drawing: DECK CLOSURE POUR   |             |   |          |
| Customer: COLD RIVER BRIDGES   |             |   |          |
| Engineer:  |             |   |          |
| Refer to Release:  |             |   |          |
| Date   | Drawn       | Chkd.                                   | JOB No.  |
| 3-26-14  | TRH         |   | 33505152 |
|  |             |   | Dwg. No. |
|  |             |   | R02      |