



SECTION A-A  
DIMENSIONS SHOWN ALONG FFBW


suggest replacing this finish with galvagit or slipNOT coating, as those are much more durable finishes.

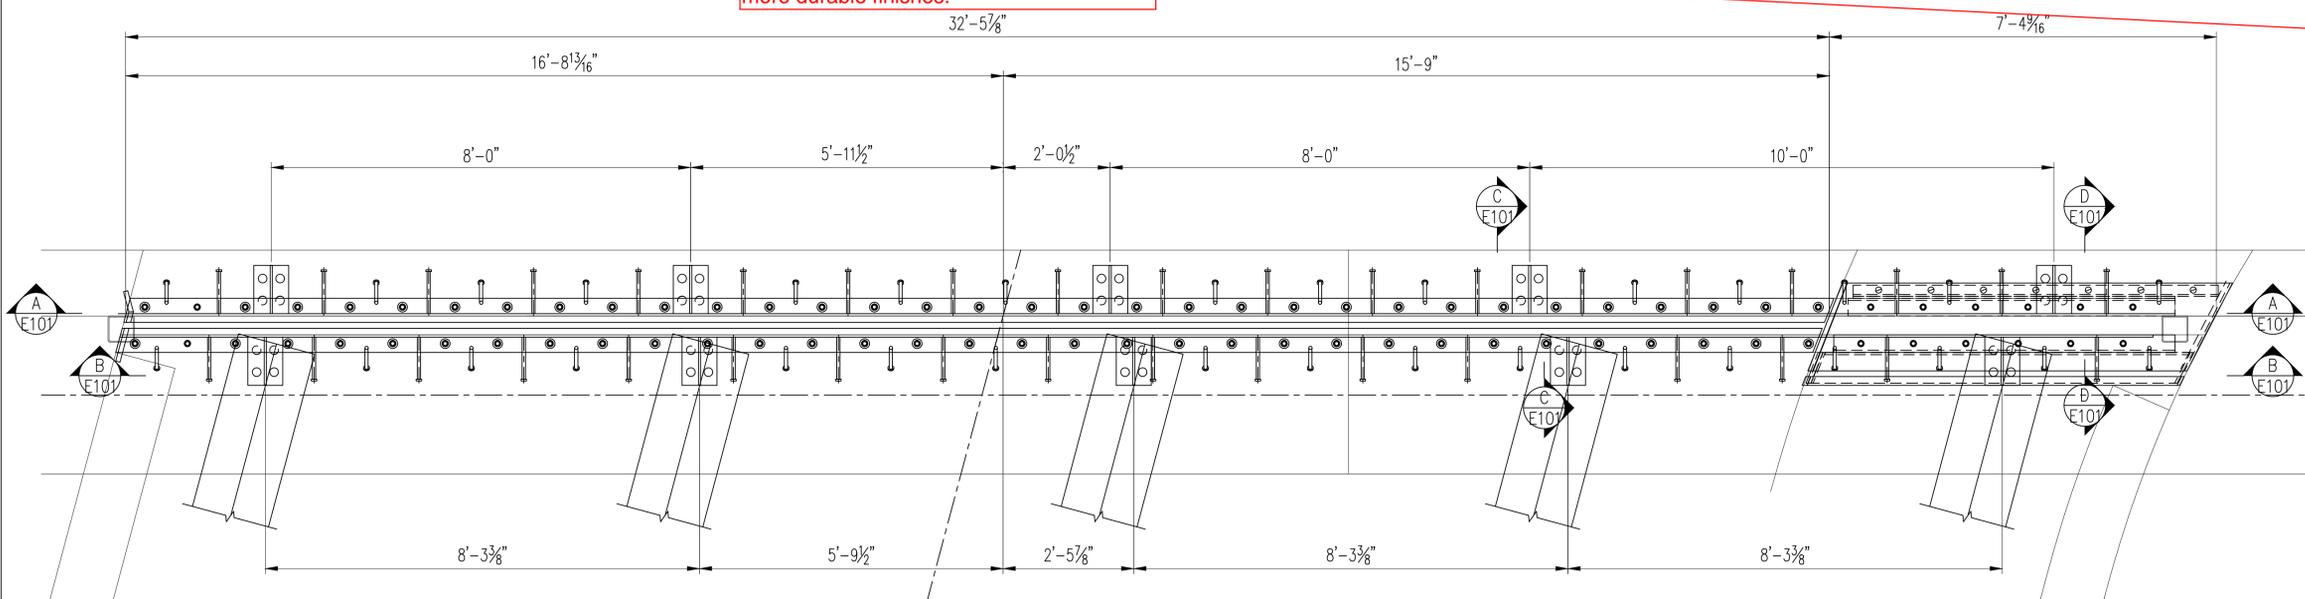


EXPANSION JOINT PLAN

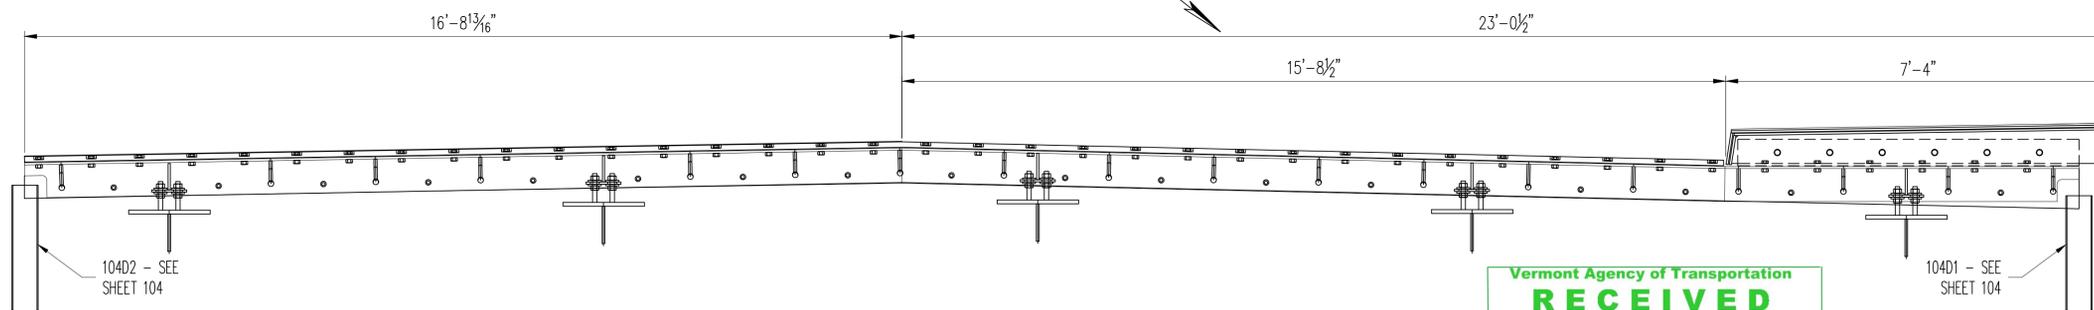

SECTION B-B

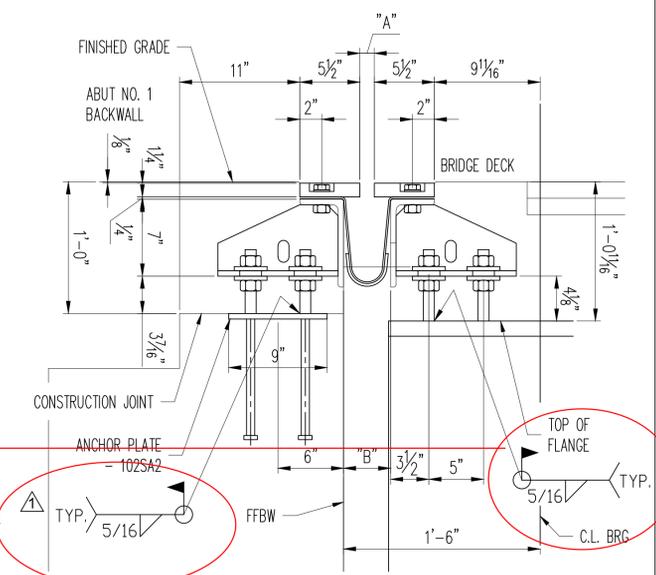

SECTION C-C

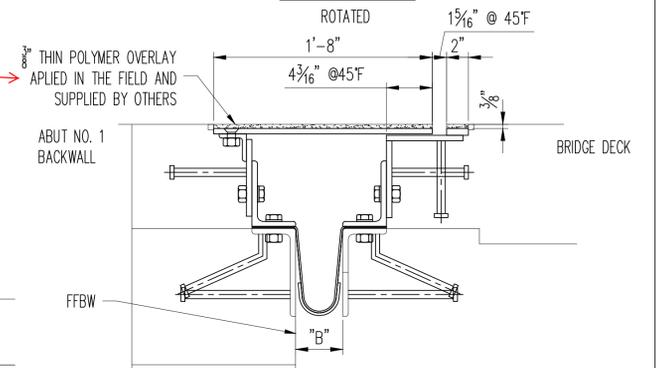


SECTION D-D

TEMP. SETTING CHART		
TEMP °F	DIM "A"	DIM "B"
0	1 7/8"	4 7/8"
15°	1 11/16"	4 11/16"
30°	1 1/2"	4 1/2"
45°	1 5/16"	4 5/16"
60°	1 1/8"	4 1/8"
75°	1 5/16"	3 15/16"
90°	3/4"	3 3/4"
105°	9/16"	3 9/16"

3/4/15 PER APPROVAL		JEB	JER		
REV.	DATE	REMARKS	DWN	CHK	APVL SHOP
MATERIAL: M270M-250 U.N.O.		SURFACE PREP. & PAINT: GALV. - PER STD. 726.08		HOLES: AS NOTED	
				SHOP BOLTS: AS NOTED	
DESCRIPTION: EXPANSION JOINT - ERECTION SHEET					
CASCO BAY STEEL STRUCTURES, INC.					
1 WALLACE AVE.		PHONE (207) 780-6722			
SOUTH PORTLAND, ME 04106		FAX. (207) 780-6726			
STRUCTURE: BRIDGE NO. 2 (TH 8)		TH 8 (RIVER STREET)		DRAWN: JEB	DATE: 1/5/15
URBAN COLLECTOR - FAU 3052		STATE OF VERMONT AGENCY OF TRANS.		CHKD: JER	DATE: 1/10/15
LOCATION: RUTLAND COUNTY, VT		JOB NO. 597		DWG NO. E101	
PROJ NO. BRF 3000 (16)		CUSTOMER: KUBRICKY CONSTRUCTION, CORP.		REV. 1	

Vermont Agency of Transportation  
**RECEIVED**  
CK'D BY MEM OK'D BY  
Apr. 03, 2015  
RESUBMIT X  
BY C. Carlson DATE 04-14-2015


NOTES:  
- ALL DIMENSIONS SHOWN HORIZONTAL U.N.O.  
- ALL DIMENSIONS SHOWN AT 45F.

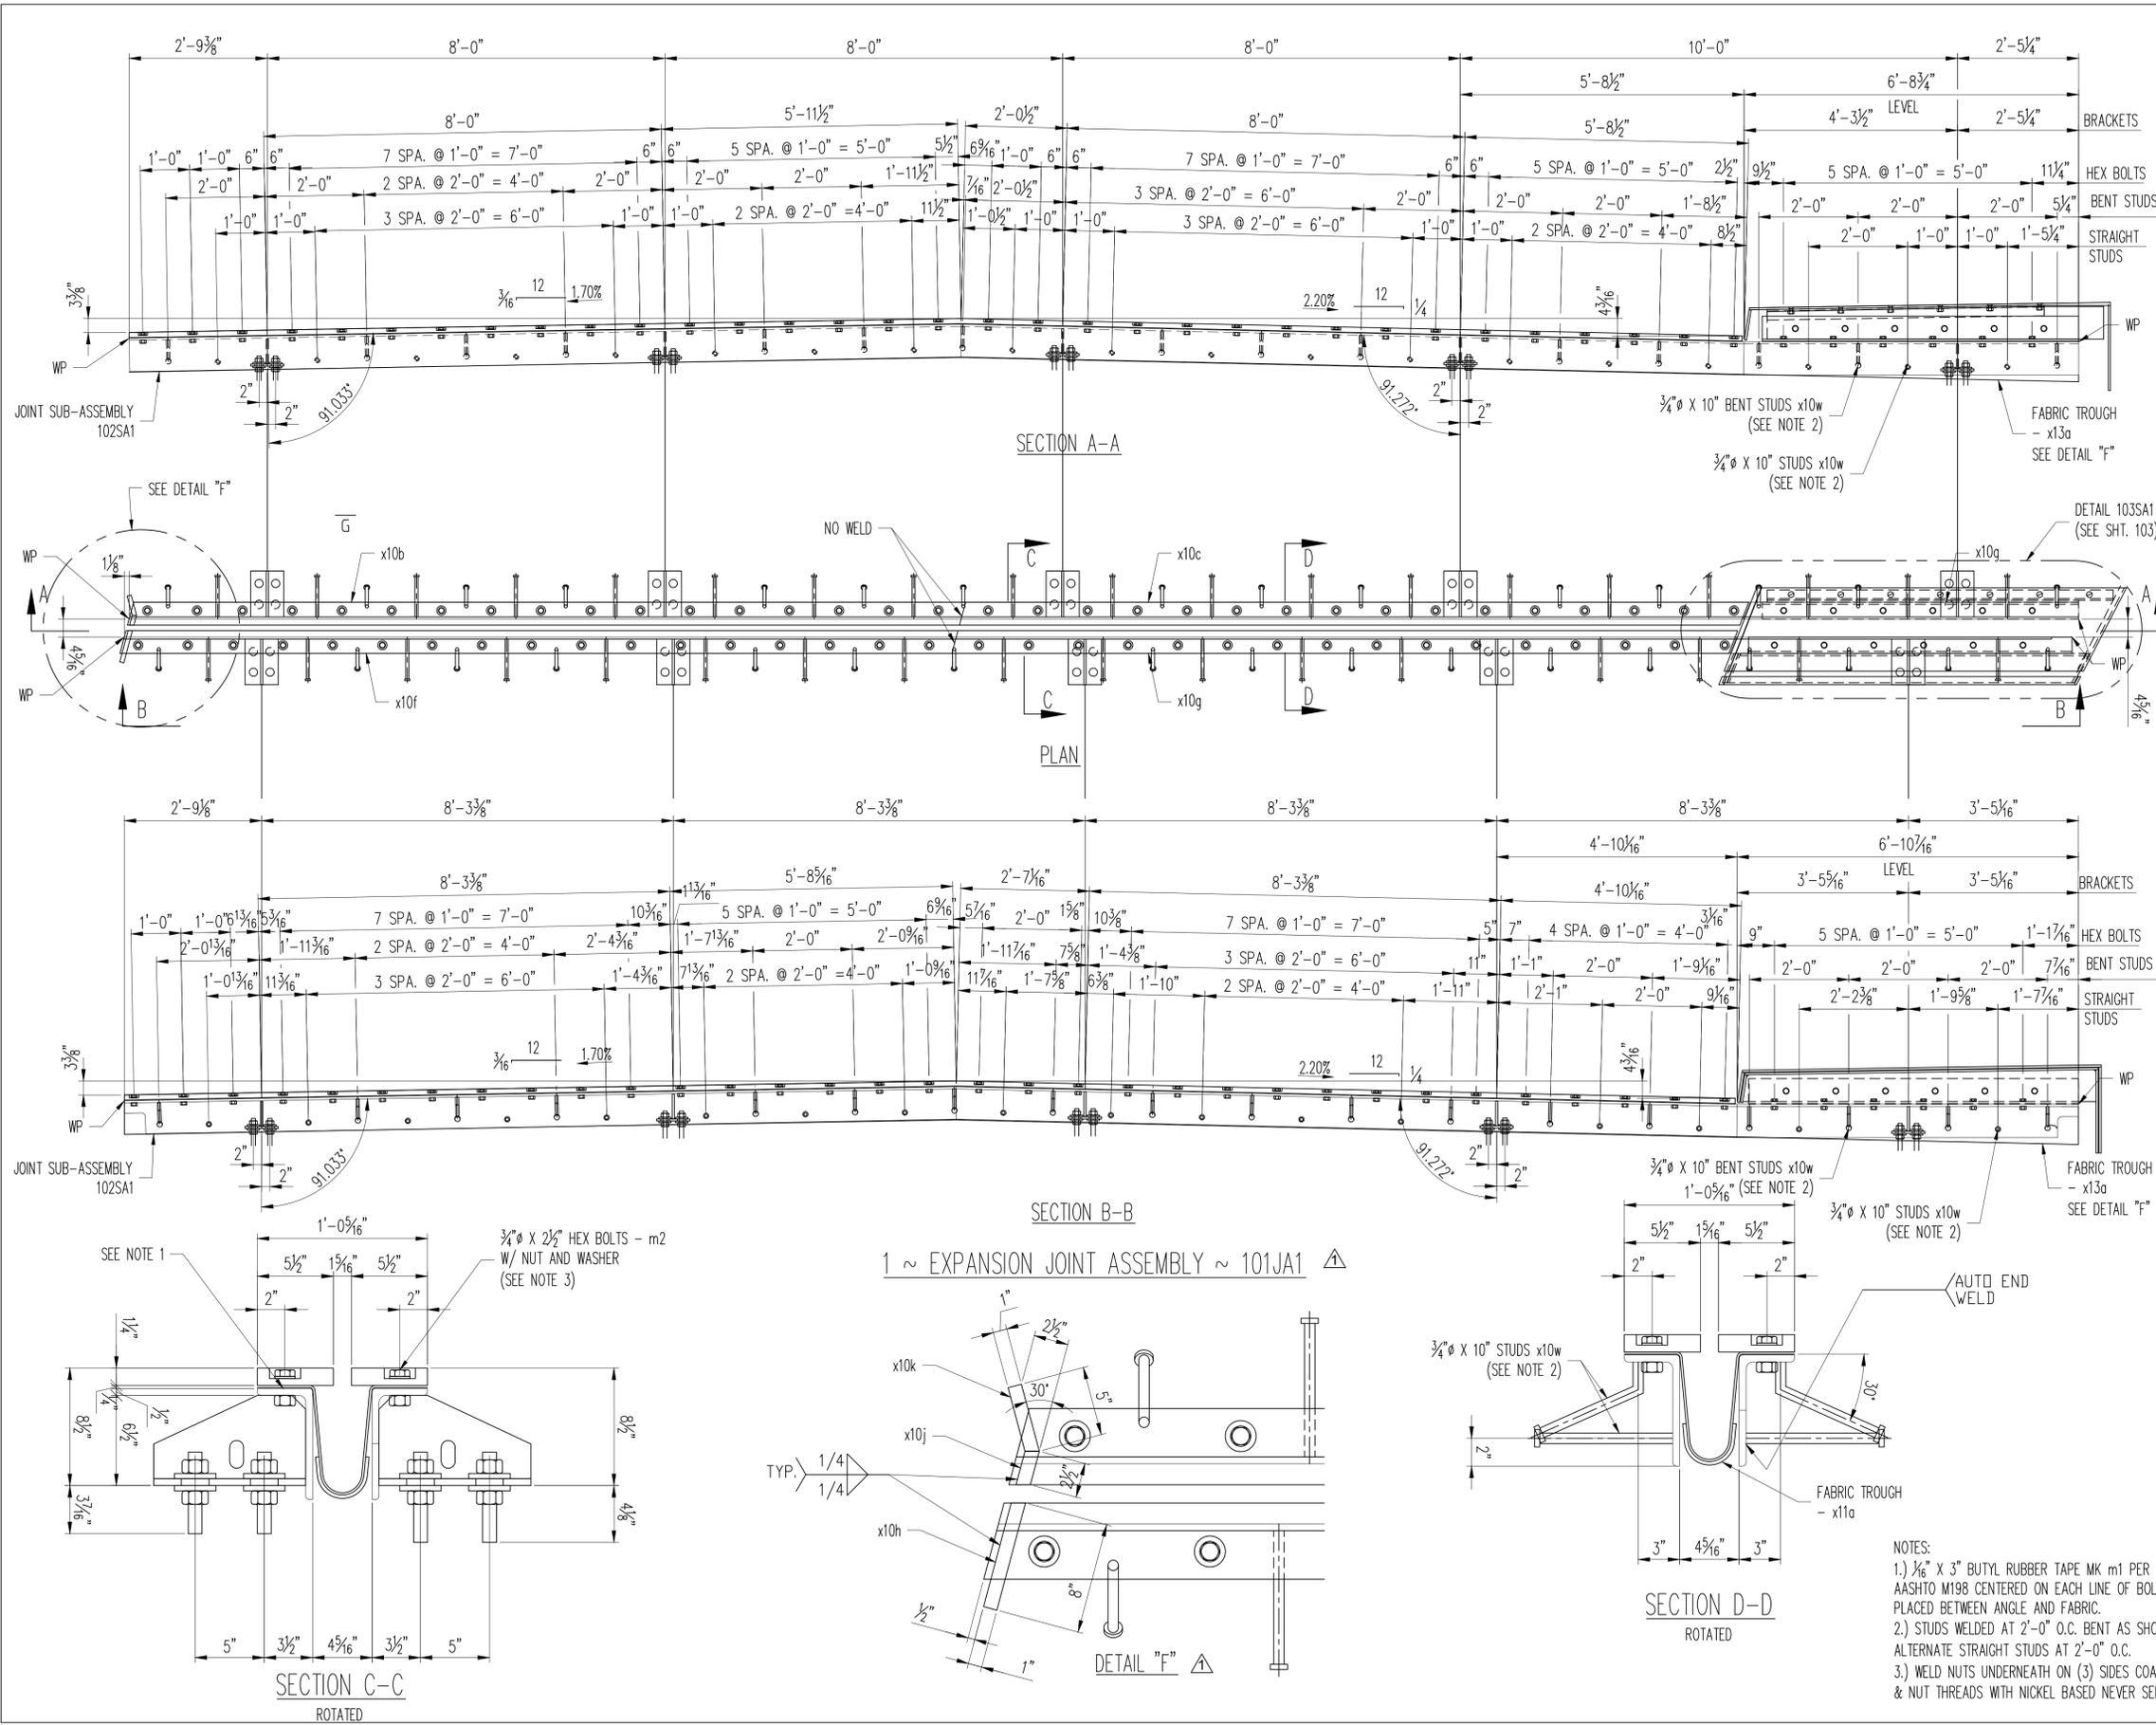


BILL OF MATERIAL							
BLOCK QTY.	BLOCK NO.	MARK	NO. PCS	SHAPE	LENGTH FT	IN	REMARKS
1	1	101JA1	ONE	FINGER JOINT	38	2 3/8	GALV
2							
3	x10b	1		PL 1 1/4 X 5 1/2	16	10 9/16	GALV
4	x10c	1		PL 1 1/4 X 5 1/2	15	10 9/16	GALV
5							
6	x10f	1		PL 1 1/4 X 5 1/2	16	10 9/16	GALV
7	x10g	1		PL 1 1/4 X 5 1/2	15	9 3/4	GALV
8	x10h	1		PL 1 X 1	0	8	GALV
9	x10j	1		PL 1 X 1	0	2 3/4	GALV
10	x10k	1		PL 1 X 1	0	5	GALV
11	x10m	10		PL 1/2 X 8	0	11	GALV
12	x10n	10		PL 1/2 X 6	0	11	GALV
13	x10p	80		PL 3/8 X 3	0	3	GALV
14	x10t	10		L4 X 4 X 1/4	1	2 5/8	GALV
15							
16	x11b	1		L8 X 4 X 1/2	16	9 15/16	GALV
17	x11c	1		L8 X 4 X 1/2	15	10 9/16	GALV
18	x11d	1		L8 X 4 X 1/2	6	8 7/8	GALV
19							
20	x11g	1		L8 X 4 X 1/2	16	9 15/16	GALV
21	x11h	1		L8 X 4 X 1/2	15	9 3/8	GALV
22	x11k	1		L8 X 4 X 1/2	6	11 1/16	GALV
23	x12a	1		PL 1/2 X 20	8	0	GALV
24	x12b	1		PL 3/4 X 2	7	2 1/4	GALV
25	x12c	1		PL 1/2 X 7 1/2	1	9 13/16	GALV
26	x12d	1		PL 3/8 X 2 1/2	0	7 1/16	GALV
27	x12f	1		PL 1/2 X 21	1	10 1/4	GALV
28	x12g	1		PL 3/8 X 2	1	8 7/8	GALV
29	x12h	1		PL 1/2 X 7	7	3 1/4	GALV
30	x12k	1		PL 1/2 X 6 13/16	0	7 7/8	GALV
31	x12m	1		PL 1/2 X 7 3/8	1	8 3/8	GALV
32	x12n	1		L2 1/2 X 2 1/2 X 3/8	7	0 9/16	GALV
33	x12p	1		PL 1/2 X 7 3/8	7	3 1/16	GALV
34	x12r	1		PL 1/2 X 7 3/8	7	0 9/16	GALV
35	x12t	1		L6 X 4 X 1/2	6	5 1/2	GALV
36	x12v	1		L6 X 4 X 1/2	6	8 1/2	GALV
37	x13a	1		NP 5/32 X 26	39	4 1/16	FABRIC TROUGH
38	x10w	69		3/4 DIA STUD	0	10	HEADED STUD
39	x10x	10		3/4 DIA STUD	0	7	HEADED STUD
40	m1	2		1/16 X 3 TAPE	39	0	AASHTO M198
41	m2	46		1/2 DIA GALV BOLTS	0	2 1/2	W/ NUT & WASHER
42	m3	20		3/4 DIA GALV BOLTS	0	3 1/2	W/ NUT & WASHER
43	m4	24		1/2 DIA GALV BOLTS	0	2 1/4	W/ NUT & WASHER
44	m5	7		1/4 DIA FLTH SPOKES	0	2	W/ NUT
45	m1	40		1 THRD. RODS	0	7	W/ 2-NUTS

Vermont Agency of Transportation  
**RECEIVED**  
 CK'D BY MEM OK'D BY  
 Apr. 03, 2015  
 RESUBMIT  
 BY C. Carlson DATE 04-14-2015

3/4/15 PER APPROVAL	JEB	JER		
REV. DATE	REMARKS	DWN	CHK	APVL SHOP
MATERIAL: M270M-250 U.N.O.	SURFACE PREP. & PAINT: GALV. - PER STD. 726.08	HOLES: AS NOTED	SHOP BOLTS: AS NOTED	
DESCRIPTION: EXPANSION JOINT - ASSEMBLY SHEET				
CASCO BAY STEEL STRUCTURES, INC. 1 WALLACE AVE. PHONE (207) 780-6722 SOUTH PORTLAND, ME 04106 FAX. (207) 780-6726				
STRUCTURE: BRIDGE NO. 2 (TH 8) TH 8 (RIVER STREET) URBAN COLLECTOR - FAU 3052 STATE OF VERMONT AGENCY OF TRANS.	DRAWN: JEB	DATE: 1/5/15		
	CHKD: JER	DATE: 1/10/15		
LOCATION: RUTLAND COUNTY, VT	JOB NO. 597	DWG NO. 101		
PROJ. NO. BRF 3000 (16)		REV. 1		
CUSTOMER: KUBRICKY CONSTRUCTION, CORP.				

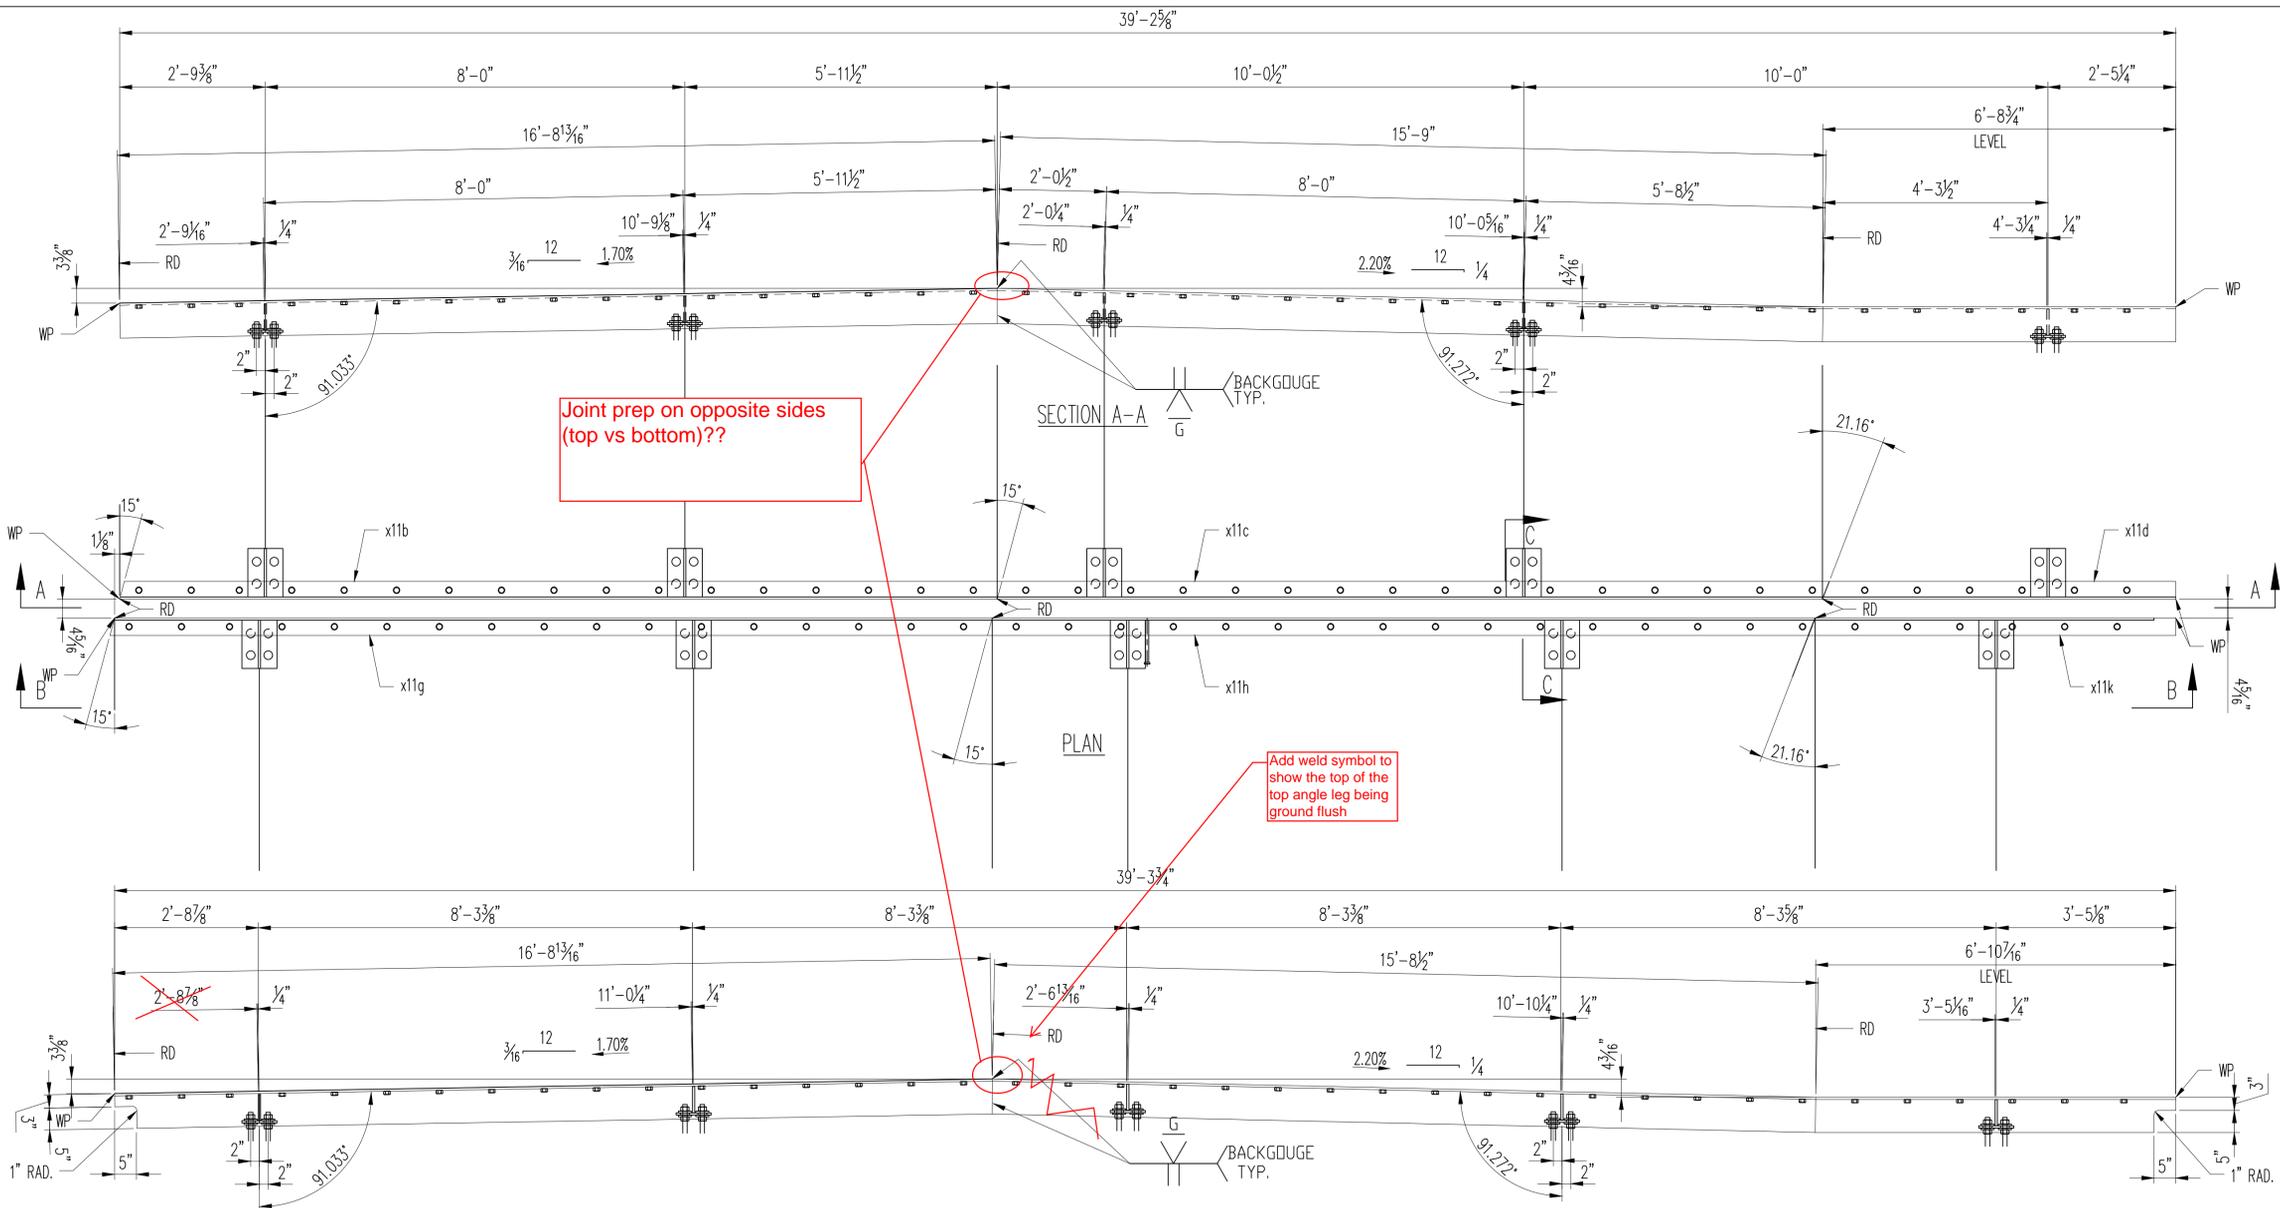


1 ~ LOWER JOINT SUB-ASSEMBLY ~ 102SA1

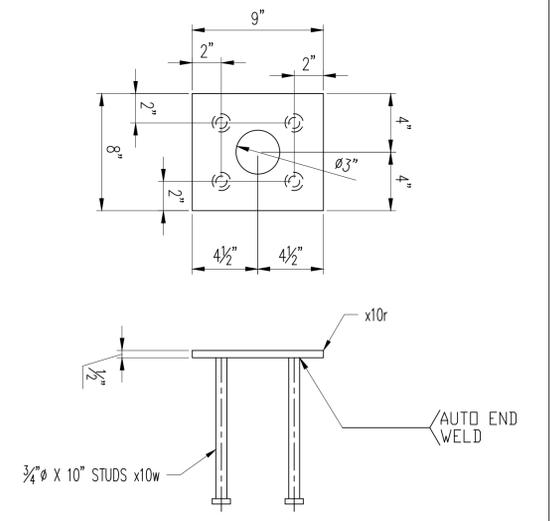


5 ~ ANCHOR PLATES ~ 102SA2

- NOTES:
- 1.) 1/8" X 3" BUTYL RUBBER TAPE MK m1 PER AASHTO M198 CENTERED ON EACH LINE OF BOLTS AND PLACED BETWEEN ANGLE AND FABRIC.
  - 2.) STUDS WELDED AT 2'-0" O.C. BENT AS SHOWN ALTERNATE STRAIGHT STUDS AT 2'-0" O.C.
  - 3.) WELD NUTS UNDERNEATH ON (3) SIDES COAT BOLT & NUT THREADS WITH NICKEL BASED NEVER SEIZE LUBE.

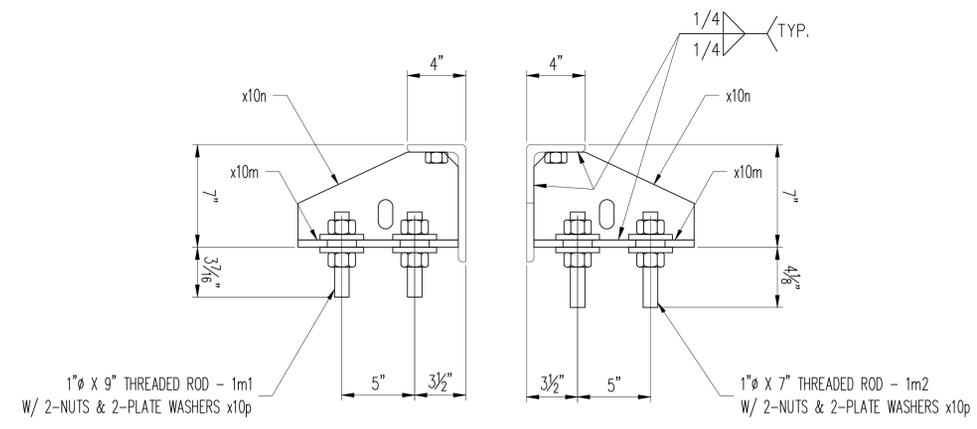

SECTION C-C  
ROTATED

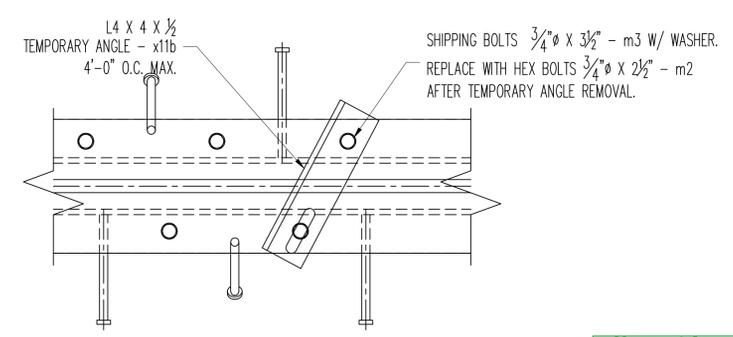


SHIPPING DETAIL


Vermont Agency of Transportation  
**RECEIVED**  
 CK'D BY MEM OK'D BY  
 Apr. 03, 2015  
 RESUBMIT  
 BY C. Carlson DATE 04-14-2015

3/4/15 PER APPROVAL		JEB	JER		
REV.	DATE	REMARKS	DWN	CHK	APVL SHOP
MATERIAL: M270M-250 U.N.O.		SURFACE PREP. & PAINT: GALV. - PER STD. 726.08		HOLES: AS NOTED	
				SHOP BOLTS: AS NOTED	
DESCRIPTION: EXPANSION JOINT - ASSEMBLY SHEET					
CASCO BAY STEEL STRUCTURES, INC.					
1 WALLACE AVE.		PHONE (207) 780-6722			
SOUTH PORTLAND, ME 04106		FAX. (207) 780-6726			
STRUCTURE: BRIDGE NO. 2 (TH 8)		TH 8 (RIVER STREET)		DRAWN: JEB	DATE: 1/5/15
		URBAN COLLECTOR - FAU 3052		CHKD: JER	DATE: 1/10/15
		STATE OF VERMONT AGENCY OF TRANS.			
LOCATION: RUTLAND COUNTY, VT		JOB NO. 597		DWG NO. 102	
PROJ NO. BRF 3000 (16)				REV. 1	
CUSTOMER: KUBRICKY CONSTRUCTION, CORP.					



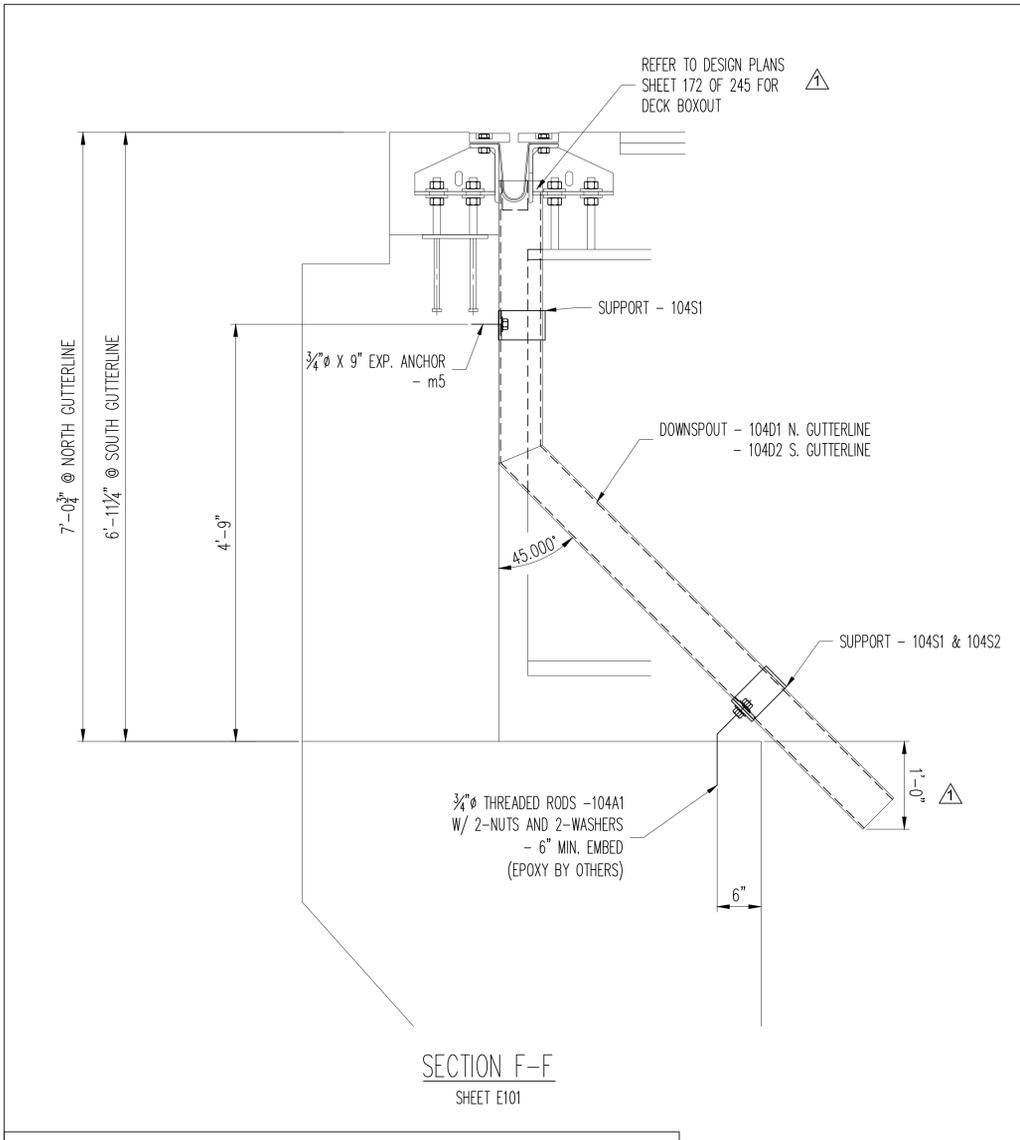


BILL OF MATERIAL							
BLOCK QTY.	BLOCK NO.	MARK	PCS	SHAPE	FT	IN	REMARKS
	1	102SA2	5	ANCHOR PL.	0	9	GALV
	2	x10r	5	PL 1/2 X 8	0	9	GALV
	3	x10w	20	3/4 DIA STUD	0	10	HEADED STUD
	4						
	5	104D1	1	DOWNSPOUT	8	3	GALV
	6	x11s	1	HSS 6 X 6 X 1/4	3	4 3/4	A500B
	7	x11t	1	HSS 6 X 6 X 1/4	5	7 7/8	A500B
	8						
	9	104D2	1	DOWNSPOUT	8	3	GALV
	10	x11v	1	HSS 6 X 6 X 1/4	3	4 3/4	A500B
	11	x11w	1	HSS 6 X 6 X 1/4	5	7 7/8	A500B
	12						
	13	104S1	4	SUPPORT.	1	1	GALV
	14	x14c	4	PL 3/8 X 4	1	11 13/16	GALV
	15						
	16	104S2	2	SUPPORT.	1	1	GALV
	17	x14d	2	PL 3/8 X 4	1	1	GALV
	18						
	19	104A1	4	ANCHOR RODS	1	2	
	20	1m3	4	1" THRD. RODS	1	2	W/ 2-NUTS & 2-WASHERS
	21						
	22			FIELD BOLTS:			
	23	m2	20	3/4 DA GALV BOLTS	0	2 1/2	W/ NUT & WASHER
	24	m6	4	3/4 DA EXP. ANCH.	0	9	W/ NUT & WASHER

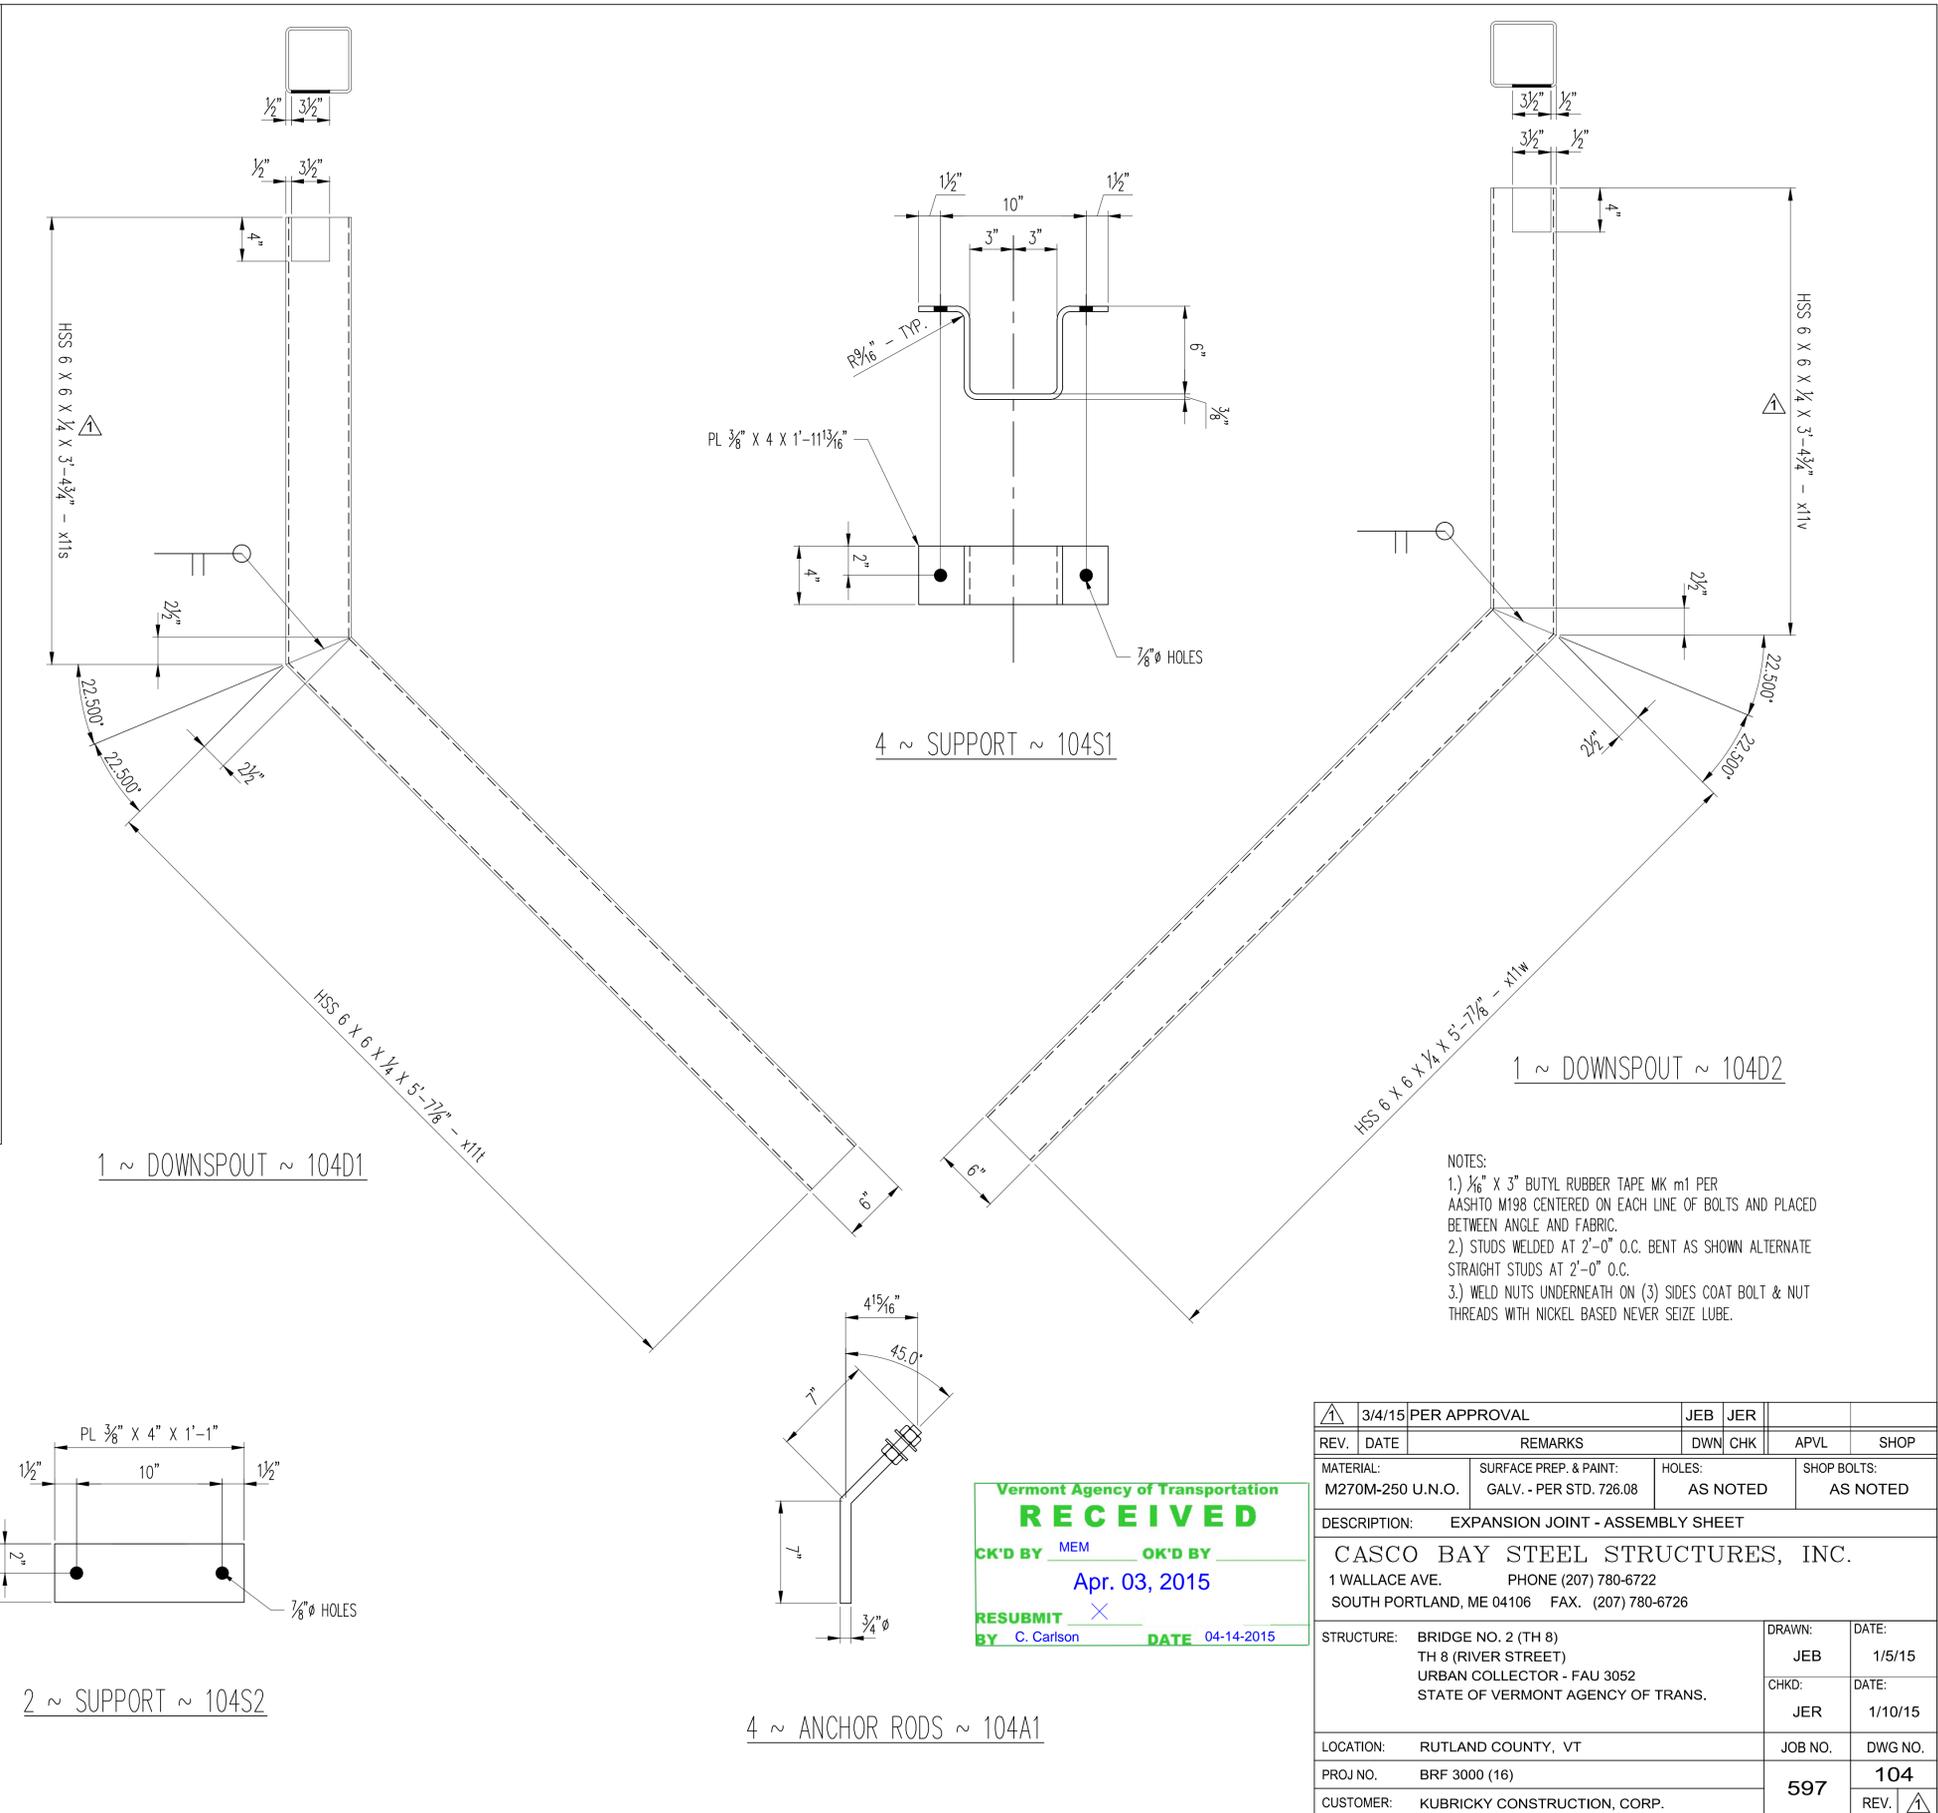

- NOTES:
- 1) 1/2" x 3" BUTYL RUBBER TAPE MK m1 PER AASHTO M198 CENTERED ON EACH LINE OF BOLTS AND PLACED BETWEEN ANGLE AND FABRIC.
  - 2) STUDS WELDED AT 2'-0" O.C. BENT AS SHOWN ALTERNATE STRAIGHT STUDS AT 2'-0" O.C.
  - 3) WELD NUTS UNDERNEATH ON (3) SIDES COAT BOLT & NUT THREADS WITH NICKEL BASED NEVER SEIZE LUBE.















REV.	DATE	REMARKS	DWN	CHK	APVL	SHOP
	3/4/15	PER APPROVAL	JEB	JER		
MATERIAL:		SURFACE PREP. & PAINT:		HOLES:		SHOP BOLTS:
M270M-250 U.N.O.		GALV. - PER STD. 726.08		AS NOTED		AS NOTED
DESCRIPTION: EXPANSION JOINT - ASSEMBLY SHEET						
CASCO BAY STEEL STRUCTURES, INC.						
1 WALLACE AVE.			PHONE (207) 780-6722			
SOUTH PORTLAND, ME 04106			FAX. (207) 780-6726			
STRUCTURE: BRIDGE NO. 2 (TH 8) TH 8 (RIVER STREET) URBAN COLLECTOR - FAU 3052 STATE OF VERMONT AGENCY OF TRANS.				DRAWN:	DATE:	
				JEB	1/5/15	
				CHKD:	DATE:	
				JER	1/10/15	
LOCATION: RUTLAND COUNTY, VT				JOB NO.	DWG NO.	
PROJ NO. BRF 3000 (16)				597	104	
CUSTOMER: KUBRICKY CONSTRUCTION, CORP.					REV. A	



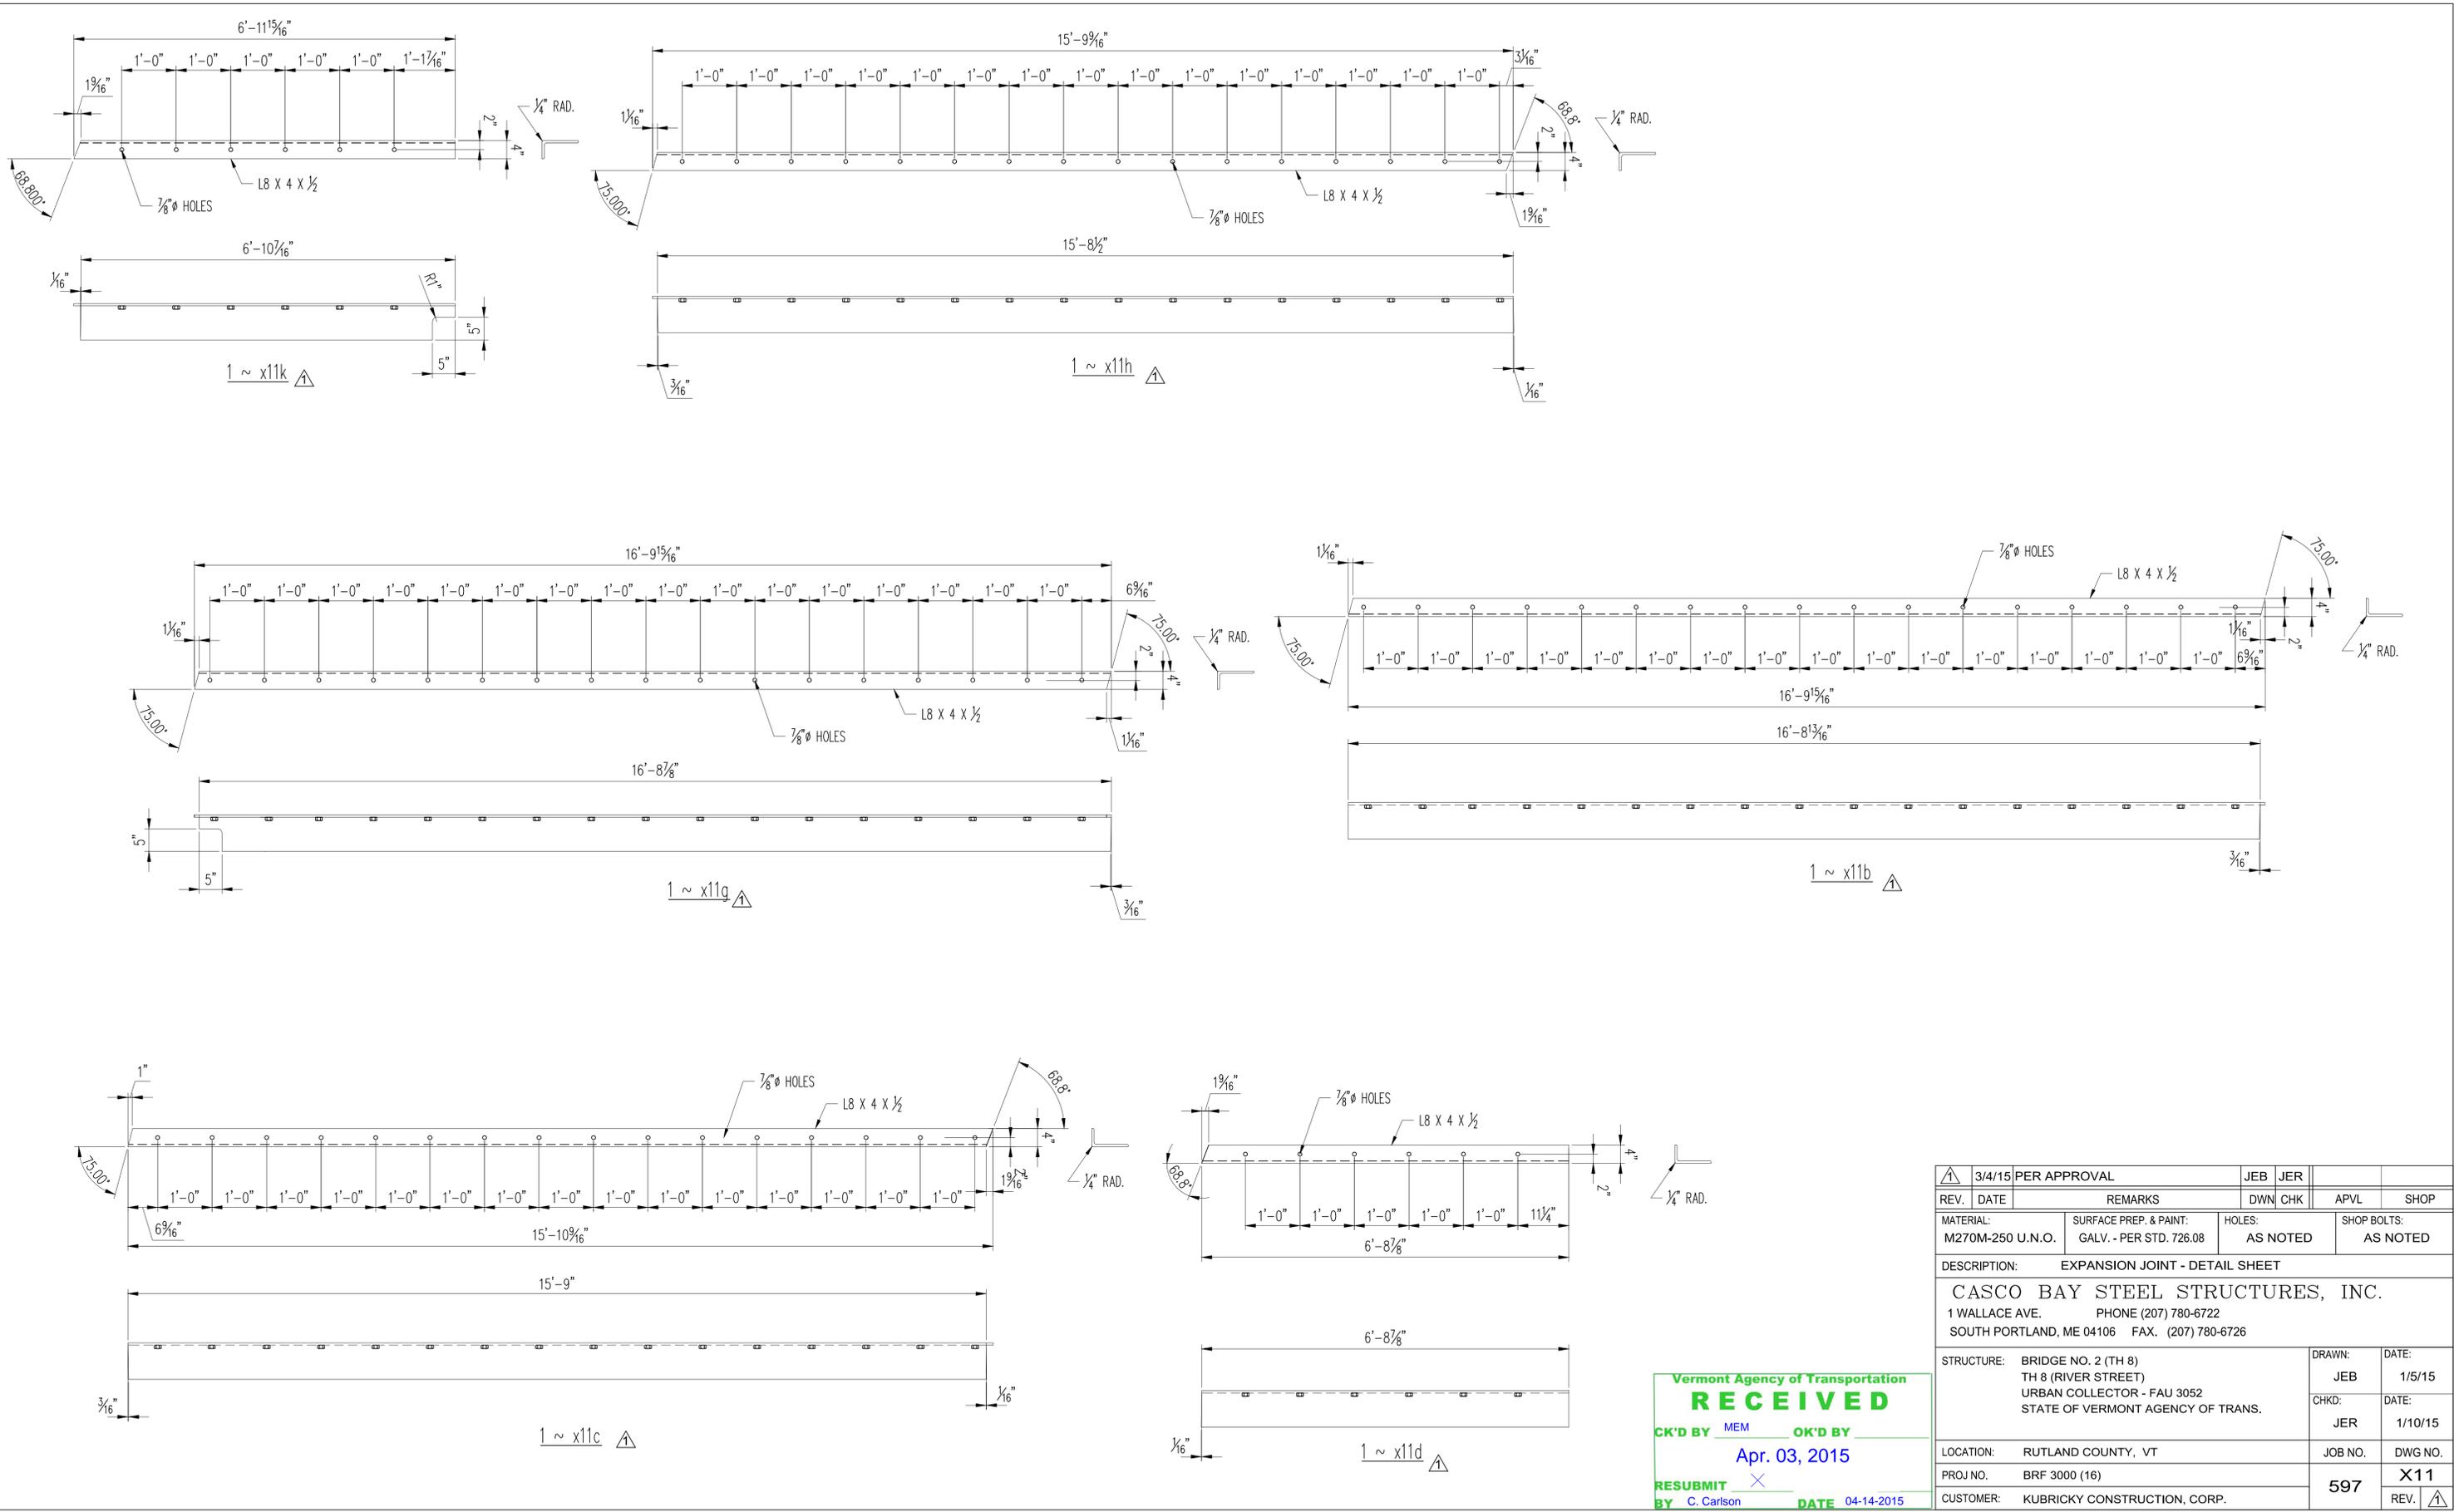


Vermont Agency of Transportation  
**RECEIVED**  
 CK'D BY MEM OK'D BY  
 Apr. 03, 2015  
 RESUBMIT X  
 BY C. Carlson DATE 04-14-2015

3/4/15 PER APPROVAL	JEB	JER		
REV. DATE	REMARKS	DWN	CHK	APVL SHOP
MATERIAL: M270M-250 U.N.O.	SURFACE PREP. & PAINT: GALV. - PER STD. 726.08	HOLES: AS NOTED	SHOP BOLTS: AS NOTED	
DESCRIPTION: EXPANSION JOINT - DETAIL SHEET				
CASCO BAY STEEL STRUCTURES, INC. 1 WALLACE AVE. PHONE (207) 780-6722 SOUTH PORTLAND, ME 04106 FAX. (207) 780-6726				
STRUCTURE:	BRIDGE NO. 2 (TH 8) TH 8 (RIVER STREET) URBAN COLLECTOR - FAU 3052 STATE OF VERMONT AGENCY OF TRANS.	DRAWN:	JEB	DATE: 1/5/15
LOCATION:	RUTLAND COUNTY, VT	CHKD:	JER	DATE: 1/10/15
PROJ NO.	BRF 3000 (16)	JOB NO.	597	DWG NO. X11
CUSTOMER:	KUBRICKY CONSTRUCTION, CORP.	REV.		

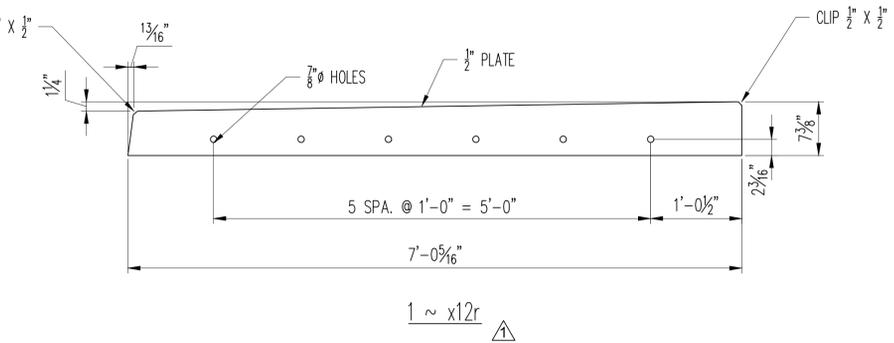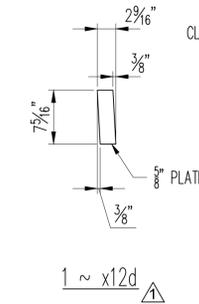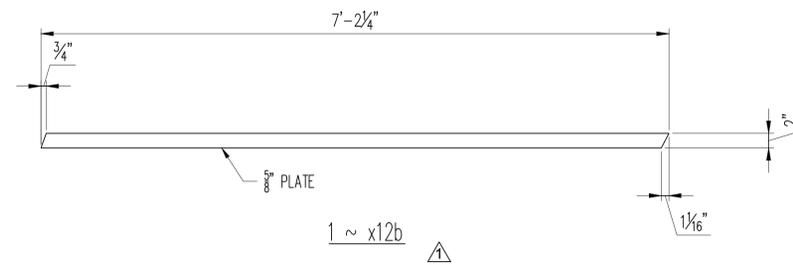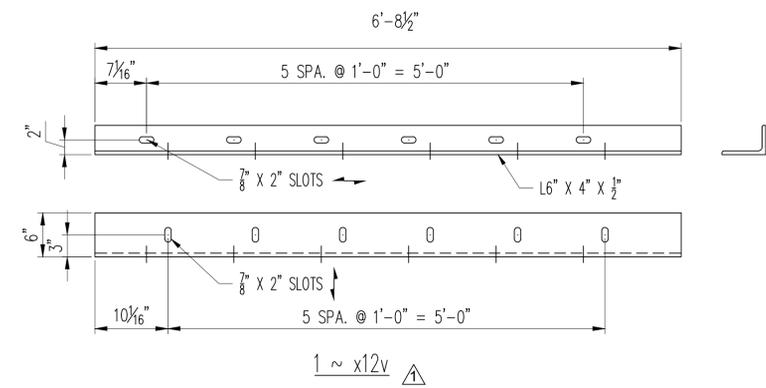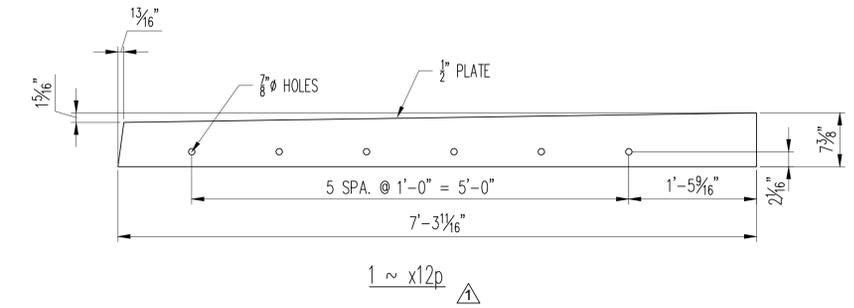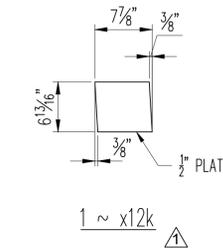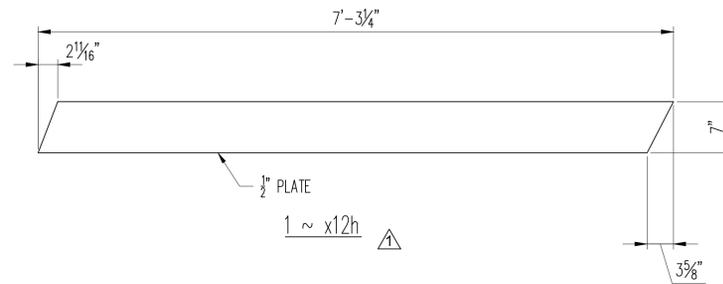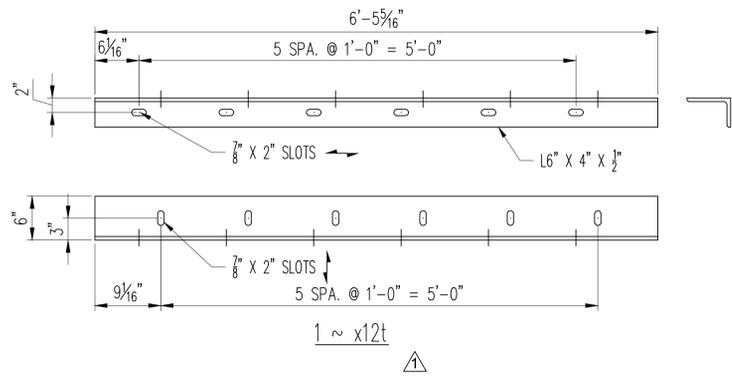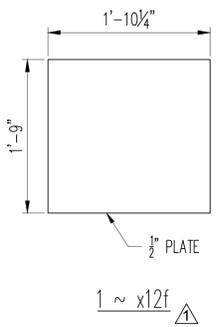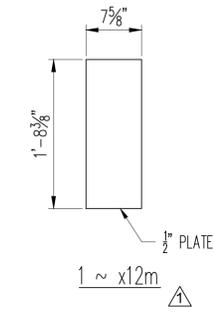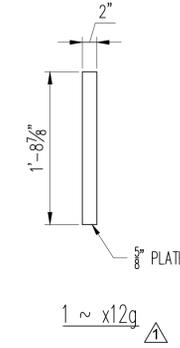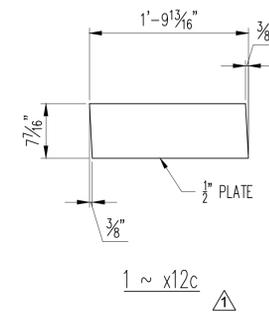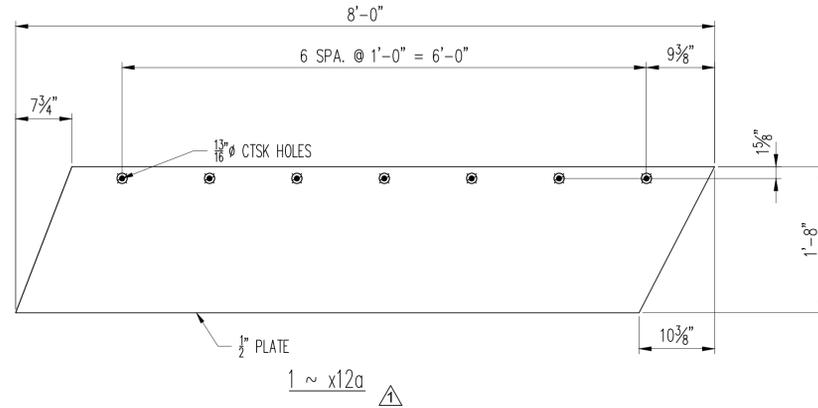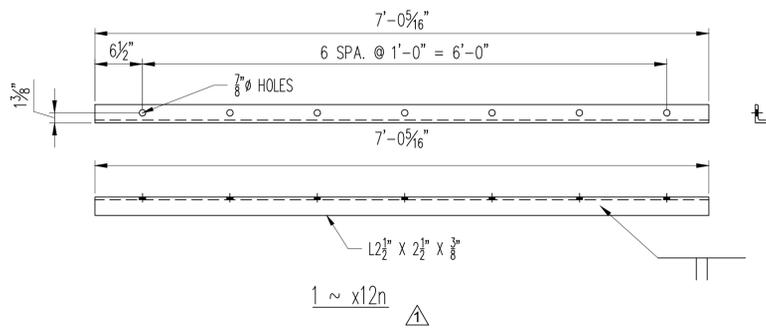

Vermont Agency of Transportation  
**RECEIVED**  
CK'D BY MEM OK'D BY  
Apr. 03, 2015  
RESUBMIT  
BY C. Carlson DATE 04-14-2015

REV.	DATE	REMARKS	DWN	CHK	APVL	SHOP
	3/4/15	PER APPROVAL	JEB	JER		
MATERIAL:		SURFACE PREP. & PAINT:	HOLES:		SHOP BOLTS:	
M270M-250 U.N.O.		GALV. - PER STD. 726.08	AS NOTED		AS NOTED	
DESCRIPTION: EXPANSION JOINT - DETAIL SHEET						
CASCO BAY STEEL STRUCTURES, INC.						
1 WALLACE AVE. PHONE (207) 780-6722						
SOUTH PORTLAND, ME 04106 FAX. (207) 780-6726						
STRUCTURE: BRIDGE NO. 2 (TH 8) TH 8 (RIVER STREET) URBAN COLLECTOR - FAU 3052 STATE OF VERMONT AGENCY OF TRANS.			DRAWN:	DATE:		
			JEB	1/5/15		
			CHKD:	DATE:		
			JER	1/10/15		
LOCATION: RUTLAND COUNTY, VT			JOB NO.	DWG NO.		
PROJ NO. BRF 3000 (16)			597	X12		
CUSTOMER: KUBRICKY CONSTRUCTION, CORP.				REV. 1		

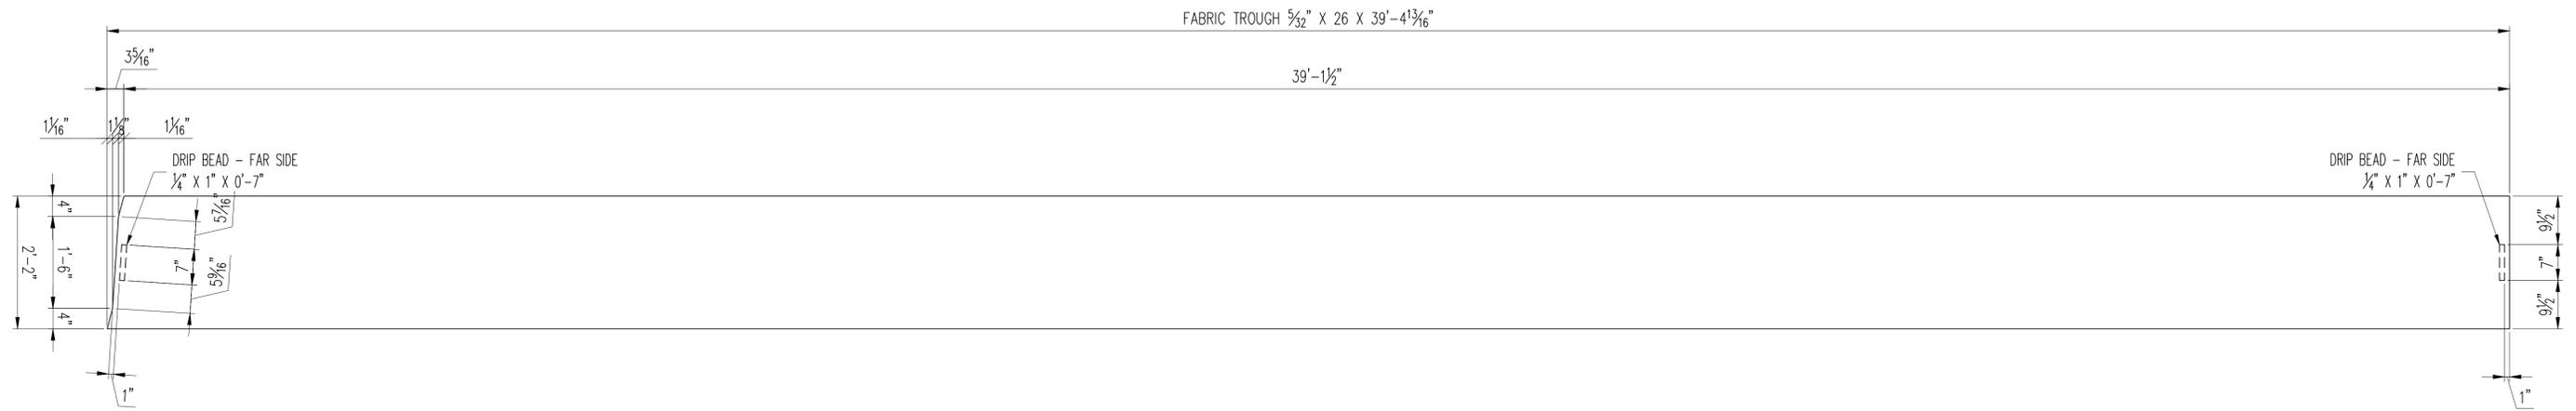

- 1 ~ x13a  $\Delta$
- 1.) FABRIC TROUGH SHALL BE 3-PLY PREFORMED FABRIC MATERIAL CONFORMING TO SECTION 707.07 AND SHALL BE CUT PRE-ASSEMBLY FROM ONE PIECE.
  - 2.) DRIP BEAD OF FABRIC MATERIAL SHALL BE CEMENTED TO THE BOTTOM OF THE FABRIC TROUGH.

Vermont Agency of Transportation  
**RECEIVED**  
 CK'D BY MEM OK'D BY  
 Apr. 03, 2015  
 RESUBMIT X  
 BY C. Carlson DATE 04-14-2015

$\Delta$	3/4/15	PER APPROVAL	JEB	JER		
REV.	DATE	REMARKS	DWN	CHK	APVL	SHOP
MATERIAL:	M270M-250 U.N.O.	SURFACE PREP. & PAINT: GALV. - PER STD. 726.08	HOLES: AS NOTED	SHOP BOLTS: AS NOTED		
DESCRIPTION: EXPANSION JOINT - DETAIL SHEET						
CASCO BAY STEEL STRUCTURES, INC. 1 WALLACE AVE. PHONE (207) 780-6722 SOUTH PORTLAND, ME 04106 FAX. (207) 780-6726						
STRUCTURE:	BRIDGE NO. 2 (TH 8) TH 8 (RIVER STREET) URBAN COLLECTOR - FAU 3052 STATE OF VERMONT AGENCY OF TRANS.			DRAWN:	JEB	DATE: 1/5/15
				CHKD:	JER	DATE: 1/10/15
LOCATION:	RUTLAND COUNTY, VT			JOB NO.	597	DWG NO. X13
PROJ NO.	BRF 3000 (16)					REV. $\Delta$
CUSTOMER:	KUBRICKY CONSTRUCTION, CORP.					



The Chemical Company

suggest replacing this coating with Galvagrit or SlipNOT coating as they are much more durable coatings

PRODUCT DATA

7 07 18 00 Traffic Coatings

# TRAFICGUARD® EP35

Rapid-setting, epoxy-based concrete overlay system

### Description

Trafficguard® EP35 is a rapid-curing, skid-resistant, epoxy-based concrete overlay system. When mixed with aggregate it can be used as a repair mortar.

### Yield

Parking Decks: 40 - 60 ft<sup>2</sup>/gallon (1.0 - 1.5 m<sup>2</sup>/L), depending on porosity and profile of substrate

Bridge Decks: 20 - 40 ft<sup>2</sup>/gallon (0.5 - 1.0 m<sup>2</sup>/L), depending on porosity and profile of substrate

80 ft<sup>2</sup>/gallon (1.96 m<sup>2</sup>/L) as a primer for epoxy binder

Binder yield varies depending on mix ratio (aggregate to epoxy) and aggregate size and gradation. A 3 to 1 ratio will yield approximately 650 in<sup>3</sup>.

### Packaging

10 gallon (38 L) kits

110 gallon (412 L) kits

### Color

Blonde

### Shelf Life

2 years when properly stored

### Storage

Store in unopened containers at 60 to 80° F (16 to 27° C) in clean, dry conditions.

### Features

- Rapid strength development
- Waterproof
- Low modulus
- 90% lighter than typical concrete overlays
- Excellent adhesion to the substrate
- Skid-resistant
- 1 to 1 mix ratio by volume
- Produces a durable surface
- No primer required
- 100% solids

### Benefits

- Minimizes traffic disruption
- Prevents chloride ion contamination, freeze-thaw damage, and salt scaling
- Accommodates thermal movement in the substrate
- Limits dead load in suspended structures
- Prevents delamination extending surface life
- Increased safety for vehicles and pedestrians
- Simplifies application
- Increased service life
- Faster installation
- VOC-compliant system meets all federal regulations

### Where to Use

#### APPLICATION

- Parking decks and ramps
- Bridge decks
- Steel decks
- Warehouse floors
- Elevated airport runways
- As a lightweight alternative to concrete overlays
- When rapid overlay installation and quick turnaround times are required
- As a skid-resistant coating
- Balconies

#### LOCATION

- Horizontal surfaces
- Interior and exterior

#### SUBSTRATE

- Concrete
- Steel

### How to Apply

#### Surface Preparation

##### STEEL

Shotblast steel substrates and clean to meet the requirements of SSPC-SP10, with a minimum 4 mil (0.2 mm) profile. If flash rust appears, the surface must be reblasted.

##### CONCRETE

1. The concrete surface should be clean, dry, and free of oil, contaminants, laitance, and debris, and fully cured for 28 days.
2. Patch or repair deck delaminations and spalls and cracks with the appropriate MBT® repair product and allow to cure.
3. Mechanically prepare the surface to expose coarse aggregate and remove all loose materials. Meet the requirements of ICRI Guideline No. 03732 Standard CSP 6. To ensure proper surface preparation, perform "direct tension" testing (in accordance with ACI 503 Appendix A) every 4,500 ft<sup>2</sup> (414 m<sup>2</sup>).

Vermont Agency of Transportation  
**RECEIVED**  
 CK'D BY MEM OK'D BY  
 Apr. 03, 2015  
 RESUBMIT X  
 BY C. Carlson DATE 04-14-2015



## Technical Data

### Composition

Traficguard® EP35 is a two component epoxy-based binder.

### Test Data

PROPERTY	RESULTS	TEST METHODS
<b>Mix ratio</b> , by volume	1 to 1	
<b>Viscosity</b> , poise, at 75° F (24° C); #3 spindle at 20 rpm	20 – 25	ASTM D 2393
<b>Gel time</b> , min, at 72° F (22° C); (Modified to test 70 g sample)	15 – 20	ASTM C 881
<b>Compressive strength</b> , psi (MPa) 24 hrs 7 days	4,000 – 4,500 6,500 – 7,000	ASTM D 695
<b>Compressive strength</b> , psi (MPa) Mixed with aggregate 3 hrs 24 hrs	3,000 – 3,500 5,000 – 5,500	ASTM C 579
<b>Modulus of Elasticity in Compression</b> , psi (MPa)	1.21 x 10 <sup>5</sup> (834)	ASTM C 695
<b>Tensile strength</b> , psi (MPa), at 7 days	6,525	ASTM D 638
<b>Tensile elongation</b> , %, at 7 days	>30	ASTM D 638
<b>Adhesion Pull Test</b> 24 hrs	>536 psi (break in concrete)	ASTM D 7234 (ACI 503 Appendix A)
<b>Hardness</b> Shore D @ 7 days	62	ASTM D 2240
<b>Abrasion - Taber</b> 1000 cycles - CS 17 wheel	70 mg (neat) 77 mg (with aggregate)	ASTM D 4060
<b>Thermal compatibility</b> 5 cycles Modified: 8 hours @ 60°C plus 16 Hours @ -21°C	Pass	ASTM C 884
<b>Water absorption</b> , % 24 hrs	0.02	ASTM D 570
<b>Rapid Chloride Permeability</b> Chloride ion penetration @ 28 days	0 negligible	ASTM C1202 (AASHTO T277)

All application and performance values are typical for the material, but may vary with test methods, conditions, and configurations.

### Mixing

1. Thoroughly mix each separate component for 2 – 3 minutes.
2. Mix Part A (resin) and Part B (hardener) in the proper ratio (1 to 1 by volume), using a slow-speed drill (500 rpm) and paddle for 2 – 3 minutes.
3. Because of the quick cure rate of this product, do not mix more material usable within the pot life of 15 minutes at 75° F (24° C). Elevated temperatures decrease pot life, and reduced temperatures increase pot life.

### BROADCAST-AGGREGATE METHOD PARKING DECKS

1. Spread the mixed Traficguard® EP35 onto the substrate with a notched squeegee at a rate of 60 ft<sup>2</sup>/gallon (1.0 m<sup>2</sup>/L). Place the epoxy to permit a continuous operation by applying the second mix immediately behind the first mix.
2. Begin the aggregate broadcast immediately, but stop to maintain a wet edge. Broadcast Dynagrip Aggregate # 9 to complete saturation (approximately 1.1 lb/ft<sup>2</sup> (5.4 kg/m<sup>2</sup>). If wet spots develop, immediately broadcast additional aggregate until a dry surface is re-established.

3. Apply the second coat in the same manner described above at a rate of 40-60 ft<sup>2</sup>/gal. The maximum recoat window is 24 hours.

### BRIDGE DECKS

1. If the application takes place early in the evening, the deck may be opened to traffic early the next morning.
2. Spread the mixed Traficguard® EP35 onto the substrate with a notched squeegee at a rate of 40 ft<sup>2</sup>/gallon (1.0 m<sup>2</sup>/L) or 2.5 gallons/100 ft<sup>2</sup>. Place the epoxy to permit a continuous operation by applying the second mix immediately behind the first mix.

3. Begin the aggregate broadcast immediately, but stop to maintain a wet edge. Broadcast Dynagrip Aggregate #8 or #9 to complete saturation (approximately 1.1 lb/ft<sup>2</sup> (5.4 kg/m<sup>2</sup>). If wet spots develop, immediately broadcast additional aggregate until a dry surface is re-established.

4. Apply the second coat in the same matter but at a rate of 20 ft<sup>2</sup>/gallon (2 m<sup>2</sup>/L) or 80 mils. The maximum recoat window is 24 hours.

**EPOXY BINDER**

1. Mix the 2 components of Traficguard® EP35 using the recommended procedures under the Mixing section.

2. Slowly add up to 5 parts by volume of oven-dried sand to 1 part of mixed epoxy.

3. For larger applications, a paddle-type (mortar) mixer may be used. However, the A and B components must first be mixed together using a slow-speed drill as outlined previously.

4. For epoxy concrete applications, consult your local BASF representative.

5. Prime the area to receive the epoxy mortar using neat resin (parts A and B mixed but with no aggregate). Some applications, e.g., paving dams, will require forming to prevent the material from slumping into the joint.

6. Place the epoxy mortar into the repair area and level with a trowel or float. Excess working of the surface will bring resin to the top, which will create a slick finish when cured. To prevent this, broadcast aggregate to refusal onto leveled surface.

7. Allow time for sufficient curing before removing forms, if applicable.

**HOT-WEATHER APPLICATION**

1. In hot weather, precondition materials to 65 to 70° F before mixing and applying.

2. Continuous mixes of 30 gallons can be mixed every 3 minutes but must be dumped within 6 minutes, be spread within 10 minutes of placement, and broadcast within 20 minutes.

**COOL-WEATHER APPLICATION**

1. Application can proceed in temperatures as low as 50° F (10° C). Condition all components to 80 to 100° F (27 to 38° C) before mixing and applying.

2. At 50° F (10° C), a hand-operated surface roller may become necessary to ensure the aggregate penetrates the cool resin.

**Drying Time**

**PRODUCT AND SUBSTRATE**

TEMPERATURE, ° F (° C)	OPEN TO TRAFFIC, MIN*
60 (16)	210
65 (18)	195
70 (21)	180
80 (27)	150
90 (32)	120
100 (38)	90

\*Times are typical for the material but may vary with ambient conditions

**Aggregate**

Dynagrip Aggregate is recommended with Traficguard® EP35 polymer concrete overlay.

Dynagrip Aggregate is a hard-wearing, angular, dark-gray aggregate.

- Dynagrip Aggregate #8 is a coarser aggregate suitable for bridge decks and other surfaces.
- Dynagrip Aggregate #9 is a less coarse aggregate.

Alternatively, an angular shaped silica or basalt aggregate may be used. The aggregate shall be an angular-shaped silica with Mohs scale hardness of 7 or greater or basalt with a hardness of 6 or greater. The alternate aggregate must be clean, dry (less than 0.2% moisture), and conform to the following gradation.

**PERCENT, BY WEIGHT, PASSING IN INDICATED U.S. STANDARD-SIEVE SERIES**

COARSE AGGREGATE				
Sieve #	4	8	16	30
% Passing	100	30 – 75	0 – 5	0 – 1

**Clean Up**

Clean tools and equipment with xylene immediately after using. Wash hands and skin with soap or industrial hand cleaner, not with solvent. Cured material must be removed mechanically.

**For Best Performance**

- Precondition all components to 70° F (21° C) for 24 hours before using.
- Minimum ambient, surface, aggregate and epoxy temperature should be 50° F (10° C) and rising at the time of application.
- Do not apply when rain is expected within 12 hours.
- Finished product is a vapor barrier and should not be applied to on-grade slabs subject to exterior service conditions or other structures where moisture-vapor transmission is a concern.
- Do not use neat (without aggregate).
- Make certain the most current versions of product data sheet and MSDS are being used; call Customer Service (1-800-433-9517) to verify the most current version.
- Proper application is the responsibility of the user. Field visits by BASF personnel are for the purpose of making technical recommendations only and not for supervising or providing quality control on the jobsite.

## Health and Safety

### TRAFICGUARD EP35 PART A

#### Warning

Traficguard EP35 Part A contains Epoxy resin (25068-38-6); Oxirane, mono [(C12-14-alkyloxy)methyl] derivs. (68609-97-2)

#### Risks

SENSITIZER. IRRITANT. May cause allergic skin reaction. May cause skin, eye and respiratory irritation. Ingestion may cause irritation.

#### Precautions

Use only with adequate ventilation. Avoid contact with skin, eyes and clothing. Keep container closed when not in use. Wash thoroughly after handling. DO NOT take internally. Use impervious gloves, eye protection and if the TLV is exceeded or used in a poorly ventilated area, use NIOSH/MSHA approved respiratory protection in accordance with applicable Federal, state and local regulations.

#### First Aid

In case of eye contact, flush thoroughly with water for at least 15 minutes. In case of skin contact, wash affected areas with soap and water. If irritation persists, SEEK MEDICAL ATTENTION. Remove and wash contaminated clothing. If inhalation causes physical discomfort, remove to fresh air. If discomfort persists or any breathing difficulty occurs or if swallowed, SEEK IMMEDIATE MEDICAL ATTENTION.

Refer to Material Safety Data Sheet (MSDS) for further information.

#### Proposition 65

This product contains material listed by the state of California as known to cause cancer, birth defects, or other reproductive harm.

#### VOC Content

0 g/L or 0 lbs/gal less water and exempt solvents when components are mixed and applied per BASF instructions.

### TRAFICGUARD EP35 PART B

#### Danger—Corrosive

Traficguard EP35 Part B contains 4-nonylphenol, branched (84852-15-3); Polyetherdiamine (9046-10-0); 2,4,6-tris-(dimethylaminomethyl)-phenol (90-72-2); 1,3-Cyclohexanedimethanamine (2579-20-6)

#### Risks

CORROSIVE. Causes burns. Corrosive to eyes. Harmful if inhaled or swallowed.

#### Precautions

DO NOT get in eyes, on skin or clothing. Wash thoroughly after handling. Keep container closed. DO NOT take internally. Use only with adequate ventilation. DO NOT breathe vapors. Use impervious gloves, eye protection and if the TLV is exceeded or used in a poorly ventilated area, use NIOSH/MSHA approved respiratory protection in accordance with applicable Federal, state and local regulations.

#### First Aid

In case of eye contact, flush thoroughly with water for at least 15 minutes. In case of skin contact, wash affected areas with soap and water. If irritation persists, SEEK MEDICAL ATTENTION. Remove and wash contaminated clothing. If inhalation causes physical discomfort, remove to fresh air. If discomfort persists or any breathing difficulty occurs or if swallowed, SEEK IMMEDIATE MEDICAL ATTENTION.

Refer to Material Safety Data Sheet (MSDS) for further information.

#### Proposition 65

This product contains materials listed by the State of California as known to cause cancer, birth defects or other reproductive harm.

#### VOC Content

0 g/L or 0 lbs/gal less water and exempt solvents when components are mixed and applied per BASF instructions.

**For medical emergencies only,  
call ChemTrec (1-800-424-9300).**

## BASF Corporation Building Systems

Valley Park Drive  
Bloomington, MN, 55379

www.BuildingSystems.BASF.com

Customer Service 800-433-9517

Technical Service 800-243-6739



**LIMITED WARRANTY NOTICE** Every reasonable effort is made to apply BASF exacting standards both in the manufacture of our products and in the information which we issue concerning these products and their use. We warrant our products to be of good quality and will replace or, at our election, refund the purchase price of any products proved defective. Satisfactory results depend not only upon quality products but also upon many factors beyond our control. Therefore, except for such replacement or refund, BASF MAKES NO WARRANTY OR GUARANTEE, EXPRESS OR IMPLIED, INCLUDING WARRANTIES OF FITNESS FOR A PARTICULAR PURPOSE OR MERCHANTABILITY RESPECTING ITS PRODUCTS, and BASF shall have no other liability with respect thereto. Any claim regarding product defect must be received in writing within one (1) year from the date of shipment. No claim will be considered without such written notice or after the specified time interval. User shall determine the suitability of the products for the intended use and assume all risks and liability in connection therewith. Any authorized change in the printed recommendations concerning the use of our products must bear the signature of the BASF Technical Manager.

This information and all further technical advice are based on BASF's present knowledge and experience. However, BASF assumes no liability for providing such information and advice including the extent to which such information and advice may relate to existing third party intellectual property rights, especially patent rights. In particular, BASF disclaims all CONDITIONS AND WARRANTIES, WHETHER EXPRESS OR IMPLIED, INCLUDING THE IMPLIED WARRANTIES OF FITNESS FOR A PARTICULAR PURPOSE OR MERCHANTABILITY. BASF SHALL NOT BE RESPONSIBLE FOR CONSEQUENTIAL, INDIRECT OR INCIDENTAL DAMAGES (INCLUDING LOSS OF PROFITS) OF ANY KIND. BASF reserves the right to make any changes according to technological progress or further developments. It is the customer's responsibility and obligation to carefully inspect and test any incoming goods. Performance of the product(s) described herein should be verified by testing and carried out only by qualified experts. It is the sole responsibility of the customer to carry out and arrange for any such testing. Reference to trade names used by other companies is neither a recommendation, nor an endorsement of any product and does not imply that similar products could not be used.

**For professional use only. Not for sale to or use by the general public.**

Form No. 1018986 6/11  
Printed on recycled paper including 10% post-consumer fiber.

© 2011 BASF  
Printed in U.S.A.

# Casco Bay Steel Structures, Inc.

## WELDING PROCEDURE SPECIFICATION

Material specification ASTM Gr. 50 + G-50W  
 Welding process Gas Metal ARC welding (CG-MAW)  
 Manual or machine Semi AUTO  
 Position of welding Flat + Horizontal  
 Filler metal specification AWS-A5.28  
 Filler metal classification E80C-Nil ESAB  
 Flux NA  
 Shielding gas 90% AR / 10% Co<sup>2</sup> Flow rate 35CFH + 1/4 Elec. StickOut 5/8  
 Single or multiple pass single & multiple  
 Single or multiple arc Single  
 Welding current DC  
 Polarity DCEP  
 Welding progression See Detail  
 Root treatment Blast Clean - wire Brush - Area To be Free of slag - RUST - Moisture  
 Preheat and interpass temperature See Table and as Required  
 Postheat temperature AS Required  
 Heat Input Min 24.4 KJ/in Max 38.3 KJ/m P.Q.R. 418-FCM=34.8 KJ/in  
 \* 35.0 KJ/in Min for single pass  
 Minimum Preheat and Interpass Temperature, °C [°F]

RECEIVED  
 Vermont Agency of Transportation  
 MEM OK'D BY  
 Apr. 03, 2015  
 RESUBMIT BY C. Carlson  
 DATE 04-14-2015

Welding Process (Base Metal)	Thickness of Thickest Part at Point of Welding, mm [in]			
	To 20 mm [3/4 in] Incl.	Over 20 mm [3/4 in] to 40 mm [1-1/2 in] Incl.	Over 40 mm [1-1/2 in] to 65 mm [2-1/2 in] Incl.	Over 65 mm [2-1/2 in]
SAW; GMAW; FCAW; SMAW (M270M [M270] [A 709M (A 709)])	10 [50]	20 [70]	65 [150]	110 [225]
	150 <sup>°F</sup>	200 <sup>°F</sup>	225 <sup>°F</sup>	325 <sup>°F</sup>
	150 <sup>°F</sup>	250 <sup>°F</sup>	325 <sup>°F</sup>	350 <sup>°F</sup>

Preheats to the NYSSCM

	Gr 50	Gr 50W
to 3/4	50F	100F
over 3/4 to 1-1/2	70F	200F
over 1-1/2 to 2-1/2	150F	300F
over 2-1/2	225	350F

There are 3 sets of pre-heat temps, shouldn't 2 of these be removed?

FCM Gr 50  
FCM Gr 50W

Max Interpass 440

Pass no.	Electrode size	Welding current		Travel speed	Joint detail
		Amperes	Volts		
	.052	307	29.2	15.5	2F
		338.7	31	17.5	
REQ	.052	276.3	27	13.5	1F
* 1 Pass	.052	338.7 to 281.3	31 to 28.0	17.5 to 13.5	

Sec 5.12.4.2  
AWS D1.5

FCM??

This procedure may vary due to fabrication sequence, fit-up, pass size, etc., within the limitation of variables given in applicable A.W.S. codes or contract specifications

Procedure no. FCM 610 Contractor Casco Bay Steel  
 Revision no. \_\_\_\_\_ Authorized By Paul E. Goodale  
 Date 8-1-2013

# Casco Bay Steel Structures, Inc.

## WELDING PROCEDURE SPECIFICATION


Material specification ASTM Gr. 50 + 50W  
 Welding process Gas Metal Arc welding (GMAW)  
 Manual or machine Semi AUTO  
 Position of welding Flat + Horizontal  
 Filler metal specification AWS-A5-28  
 Filler metal classification E80C-Ni ESAB  
 Flux NA  
 Shielding gas 90% AR / 10% CO<sub>2</sub> Flow rate 35 CFH +/- 4, Elec. STICKOUT 5/8  
 Single or multiple pass Single or Multiple  
 Single or multiple arc Single  
 Welding current DC  
 Polarity DC EP  
 Welding progression See Detail  
 Root treatment Blast Clean - Wire Brush - Area to be free of Slag - Rust - Moisture  
 Preheat and interpass temperature See Table  
 Postheat temperature As Required  
 Heat Input Min 24.4 kJ/in Max 38.3 kJ/in PQR # 418-FCM = 34.8 kJ/in

Vermont Agency of Transportation  
**RECEIVED**  
 CK'D BY MEM OK'D BY  
 Apr. 03, 2015  
 RESUBMIT BY C. Carlson DATE 04-14-2015

Minimum Preheat and Interpass Temperature, °C [°F]


Welding Process (Base Metal)	Thickness of Thickest Part at Point of Welding, mm (in)				Preheats to the NYSSCM
	To 20 mm [3/4 in] Incl.	Over 20 mm [3/4 in] to 40 mm [1-1/2 in] Incl.	Over 40 mm [1-1/2 in] to 65 mm [2-1/2 in] Incl.	Over 65 mm [2-1/2 in]	
SAW; GMAW; FCAW; SMAW (M270M [M270] [A 709M (A 709)] Gr. 250 [36], 345 [50], 345W [50W], HPS 345W [HPS 50W])	10 [50]	20 [70]	65 [150]	110 [225]	to 3/4 Gr. 50 Gr 50W 50F 100F
SAW; GMAW; FCAW; SMAW (M270M [M270] [A 709M (A 709)] Gr. HPS 485W [HPS 70W], 690 [100], 690W [100W])	10 [50]	50 [125]	80 [175]	110 [225]	over 3/4 to 1-1/2 70F 200F over 1-1/2 to 2-1/2 150F 300F over 2-1/2 225F 350F

Are these for New York??

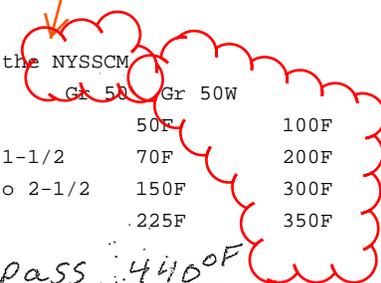

### WELDING PROCEDURE

Pass no.	Electrode size	Welding current		Travel speed	Notes
		Amperes	Volts		
AS REQ	.052	307	29.2	15.5	See 5.12.4.2 For Secondary Material Joint detail B-UZ-GF Max Interpass 440°F AWS D1-5
		338.7	31	17.5	
		To 276.3	To 27	To 13.5	

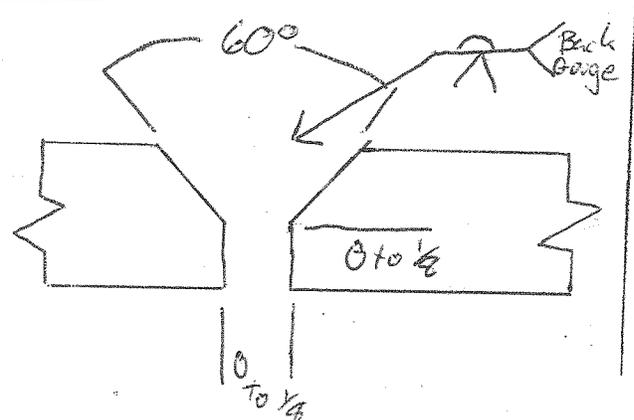

This procedure may vary due to fabrication sequence, fit-up, pass size, etc., within the limitation of variables given in applicable A.W.S. codes or contract specifications

Procedure no. 613 Contractor Casco Bay Steel Structures  
 Revision no. \_\_\_\_\_ Authorized By [Signature]  
 Date 12/17/14