
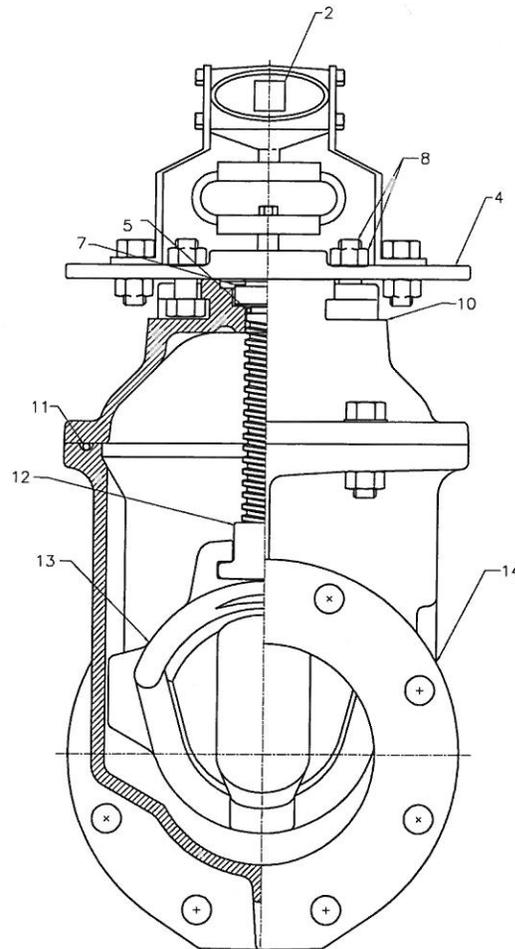


Complies with applicable requirements of AWWA C509

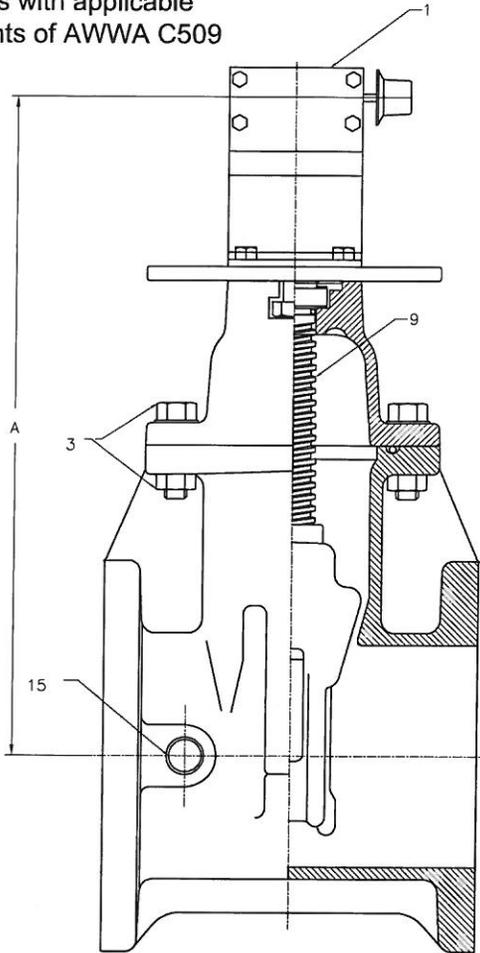

ITEM	DESCRIPTION	MATERIAL
1	Mitre Box	-----
2	Operating Nut	Cast Iron ASTM A126 Class B
3	Hex Head Bolts & Nuts	Stainless Steel ASTM F593C/F594
4	Indicator Post Plate	Cast Iron ASTM A126 Class B
5	Stem O-Ring	Buna N
6	Indicator Post Plate O-Ring	Buna N
7	Thrust Washer Bearing	Delrin
8	Hex Head Bolts & Nuts	Stainless Steel ASTM F593C
9	Stem	Bronze ASTM B584 C86700
10	Cover	Ductile Iron A536 Grade 70-50-05
11	Cover O-Ring	Buna N
12	Stem Nut	Bronze (NDZ) ASTM B763 C99500
13	Wedge	Ductile Iron A536 Grade 70-50-05 and EPDM
14	Body - all types	Ductile Iron A536 Grade 70-50-05
15	Pipe Plug (Optional Some Styles)	Galvanized Steel

Valve Size	A
4	23 5/8"
6	27 7/8"
8	31 3/8"
10	35 3/8"
12	38 7/8"

mechanical joint face instead of flange face?

REPLACES F-61-DI-2-12-OMG-PL

UNLESS OTHERWISE SPECIFIED:		NAME	DATE
CASTING DIM: 0" - 4" +/- 1/32" 4" - 8" +/- 3/64" 8" - 12" +/- 1/16" 12" - 18" +/- 3/32" 18" - UP +/- 1/8" RADII 1/8" DRAFT 2°		N.HOLT	6/17/14
		-	-
		-	-
DO NOT SCALE DRAWING			
MACHINING DIM: DUAL DIM. INCHES[MM] FRACTIONAL ± 1/64 ANGULAR ± .5 RADII ± 1/32" TWO PLACE DECIMAL ± .02 THREE PLACE DECIMAL ± .005	MATERIAL:		
	Weight: LBS		
FINISH: 125 RMS	THE INFORMATION CONTAINED IS THE SOLE PROPERTY OF KENNEDY VALVE CO. ANY REPRODUCTION IN PART OR AS A WHOLE WITHOUT THE WRITTEN PERMISSION OF KENNEDY VALVE CO. IS PROHIBITED. DESIGN & INVENTION RIGHTS RESERVED.		

AMERICAN R/D
PLANT AND INDUSTRIAL GROUP OF KENNEDY VALVE
1021 EAST WATER STREET ELMIRA, NEW YORK 14901

KENNEDY VALVE
Division of McWane, Inc.
1021 EAST WATER STREET ELMIRA, NEW YORK 14901

TITLE:
2-12 INCH RESILIENT WEDGE GATE VALVE
C509 - ALL STYLES - DUCTILE IRON
OPEN MITRE GEAR - PARTS LIST

SIZE A	PART NO.	DWG. NO. CAT910002A	REV -
------------------	-----------------	-------------------------------	-----------------

PROPRIETARY AND CONFIDENTIAL

Vermont Agency of Transportation

RECEIVED

CK'D BY MEM OK'D BY CWC

May 15, 2015

RESUBMIT APPROVED AS NOTED ✓

BY C. Carlson DATE 05-27-2015

SHEET 1 OF 1