




IN ACCORDANCE WITH VTRANS STANDARD SPECIFICATION 522.03, PLEASE VERIFY THE FABRICATOR IS AITC LICENSED AND THAT FABRICATION WILL COMPLY WITH ANSI/AITC A190.1.

STEEL ASSEMBLY BY OTHERS

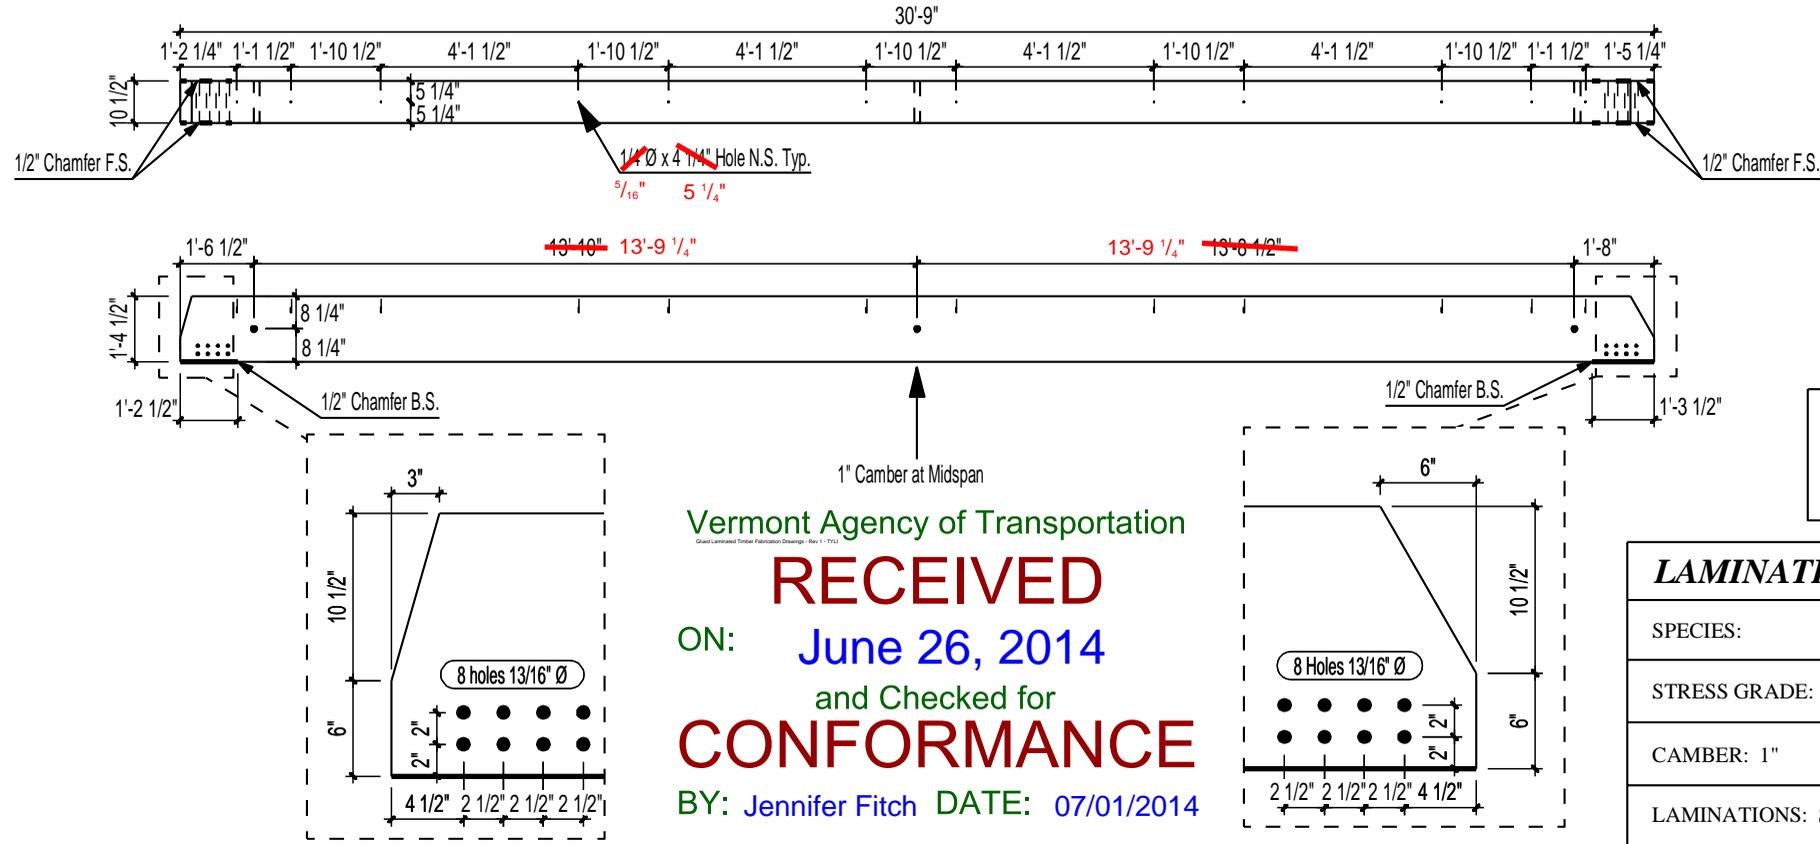

**T.Y. LIN INTERNATIONAL**  
 THE STAMPED DOCUMENTS ARE HEREBY:  
 \_\_\_\_\_ APPROVED  
 \_\_\_\_\_ APPROVED AS NOTED  
 \_\_\_\_\_ X REVISE AND RESUBMIT  
 SEE TRANSMITTAL FOR ADDITIONAL INFORMATION AS APPLICABLE.  
 THIS REVIEW IS FOR GENERAL CONFORMANCE WITH DESIGN CONCEPT ONLY. ANY DEVIATION FROM THE PLANS OR SPECIFICATIONS NOT CLEARLY NOTED BY THE CONTRACTOR HAS NOT BEEN REVIEWED. REVIEW BY THE ENGINEER SHALL NOT RELIEVE THE CONTRACTOR OF THE CONTRACTUAL RESPONSIBILITY FOR ANY ERRORS OR DEVIATION FROM THE CONTRACT REQUIREMENTS.  
 \_\_\_\_\_ JOSH OLUND 07/01/2014  
 REVIEWER DATE

**FOR APPROVAL  
 NOT FOR CONSTRUCTION**

Vermont Agency of Transportation  
**RECEIVED**  
 ON: **June 26, 2014**  
 and Checked for  
**CONFORMANCE**  
 BY: **Jennifer Fitch** DATE: **07/01/2014**

**LAMINATED TIMBER SPECIFICATION**

SPECIES:	SOUTHERN PINE
STRESS GRADE:	26F-1.9E
CAMBER:	1"
LAMINATIONS:	STANDARD 1-3/8"
AS PER ANSI/AITC A 190.1	IN ACCORDANCE W/ AITC 117 - CERTIFIED APA
APPEARENCE GRADE:	INDUSTRIAL
MOISTURE CONTENT OF LAMINATIONS:	MAXIMUM <del>19%</del> <b>16%</b>
ADHESIVE:	COMPLYING TO AITC A 190.1 <b>WET-USE CONFORMING TO ASTM D 2559</b>
LAMINATION LAYUP:	COMPLYING TO AITC 117 ANNEX B TABLE B1

5% OF 302-26 LAMINATES ARE REQUIRED, TOP AND BOTTOM

11 or More Lams 26F-V4			# LAMS
		302-26	
10%	N1D	1:12	
15%	N1D	-	
-	N1M	-	
15%	N1D	-	
10%	N1D	1:12	

Lam splices are random

**Prod: B1**


<b>Glue Laminated Timber Beams 2-7</b>		PRINTED: 25.06.2014	HOLE TYP. U.N.O. 1 1/2" Ø	Qty: 12	Scale: 1/4" = 1'0"	Date: 05-02-2014	<b>Goodfellow inc.</b>
Project: Floating Bridge (Brookfield) No.: 1314-150-U // G-28107 Customer: Wright Construction Co. Inc.	FABRICATION June 25 DATE: _____	Added Holes & Notes REVISION	Stress Grade: 26F-1.9E App. Grade: Industrial Treatment: Preservative Type II Penta Type A 0.60# AWPA Use Category UC4B Commodity 6F	X-section: 10 1/2" / 16-1/2" Length: 30'-9" Material: Southern Pine	By: J.R. Checked: M.R.	225, Goodfellow Street DELSON, QUEBEC, J5B 1V5 Tel.: 450-635-6511 Fax : 450-635-8304 www.goodfellowinc.com	

**RECEIVED**  
 ON: June 26, 2014  
 and Checked for  
**CONFORMANCE**

BY: Jennifer Fitch DATE: 07/01/2014

**STEEL ASSEMBLY BY OTHERS**

**T.Y. LIN INTERNATIONAL**  
 THE STAMPED DOCUMENTS ARE HEREBY:  
 \_\_\_\_\_ APPROVED  
 \_\_\_\_\_ APPROVED AS NOTED  
 \_\_\_\_\_ REVISE AND RESUBMIT  
 SEE TRANSMITTAL FOR ADDITIONAL INFORMATION AS APPLICABLE.  
 THIS REVIEW IS FOR GENERAL CONFORMANCE WITH DESIGN CONCEPT ONLY. ANY DEVIATION FROM THE PLANS OR SPECIFICATIONS NOT CLEARLY NOTED BY THE CONTRACTOR HAS NOT BEEN REVIEWED. REVIEW BY THE ENGINEER SHALL NOT RELIEVE THE CONTRACTOR OF THE CONTRACTUAL RESPONSIBILITY FOR ANY ERRORS OR DEVIATION FROM THE CONTRACT REQUIREMENTS.  
 \_\_\_\_\_ JOSH OLUND 07/01/2014  
 REVIEWER DATE

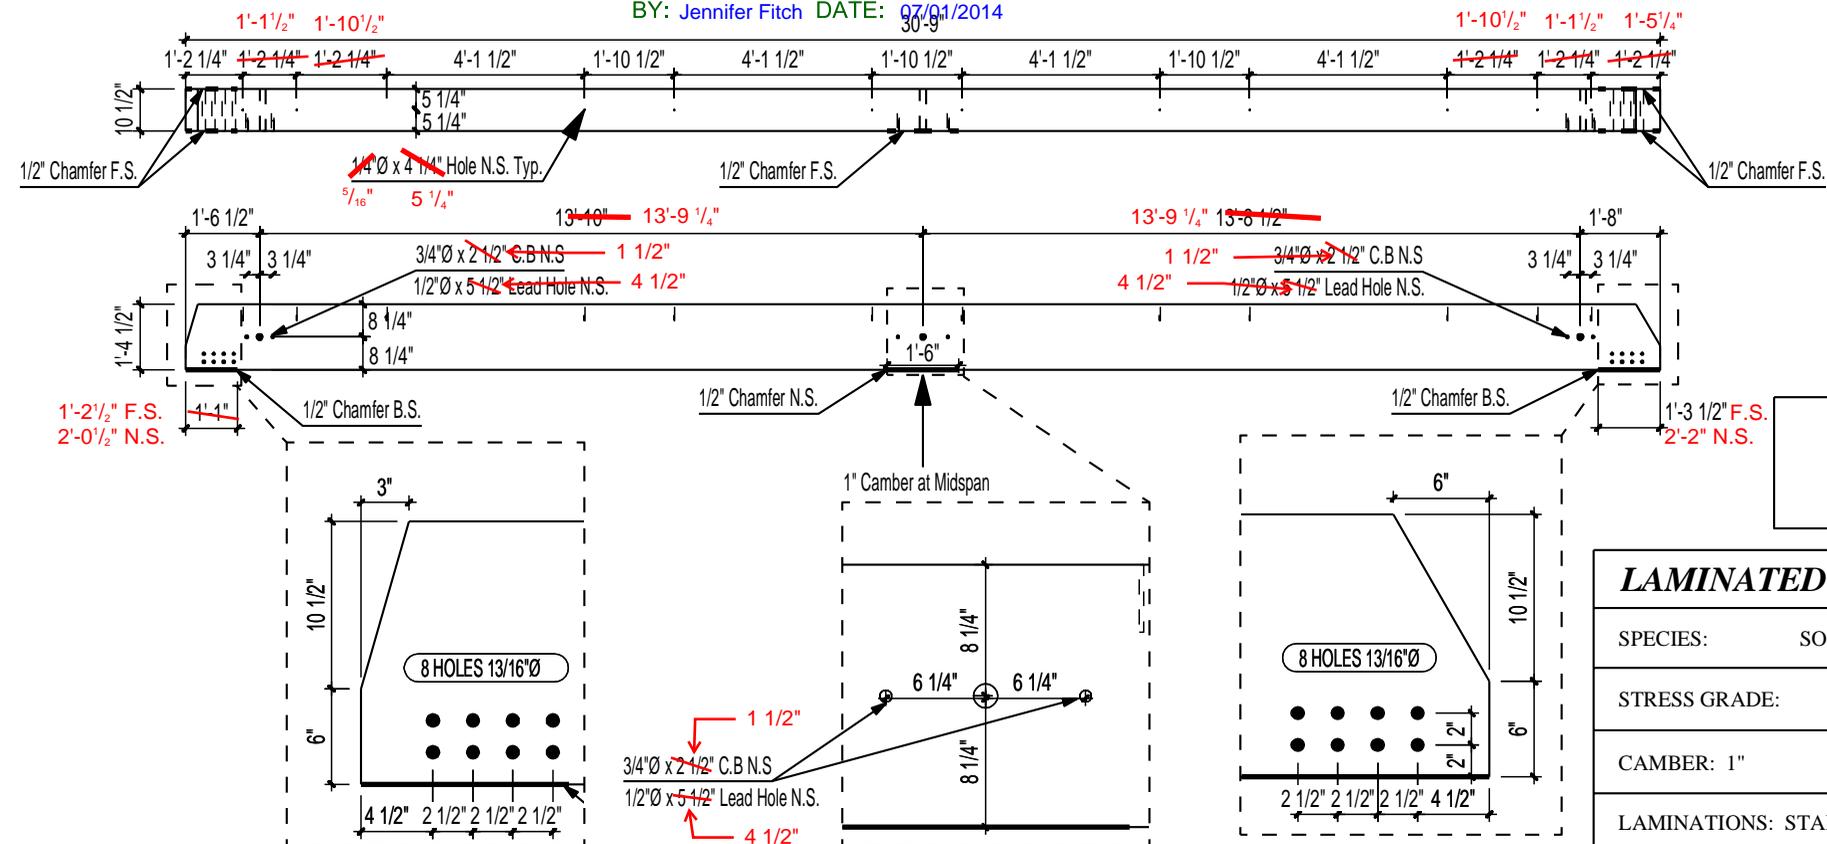

**FOR APPROVAL  
 NOT FOR CONSTRUCTION**

**LAMINATED TIMBER SPECIFICATION**

SPECIES:	SOUTHERN PINE
STRESS GRADE:	26F-1.9E
CAMBER:	1"
LAMINATIONS:	STANDARD 1-3/8"
AS PER ANSI/AITC A 190.1 IN ACCORDANCE W/ AITC 117 - CERTIFIED APA	
APPEARENCE GRADE:	INDUSTRIAL
MOISTURE CONTENT OF LAMINATIONS:	MAXIMUM 19% <b>16%</b>
ADHESIVE:	COMPLYING TO AITC A 190.1, <b>WET-USE CONFORMING TO ASTM D 2559</b>
LAMINATION LAYUP:	COMPLYING TO AITC 117 ANNEX B TABLE B1

5% OF 302-26 LAMINATES ARE REQUIRED, TOP AND BOTTOM

11 or More Lams 26F-V4			# LAMS
302-26			
10%	N1D	1:12	
15%	N1D	-	
-	N1M	-	
15%	N1D	-	
10%	N1D	1:12	

Lam splices are random


**Prod: B2**

<b>Glue Laminated Timber Beam 8</b>		PRINTED: 25.06.2014	HOLE TYP. U.N.O. 1 1/2" Ø	Qty: 2	Scale: 2" = 1'0"	Date: 05-02-2014	<b>Goodfellow inc.</b>
Project: Floating Bridge (Brookfield) No.: 1314-150-U // G-28107 Customer: Wright Construction Co. Inc.	<b>FABRICATION</b>	June 25	Added Holes & Notes	Stress Grade: 26F-1.9E App. Grade: Industrial Treatment: Preservative Type II Penta Type A 0.60# AWPA Use Category UC4B Commodity 6F	X-section: 10 1/2" / 16-1/2" Length: 30'-9" Material: Southern Pine	By: J.R. Checked: M.R.	

225, Goodfellow Street  
 DELSON, QUEBEC, J5B 1V5  
 Tel.: 450-635-6511 Fax : 450-635-8304  
 www.goodfellowinc.com

**RECEIVED**  
 ON: June 26, 2014  
 and Checked for  
**CONFORMANCE**  
 BY: Jennifer Fitch DATE: 07/01/2014

**STEEL ASSEMBLY BY OTHERS**

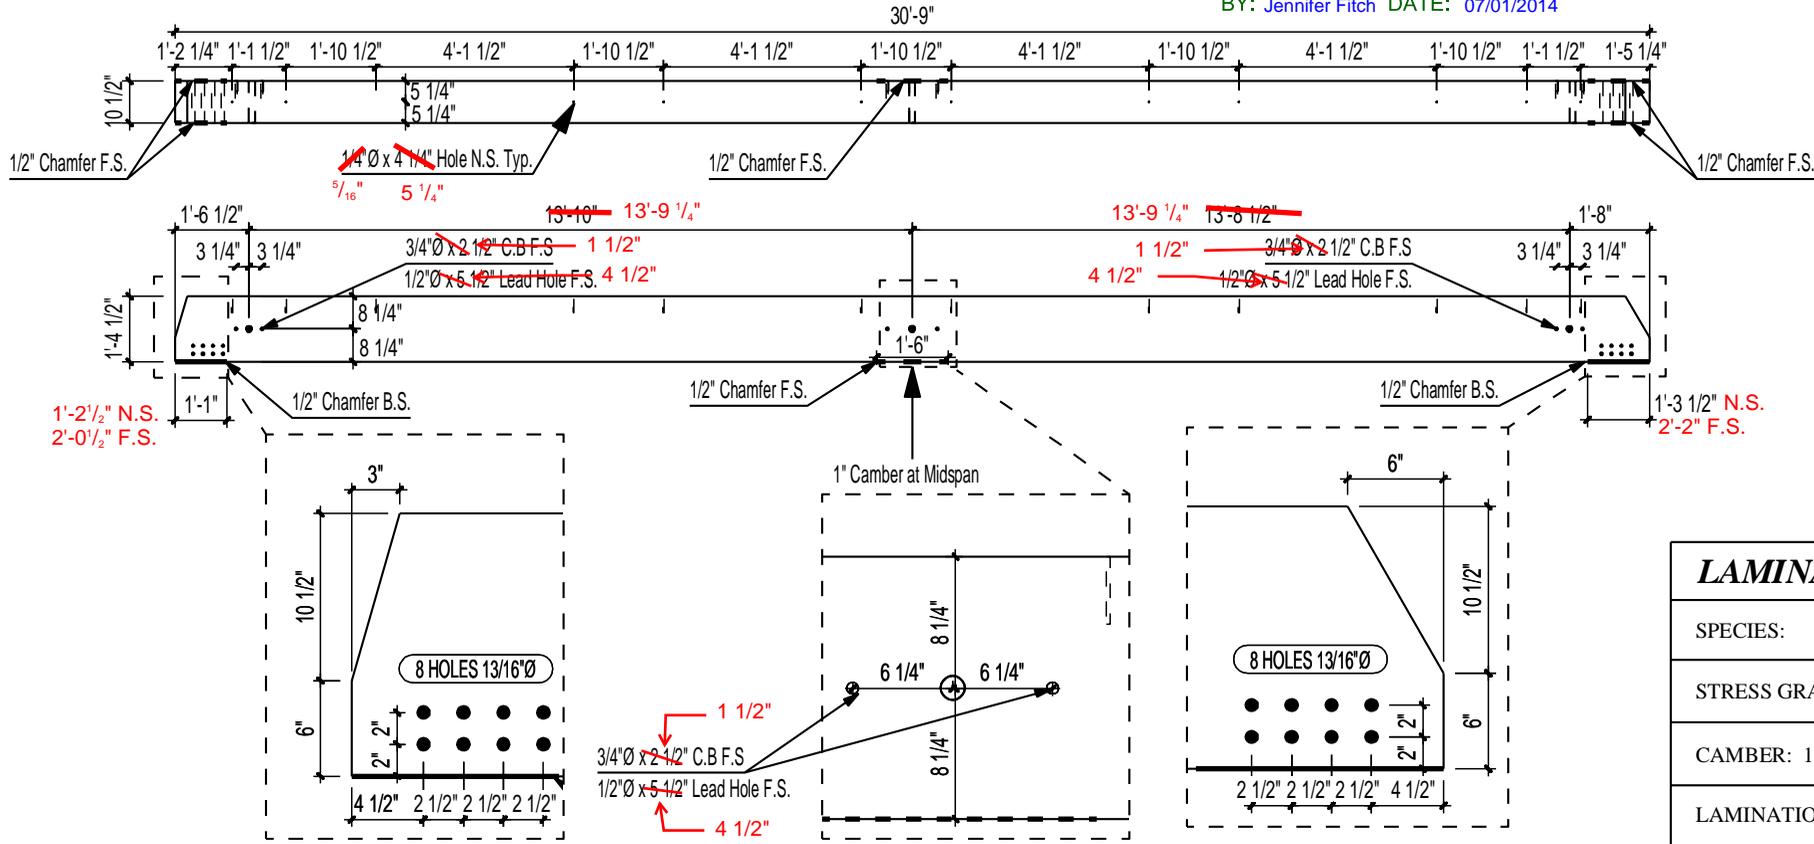

**T.Y. LIN INTERNATIONAL**  
 THE STAMPED DOCUMENTS ARE HEREBY:  
 \_\_\_\_\_ APPROVED  
 \_\_\_\_\_ APPROVED AS NOTED  
 \_\_\_\_\_ X REVISE AND RESUBMIT  
 SEE TRANSMITTAL FOR ADDITIONAL INFORMATION AS APPLICABLE.  
 THIS REVIEW IS FOR GENERAL CONFORMANCE WITH DESIGN CONCEPT ONLY. ANY DEVIATION FROM THE PLANS OR SPECIFICATIONS NOT CLEARLY NOTED BY THE CONTRACTOR HAS NOT BEEN REVIEWED. REVIEW BY THE ENGINEER SHALL NOT RELIEVE THE CONTRACTOR OF THE CONTRACTUAL RESPONSIBILITY FOR ANY ERRORS OR DEVIATION FROM THE CONTRACT REQUIREMENTS.  
 \_\_\_\_\_ JOSH OLUND 07/01/2014  
 REVIEWER DATE

**FOR APPROVAL  
 NOT FOR CONSTRUCTION**

**LAMINATED TIMBER SPECIFICATION**

SPECIES:	SOUTHERN PINE
STRESS GRADE:	26F-1.8E <del>1.9E</del>
CAMBER:	1"
LAMINATIONS:	STANDARD 1-3/8"
AS PER ANSI/AITC A 190.1 IN ACCORDANCE W/ AITC 117 - CERTIFIED APA	
APPEARANCE GRADE:	INDUSTRIAL
MOISTURE CONTENT OF LAMINATIONS:	MAXIMUM <del>10%</del> 16%
ADHESIVE:	COMPLYING TO AITC A 190.1, <b>WET-USE CONFORMING TO ASTM D 2559</b>
LAMINATION LAYUP:	COMPLYING TO AITC 117 ANNEX B TABLE B1

5% OF 302-26 LAMINATES ARE REQUIRED, TOP AND BOTTOM

11 or More Lams 26F-V4			# LAMS
→ 302-26			
10%	N1D	1:12	
15%	N1D	-	
-	N1M	-	
15%	N1D	-	
10%	N1D	1:12	

Lam splices are random

**Prod: B3**




<b>Glue Laminated Timber Beam 1</b>		PRINTED: 25.06.2014	HOLE TYP. U.N.O. 1 1/2" Ø	Qty: 2	Scale: 2" = 1'0"	Date: 05-02-2014	<b>Goodfellow inc.</b>
Project: Floating Bridge (Brookfield) No.: 1314-150-U // G-28107 Customer: Wright Construction Co. Inc.	<b>FABRICATION</b>	June 25	Added Holes & Notes	Stress Grade: 26F-1.9E App. Grade: Industrial Treatment: Preservative Type II Penta Type A 0.60# AWPA Use Category UC4B Commodity 6F	X-section: 10 1/2" / 16-1/2" Length: 30'-9" Material: Southern Pine	By: J.R. Checked: M.R.	
	DATE: / /		REVISION				225, Goodfellow Street DELSON, QUEBEC, J5B 1V5 Tel.: 450-635-6511 Fax : 450-635-8304 www.goodfellowinc.com

**STEEL ASSEMBLY BY OTHERS**

Vermont Agency of Transportation

**RECEIVED**  
 ON: **June 26, 2014**  
 and Checked for  
**CONFORMANCE**

BY: **Jennifer Fitch** DATE: **07/01/2014**

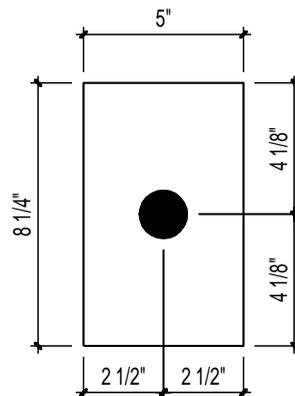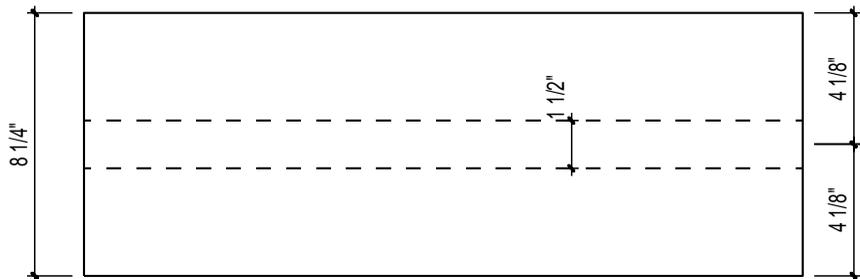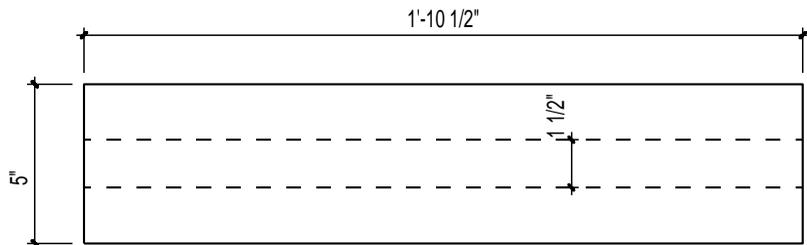

**T.Y. LIN INTERNATIONAL**  
 THE STAMPED DOCUMENTS ARE HEREBY:  
 \_\_\_\_\_ APPROVED  
 \_\_\_\_\_ APPROVED AS NOTED  
 \_\_\_\_\_ X REVISE AND RESUBMIT  
 SEE TRANSMITTAL FOR ADDITIONAL INFORMATION AS APPLICABLE.  
 THIS REVIEW IS FOR GENERAL CONFORMANCE WITH DESIGN CONCEPT ONLY. ANY DEVIATION FROM THE PLANS OR SPECIFICATIONS NOT CLEARLY NOTED BY THE CONTRACTOR HAS NOT BEEN REVIEWED. REVIEW BY THE ENGINEER SHALL NOT RELIEVE THE CONTRACTOR OF THE CONTRACTUAL RESPONSIBILITY FOR ANY ERRORS OR DEVIATION FROM THE CONTRACT REQUIREMENTS.  
 \_\_\_\_\_ JOSH OLUND 07/01/2014  
 REVIEWER DATE

**FOR APPROVAL  
 NOT FOR CONSTRUCTION**

<b>LAMINATED TIMBER SPECIFICATION</b>	
SPECIES:	SOUTHERN PINE
STRESS GRADE:	24F-1.8E
CAMBER:	1"
LAMINATIONS:	STANDARD 1-3/8"
AS PER ANSI/AITC A 190.1 IN ACCORDANCE W/ AITC 117 - CERTIFIED APA	
APPEARANCE GRADE:	INDUSTRIAL
MOISTURE CONTENT OF LAMINATIONS:	MAXIMUM <del>10%</del> 16%
ADHESIVE:	COMPLYING TO AITC A 190.1, <b>WET-USE CONFORMING TO ASTM D 2559</b>
LAMINATION LAYUP:	COMPLYING TO AITC 117 ANNEX B TABLE B1

5% OF 302-20 LAMINATES ARE REQUIRED, BOTTOM

6-8 Lams 24F-V4			# LAMS
302-20 (1:14)			
5%	N1M	1:14	
5%	N1M	-	
-	-	-	
15%	N2M	-	
-	N3C	1:8	
15%	N2M	-	
-	-	-	
20%	N1D	-	

Lam Splices are random

**Prod: B4**

<b>Glue Laminated Timber Diaphragm</b>		PRINTED: 25.06.2014	HOLE TYP. U.N.O. 1 1/2" Ø	Qty: 42	Scale:	Date: 05-02-2014	<b>Goodfellow inc.</b>
Project: Floating Bridge (Brookfield) No.: 1314-150-U // G-28107 Customer: Wright Construction Co. Inc.	FABRICATION ____/____/____	DATE: June 25	Added Notes	Stress Grade: 24F-1.8E App. Grade: Industrial Treatment: Preservative Type II Penta Type A 0.60# AWPA Use Category UC4B Commodity 6F	X-section: 5" / 8 1/4" Length: 1'-10 1/2" Material: Southern Pine	By: J.R. Checked: M.R.	