

MILLER CONSTRUCTION, INC.

P.O. BOX 86 ASCUTNEY BLVD WINDSOR, VERMONT 05089-0086
 TELEPHONE (802) 674-5525 / FAX (802) 674-5245

TRANSMITTAL

TO: Jennifer Fitch, PE Project Manager Vermont Agency of Transportation	DATE	PROJECT NO.
	5/5/2014	Brookfield BRF FLBR (2)

XX WE ENCLOSE THE FOLLOWING: _____ UNDER SEPARATE COVER WE ARE SENDING THE FOLLOWING

COPIES	NUMBER	DESCRIPTION	CODE
1		Glued Laminated Timber Beam Fabrication Drawings - Rev 0	H

- CODE:
- A FOR INITIAL APPROVAL
 - B FOR FINAL APPROVAL
 - C APPROVED AS NOTED-RESUBMISSION REQUIRED
 - D APPROVED AS NOTED-RESUBMISSION NOT REQUIRED
 - E DISAPPROVED-RESUBMIT
 - F QUOTATION REQUESTED
 - G APPROVED
 - H FOR APPROVAL
 - I AS REQUESTED OR REQUIRED
 - J FOR USE IN ERECTION
 - K LETTER FOLLOWS
 - L FOR FIELD CHECK
 - M FOR YOUR USE

BY: Paul J. Allmy

IN ACCORDANCE WITH VTRANS STANDARD SPECIFICATION 522.03, PLEASE VERIFY THE FABRICATOR IS AITC LICENSED AND THAT FABRICATION WILL COMPLY WITH ANSI/AITC A190.1.

PLEASE NOTE THE REQUIREMENTS OF VTRANS STANDARD SPECIFICATIONS 709.03, SPECIFICALLY AS THEY RELATE TO ADHESIVE TYPE AND MOISTURE CONTENT AT THE TIME OF FABRICATION.

PLEASE PROVIDE LAMINATE LAYUP DETAILS INCLUDING GRADES, LOCATIONS, AND SPLICE LOCATIONS OF INDIVIDUAL BOARDS.

T.Y. LIN INTERNATIONAL

THE STAMPED DOCUMENTS ARE HEREBY:


- ____ APPROVED
- ____ APPROVED AS NOTED
- REVISE AND RESUBMIT

SEE TRANSMITTAL FOR ADDITIONAL INFORMATION AS APPLICABLE.

THIS REVIEW IS FOR GENERAL CONFORMANCE WITH DESIGN CONCEPT ONLY. ANY DEVIATION FROM THE PLANS OR SPECIFICATIONS NOT CLEARLY NOTED BY THE CONTRACTOR HAS NOT BEEN REVIEWED. REVIEW BY THE ENGINEER SHALL NOT RELIEVE THE CONTRACTOR OF THE CONTRACTUAL RESPONSIBILITY FOR ANY ERRORS OR DEVIATION FROM THE CONTRACT REQUIREMENTS.

JOSH OLUND
REVIEWER

05/06/2014
DATE

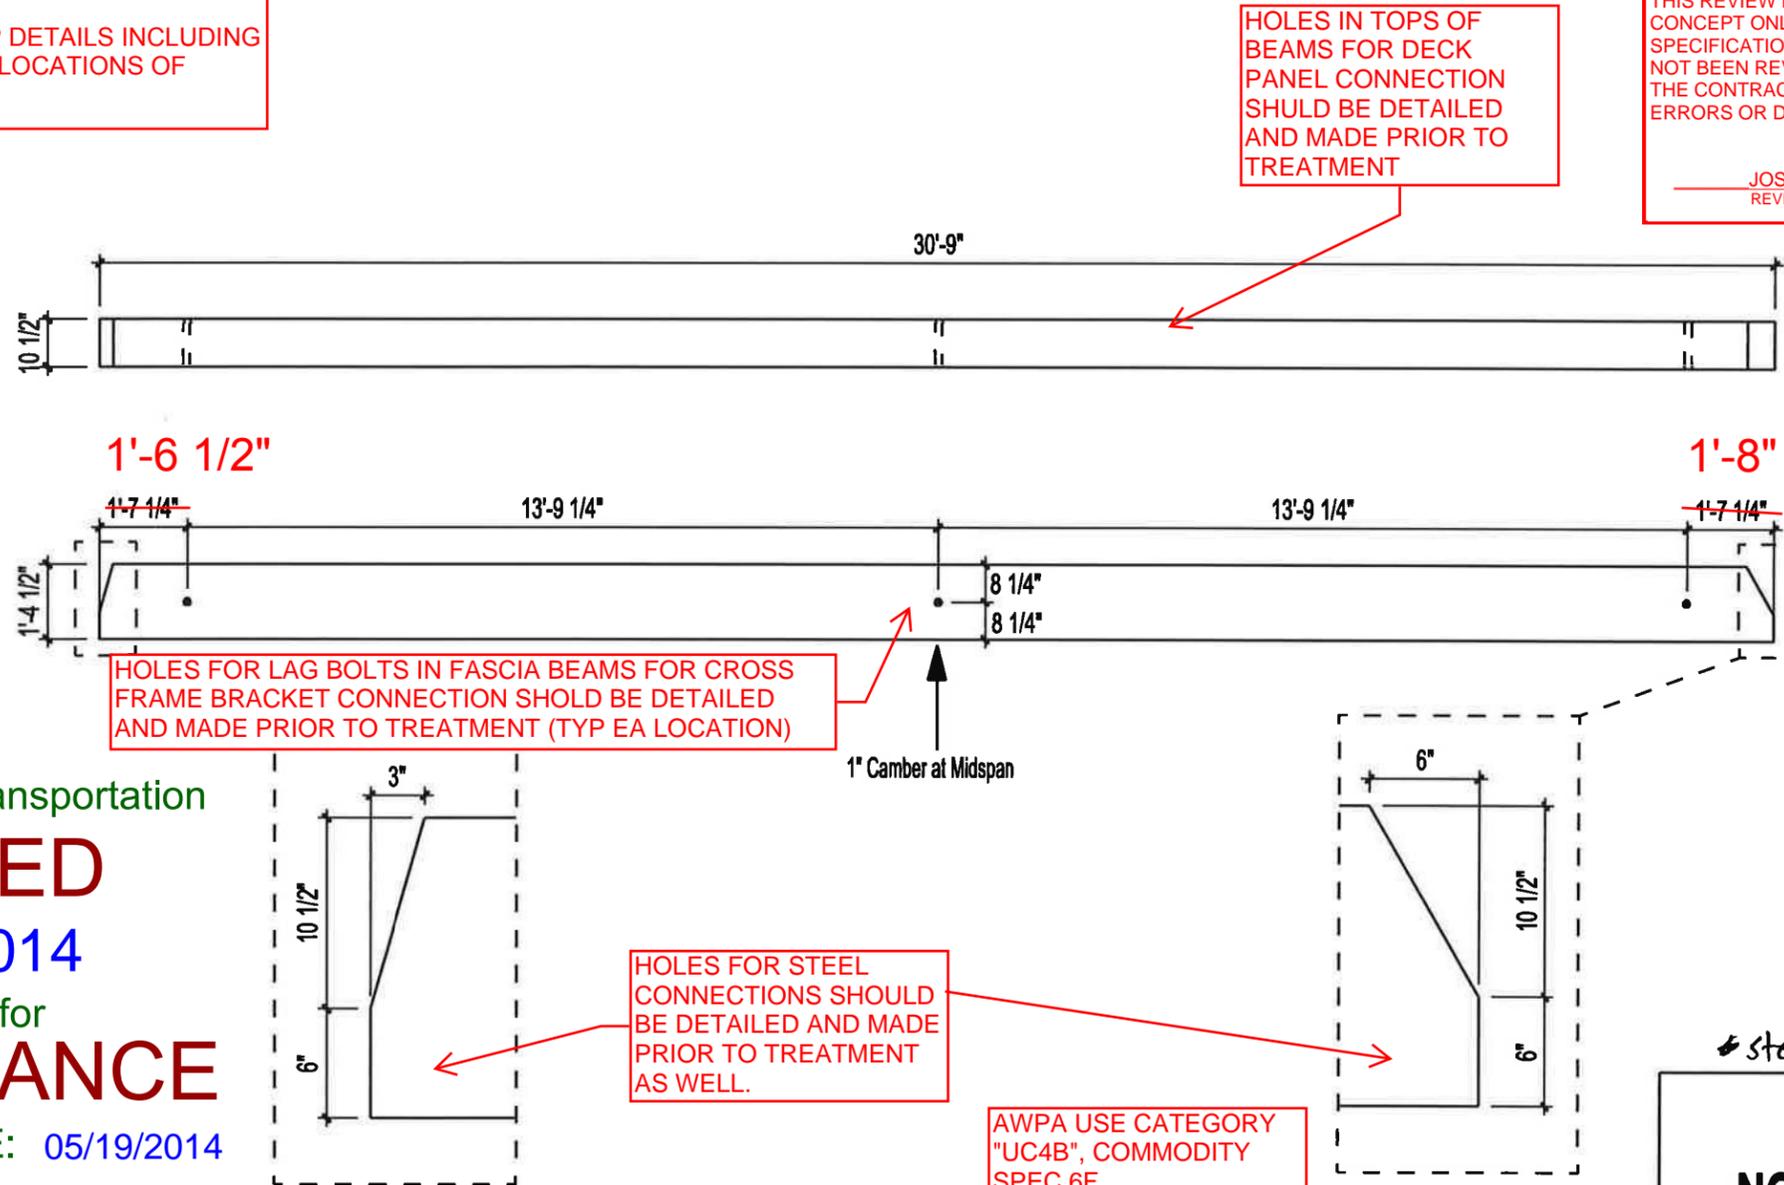

Vermont Agency of Transportation

RECEIVED

ON: **May 5, 2014**

and Checked for

CONFORMANCE

BY: Jennifer Fitch DATE: 05/19/2014

Prod: B1




HOLES FOR STEEL CONNECTIONS SHOULD BE DETAILED AND MADE PRIOR TO TREATMENT AS WELL.

AWPA USE CATEGORY "UC4B", COMMODITY SPEC 6F

steel connection assembly by others.

**FOR APPROVAL
NOT FOR CONSTRUCTION**

Glue Laminated Timber Beam		PRINTED: 02.05.2014	HOLE TYP. U.N.O. 1 1/2" Ø	Qty: 16	Scale: 1/4" = 1'0"	Date: 05-02-2014	Goodfellow inc.
Project: Floating Bridge (Brookfield) No.: 1314-150-U // G-28107 Customer: Wright Construction Co. Inc.	FABRICATION / /	DATE: / /	REVISION	Stress Grade: 26F-1.9E App. Grade: Industrial Treatment: Preservative Type II Penta Type A 0.60#	X-section: 10 1/2" / 16-1/2" Length: 30'-9" Material: Southern Pine	By: J.R. Checked: M.R.	

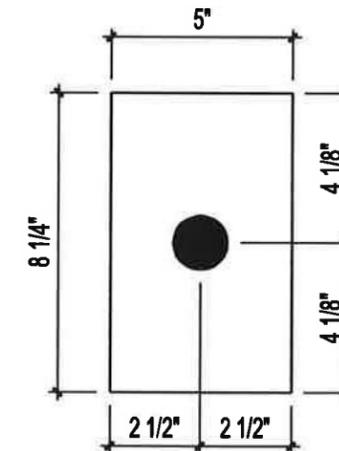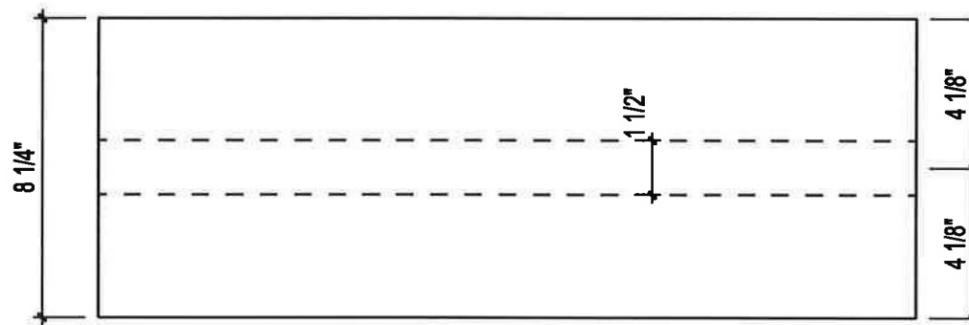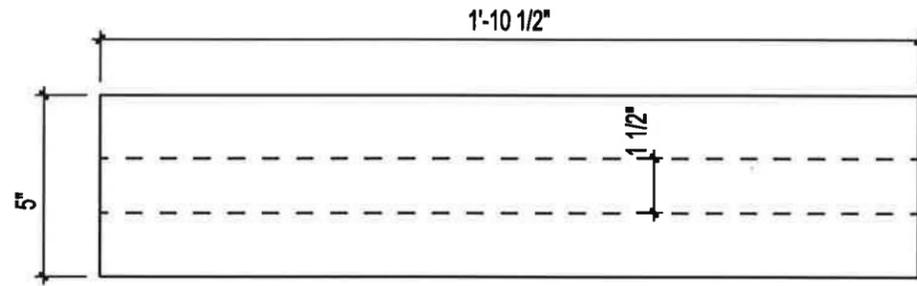

T.Y. LIN INTERNATIONAL

THE STAMPED DOCUMENTS ARE HEREBY:

- ____ APPROVED
- ____ APPROVED AS NOTED
- X REVISE AND RESUBMIT

SEE TRANSMITTAL FOR ADDITIONAL INFORMATION AS APPLICABLE.

THIS REVIEW IS FOR GENERAL CONFORMANCE WITH DESIGN CONCEPT ONLY. ANY DEVIATION FROM THE PLANS OR SPECIFICATIONS NOT CLEARLY NOTED BY THE CONTRACTOR HAS NOT BEEN REVIEWED. REVIEW BY THE ENGINEER SHALL NOT RELIEVE THE CONTRACTOR OF THE CONTRACTUAL RESPONSIBILITY FOR ANY ERRORS OR DEVIATION FROM THE CONTRACT REQUIREMENTS.

____ JOSH OLUND
REVIEWER

05/06/2014
DATE

Vermont Agency of Transportation
Glue Laminated Timber Fabrication Drawings - Rev 0 - TYLI Comment

RECEIVED

ON: **May 5, 2014**

and Checked for

CONFORMANCE

BY: Jennifer Fitch DATE: 05/19/2014

Prod: B2

AWPA USE CATEGORY
"UC4B", COMMODITY
SPEC 6F

**FOR APPROVAL
NOT FOR CONSTRUCTION**

Glue Laminated Timber Diaphragm		PRINTED: 02.05.2014	HOLE TYP. U.N.O.	1 1/2" Ø	Qty: 42	Scale: 2" = 1'0"	Date: 05-02-2014	Goodfellow inc.
Project: Floating Bridge (Brookfield) No.: 1314-150-U // G-28107 Customer: Wright Construction Co. Inc.	FABRICATION ____/____/____	DATE:	REVISION	Stress Grade: 24F-1.8E App. Grade: Industrial Treatment: Preservative Type II Penta Type A 0.60#	X-section: 5" / 8 1/4" Length: 1'-10 1/2" Material: Southern Pine	By: J.R. Checked: M.R.	225, Goodfellow Street DELSON, QUEBEC, J5B 1V5 Tel.: 450-635-6511 Fax : 450-635-8304 www.goodfellowinc.com	