

MILLER CONSTRUCTION, INC.

P.O. BOX 86 ASCUTNEY BLVD WINDSOR, VERMONT 05089-0086

TELEPHONE (802) 674-5525 / FAX (802) 674-5245

TRANSMITTAL

TO: Rob Young, PE Project Manager Vermont Agency of Transportation	DATE	PROJECT NO.
	12/2/2015	Woodstock BRF 0151 (21)

XX

WE ENCLOSE THE FOLLOWING:

UNDER SEPARATE COVER WE ARE SENDING THE FOLLOWING

COPIES	NUMBER	DESCRIPTION	CODE
1		Bridge Rail Sheets 1 - 4	H
1		Bridge Rail WPS 3008 & 3009	H
1		Rail Transitions Sheets 1 - 5	H
1		Rail WPS 3007, 3009, 3016, & 3022	H

CODE:

A FOR INITIAL APPROVAL

B FOR FINAL APPROVAL

C APPROVED AS NOTED-RESUBMISSION REQUIRED

D APPROVED AS NOTED-RESUBMISSION NOT REQUIRED

E DISAPPROVED-RESUBMIT

F QUOTATION REQUESTED

G APPROVED

H FOR APPROVAL

I AS REQUESTED OR REQUIRED

J FOR USE IN ERECTION

K LETTER FOLLOWS


L FOR FIELD CHECK

M FOR YOUR USE

BY: _____

Paul Young

RAIL BENDING PROCEDURE:
 RADII EQUAL OR GREATER THAN 16' TO BE CURVED ON A TUBE BENDING MACHINE, RADII LESS THAN 16' TO BE 'PIE CUT' AND WELDED.

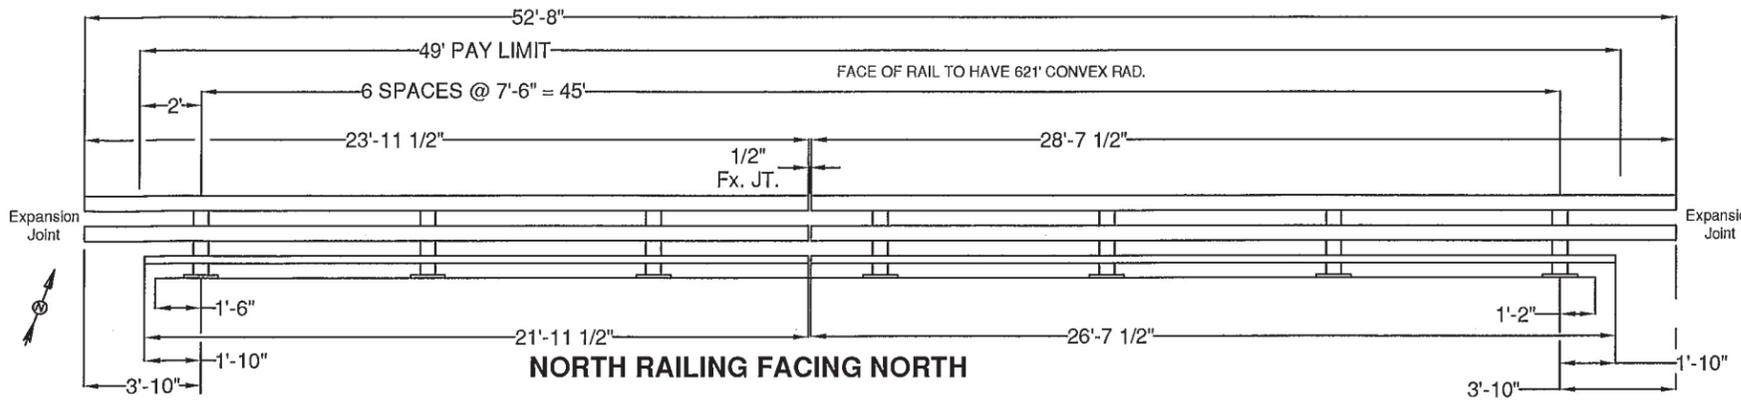





BILL OF MATERIAL				
ITEM #	QTY	PART #	DESCRIPTION	ASTM DESIGNATION
1	14	0033.03610	W6x25, THREE RAIL POST @ 2'-9" OA ON 1 1/4x10x1'-2" B.P.	A572 Gr. 50
2	1	T.B.D.	HSS 3' X 5' X 1/4' RAIL @ 21'-11 1/2' W/ 621' CONVEX R.	A500 Gr. B
3	1	T.B.D.	HSS 3' X 5' X 1/4' RAIL @ 26'-7 1/2' W/ 621' CONVEX R.	A500 Gr. B
2	1	T.B.D.	HSS 3' X 5' X 1/4' RAIL @ 20'-11 1/2' W/ 651' CONCAVE R.	A500 Gr. B
3	1	T.B.D.	HSS 3' X 5' X 1/4' RAIL @ 25'-7 1/2' W/ 651' CONCAVE R.	A500 Gr. B
5	2	T.B.D.	HSS 6' X 6' X 3/16' RAIL @ 23'-11 1/2' W/ 621' CONVEX R.	A500 Gr. B
6	2	T.B.D.	HSS 6' X 6' X 3/16' RAIL @ 28'-7 1/2' W/ 621' CONVEX R.	A500 Gr. B
5	2	T.B.D.	HSS 6' X 6' X 3/16' RAIL @ 22'-11 1/2' W/ 651' CONCAVE R.	A500 Gr. B
6	2	T.B.D.	HSS 6' X 6' X 3/16' RAIL @ 27'-7 1/2' W/ 651' CONCAVE R.	A500 Gr. B
8	2	0033.00840	2-1/8" X 4-1/4" FIX. SPLICE BAR @ 2'-3"	A572 Gr. 50
9	4	0033.00640	HSS 5' X 5' X 5/16" FIX. SPLICE TUBE @ 2'-3"	A500 Gr. B, A572 Gr. 50
10	14	0033.00220	3/8" X 10' X 14' ANCHOR PLATES	A572 Gr. 50
11	14	0033.90050	1/8" X 10' X 14' FABRIC PAD	AASHTO M251
12	58*	0042.21013	Ø 1" X 13" ANCHOR STUDS, W/ 2 1/4" THD. EACH END	A449 TYPE 1
13	114*	0080.18901	Ø 1" HEAVY HEX NUTS	A563 DH
14	58*	0080.18911	Ø 1" FLAT WASHERS	F436
15	56	0080.18905	Ø 1" HEX JAM NUTS	A563 DH
16	56	0080.07500	Ø 7/8" X 8" ROUND HEAD BOLT, NUT, SQ. WASHER, L.W.	A449, A563 DH, F436, ASME D18.2
17	14	0080.06400	Ø 3/4" X 8" HEX BOLT, NUT, (2) F.W., & L.W.	A325, A563DH, F436, & ASME D18.2
18	28	0080.06140	Ø 3/4" X 2-3/4" HEX BOLT, NUT, (2) F.W., & L.W.	A325, A563 DH, F436, & ASME D18.2
19	16	0080.06340	Ø 3/4" X 7-1/2" HEX BOLT, NUT, & (2) F.W.	A325, A563 DH, & F436
20	8	0080.06255	Ø 3/4" X 4-1/2" HEX BOLT, NUT, & (2) F.W.	A325, A563 DH, & F436
21	14	0033.00500	L5' X 5' X 5/8" RAILING ANGLE @ 6"	A572 Gr. 50
22	4		DELINEATORS - NOT SHOWN	(SUPPLIED BY CUSTOMER)

*-2 EXTRA FOR VOAT TESTING

GENERAL NOTES:

- 1) ALL RAILING IS TO BE FABRICATED AND ERECTED ACCORDING TO SECTION 525 OF THE STANDARD SPECIFICATIONS.
- 2) PRIOR TO GALVANIZING THE ASSEMBLED POST, GRIND ALL EDGES TO A MINIMUM RADIUS OF 1/16".
- 3) ALL POST SHALL BE SET NORMAL TO GRADE. THE MAXIMUM CENTER TO CENTER SPACING OF BRIDGE RAIL POST IS 8' 3".
- 4) SECTIONS OF RAIL TUBE SHALL BE ATTACHED TO A MINIMUM OF TWO BRIDGE POSTS AND PREFERABLY TO AT LEAST 4 POSTS.
- 5) RAIL TUBE EXPANSION JOINTS SHALL BE PROVIDED IN ANY RAIL BAY SPANNING THE END OF AN INTEGRAL ABUTMENT BRIDGE AND AT ALL SUPER STRUCTURE EXPANSION JOINTS. EXPANSION JOINT WIDTH SHALL BE 4" @ 68°F AND WILL BE ADJUSTED IN THE FIELD BY THE ENGINEER FOR OTHER TEMPERATURES.
- 6) STD. SPLICE HOLES ONLY IN BRIDGE RAIL TUBES. REST TO BE DRILLED BY CUSTOMER. FIELD DRILLED HOLES TO BE COATED WITH AN APPROVED ZINC-RICH PAINT PRIOR TO INSTALLATION.
- 7) BOLTS SHALL BE TORQUED SNUG TIGHT (APPROXIMATELY 100 FT-LB).
- 8) SEE STANDARD DRAWING G-1 FOR DETAILS OF DELINEATORS. A DELINEATOR SHALL BE INSTALLED AT 30 FOOT SPACING OR THE NEAREST POST. WHITE IS TO BE INSTALLED ON THE DRIVER'S RIGHT. FOR ONE WAY BRIDGES, YELLOW IS TO BE INSTALLED ON THE DRIVER'S LEFT. PAYMENT FOR DELINEATORS SHALL BE INCIDENTAL TO OTHER ITEMS.
- 9) ANY BENDING OF RAIL SHALL BE DONE AT THE FABRICATION PLANT ACCORDING TO A PROCEDURE PROVIDED BY THE FABRICATOR.
- 10) THE MINIMUM DISTANCE FROM THE POST TO AN EXPANSION JOINT SHALL BE DETERMINED BY THE MINIMUM EDGE DISTANCE OF 5" FROM ANY ANCHOR STUD TO THE END OF THE SLAB, OR THE EXPANSION JOINT RECESS POUR, IF ONE IS USED.
- 11) PROTRUSIONS CAUSED BY WELDING OR GALVANIZING ARE NOT PERMITTED ON THE ADJOINING SURFACES OF THE BOX BEAM RAILS, SPLICE TUBES AND FILL PLATES.
- 12) THIS RAILING MEETS THE REQUIREMENTS FOR A TL-4 SERVICE LEVEL.

Weld procedures require re-submittal. Please resubmit the entire package to reflect any changes required for the welding procedures.

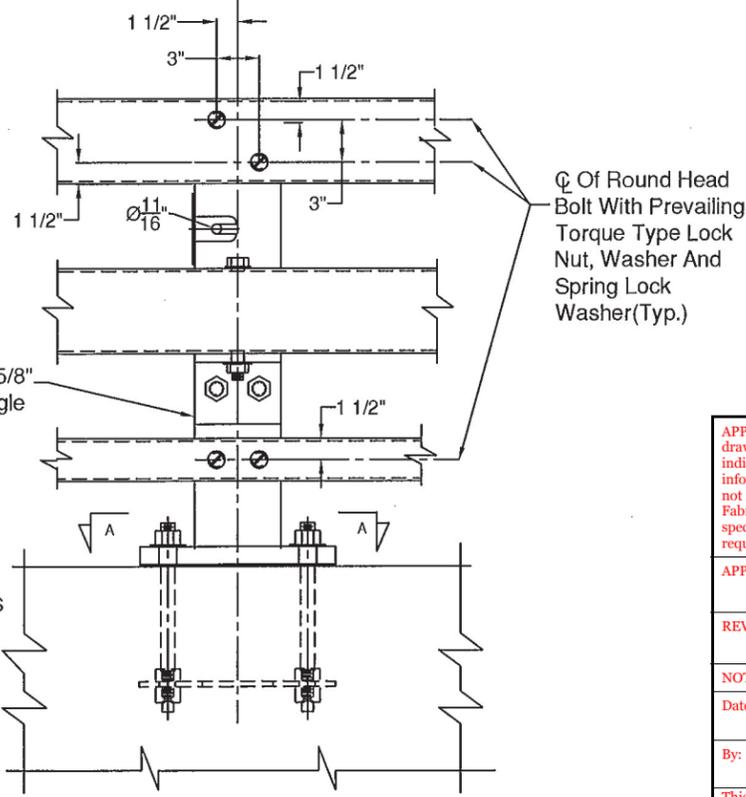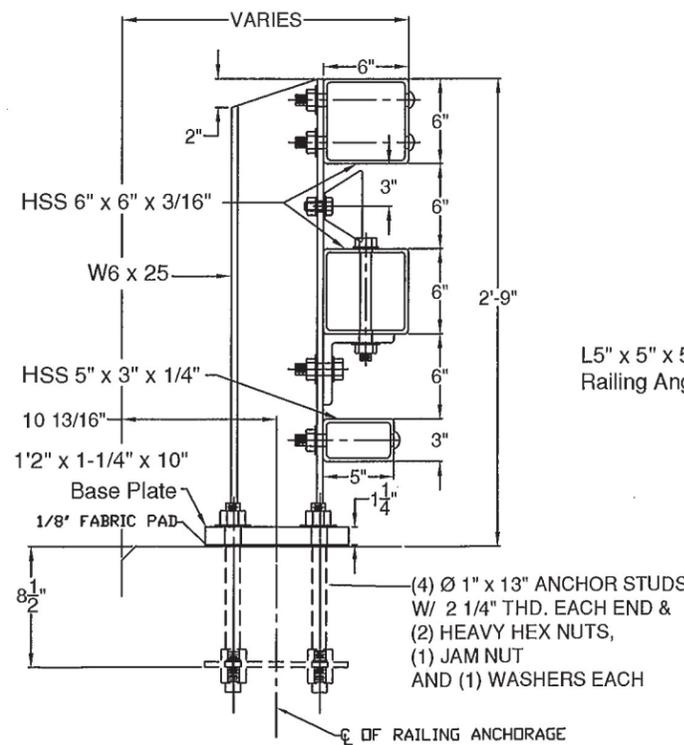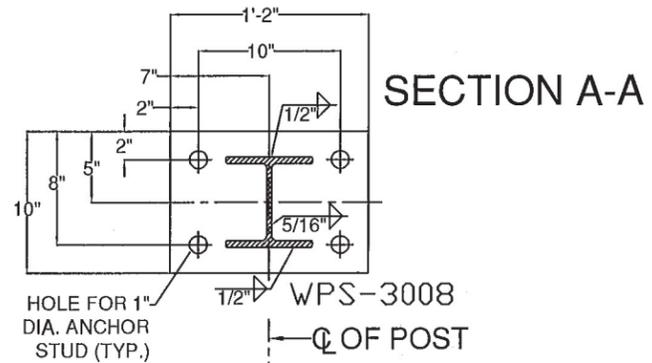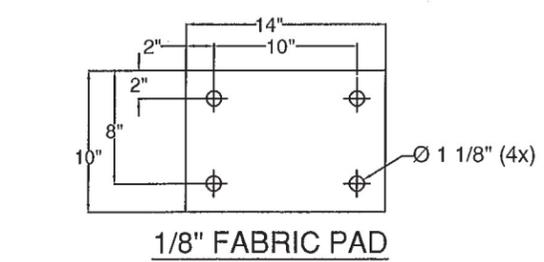

APPROVED: Approval of drawings and/or procedures indicates concurrence with the information presented and does not relieve the Contractor or Fabricator of compliance with all specifications and code requirements

APPROVED AS NOTED

REVISE AND RESUBMIT **X**

NOT REVIEWED

Date: **12/17/15**

By: *Thomas E. Kirsch*

This review by Stantec Consulting Services Inc. is for the sole purpose of ascertaining conformance with the general design concept. This review shall not mean that Stantec Consulting Services Inc approves the detail design inherent in the shop drawings, responsibility for which shall remain with the Contractor. Submitting same, and such review shall not relieve the Contractor of his responsibility for errors or omissions in the shop drawing or of his responsibility for meeting all requirements of the Contract Documents. The contractor is responsible for dimensions to be confirmed and correlated at the job site, for information that pertains solely to the fabrication processes or to techniques of construction and installation and for coordination of the work of all subtrades.

Stantec

ITEM #: 525.335

STRUCTURAL STEEL TO COMPLY W/ ASTM A6

TOLERANCE UNLESS OTHERWISE NOTED:
 FRACTIONS = ± 1/16"
 ANGLES = ± 1/2"
 DIAMETERS = ± 1/32"

SHEET 1 OF 4

BRIDGE RAIL DETAILS SHEET
 VERMONT ROUTE 106 (MAJOR COLLECTOR, RURAL), BRIDGE # 24
 TOWN OF WOODSTOCK, COUNTY OF WINDSOR, VT.

R NO.	DATE	DESCRIPTION	BY	R NO.	DATE	DESCRIPTION	BY

ELDERLEE, INC.
 OAKS CORNERS, NEW YORK 14518
 email: dlong@elderlee.com / epeek@elderlee.com
 Tel: 315-789-6670 Fax: 315-789-6615

CERTIFIED FABRICATOR
 ORTHOGRAPHIC PROJECTION

DRAWN: 11/30/15
 CHECKED: D.L. 11/30/15
 APPROVED: [Signature]
 SCALE: SCHEMATIC
 DRAWING NO. F.L. FAYETTE-WOODSTOCK (15)

SECTION

ELEVATION
STEEL BRIDGE RAILING

Weld procedures require re-submittal. Please resubmit the entire package to reflect any changes required for the welding procedures.

APPROVED: Approval of drawings and/or procedures, indicates concurrence with the information presented and does not relieve the Contractor or Fabricator of compliance with all specifications and code requirements

APPROVED AS NOTED

REVISE AND RESUBMIT **X**





NOT REVIEWED

Date: **12/17/15**

By: *John E. Kline*

This review by Stantec Consulting Services Inc. is for the sole purpose of ascertaining conformance with the design concept. This review shall not mean that Stantec Consulting Services Inc. assumes the detail design inherent in the shop drawings, responsibility for which shall remain with the Contractor. Submitting same, and such review shall not relieve the Contractor of his responsibility for errors or omissions in the shop drawing or of his responsibility for meeting all requirements of the Contract Documents. The contractor is responsible for all work to be confirmed and corrected at the job site, for information that pertains solely to the fabricator, process or to techniques of construction and installation and for coordination of the work of all trades.

Stantec

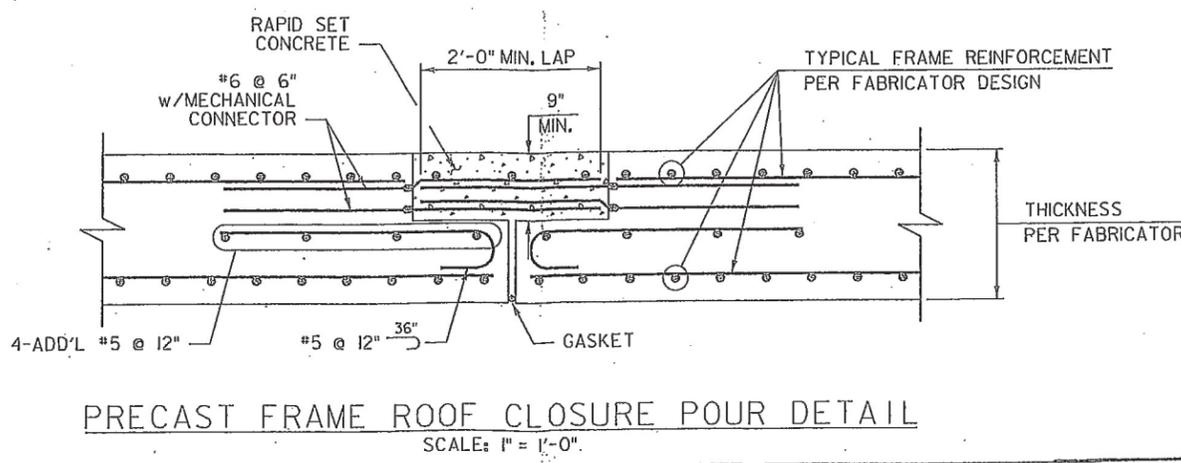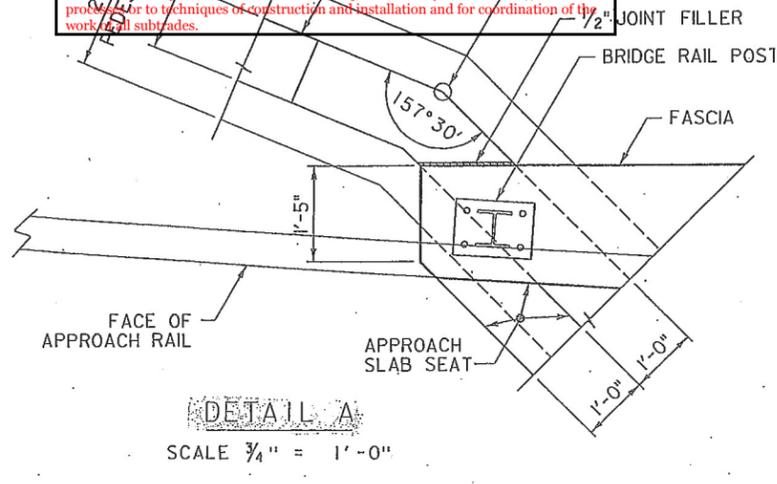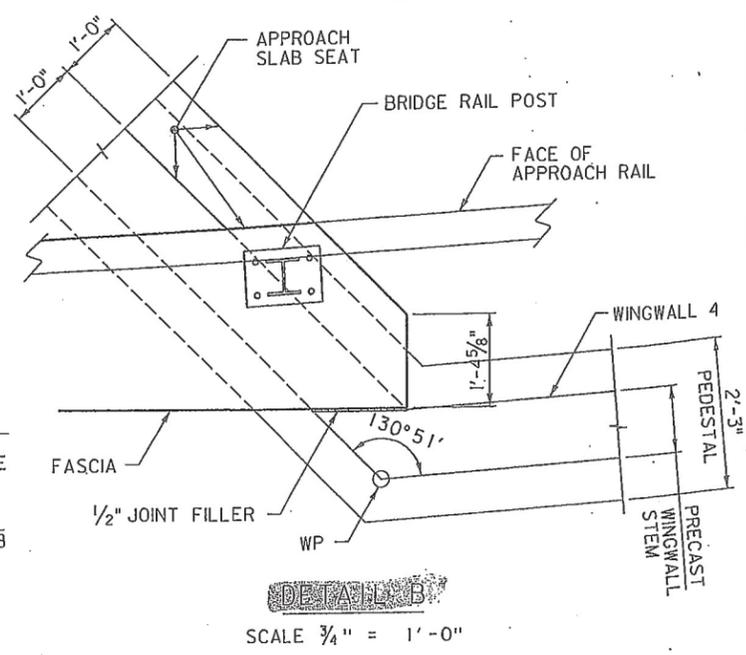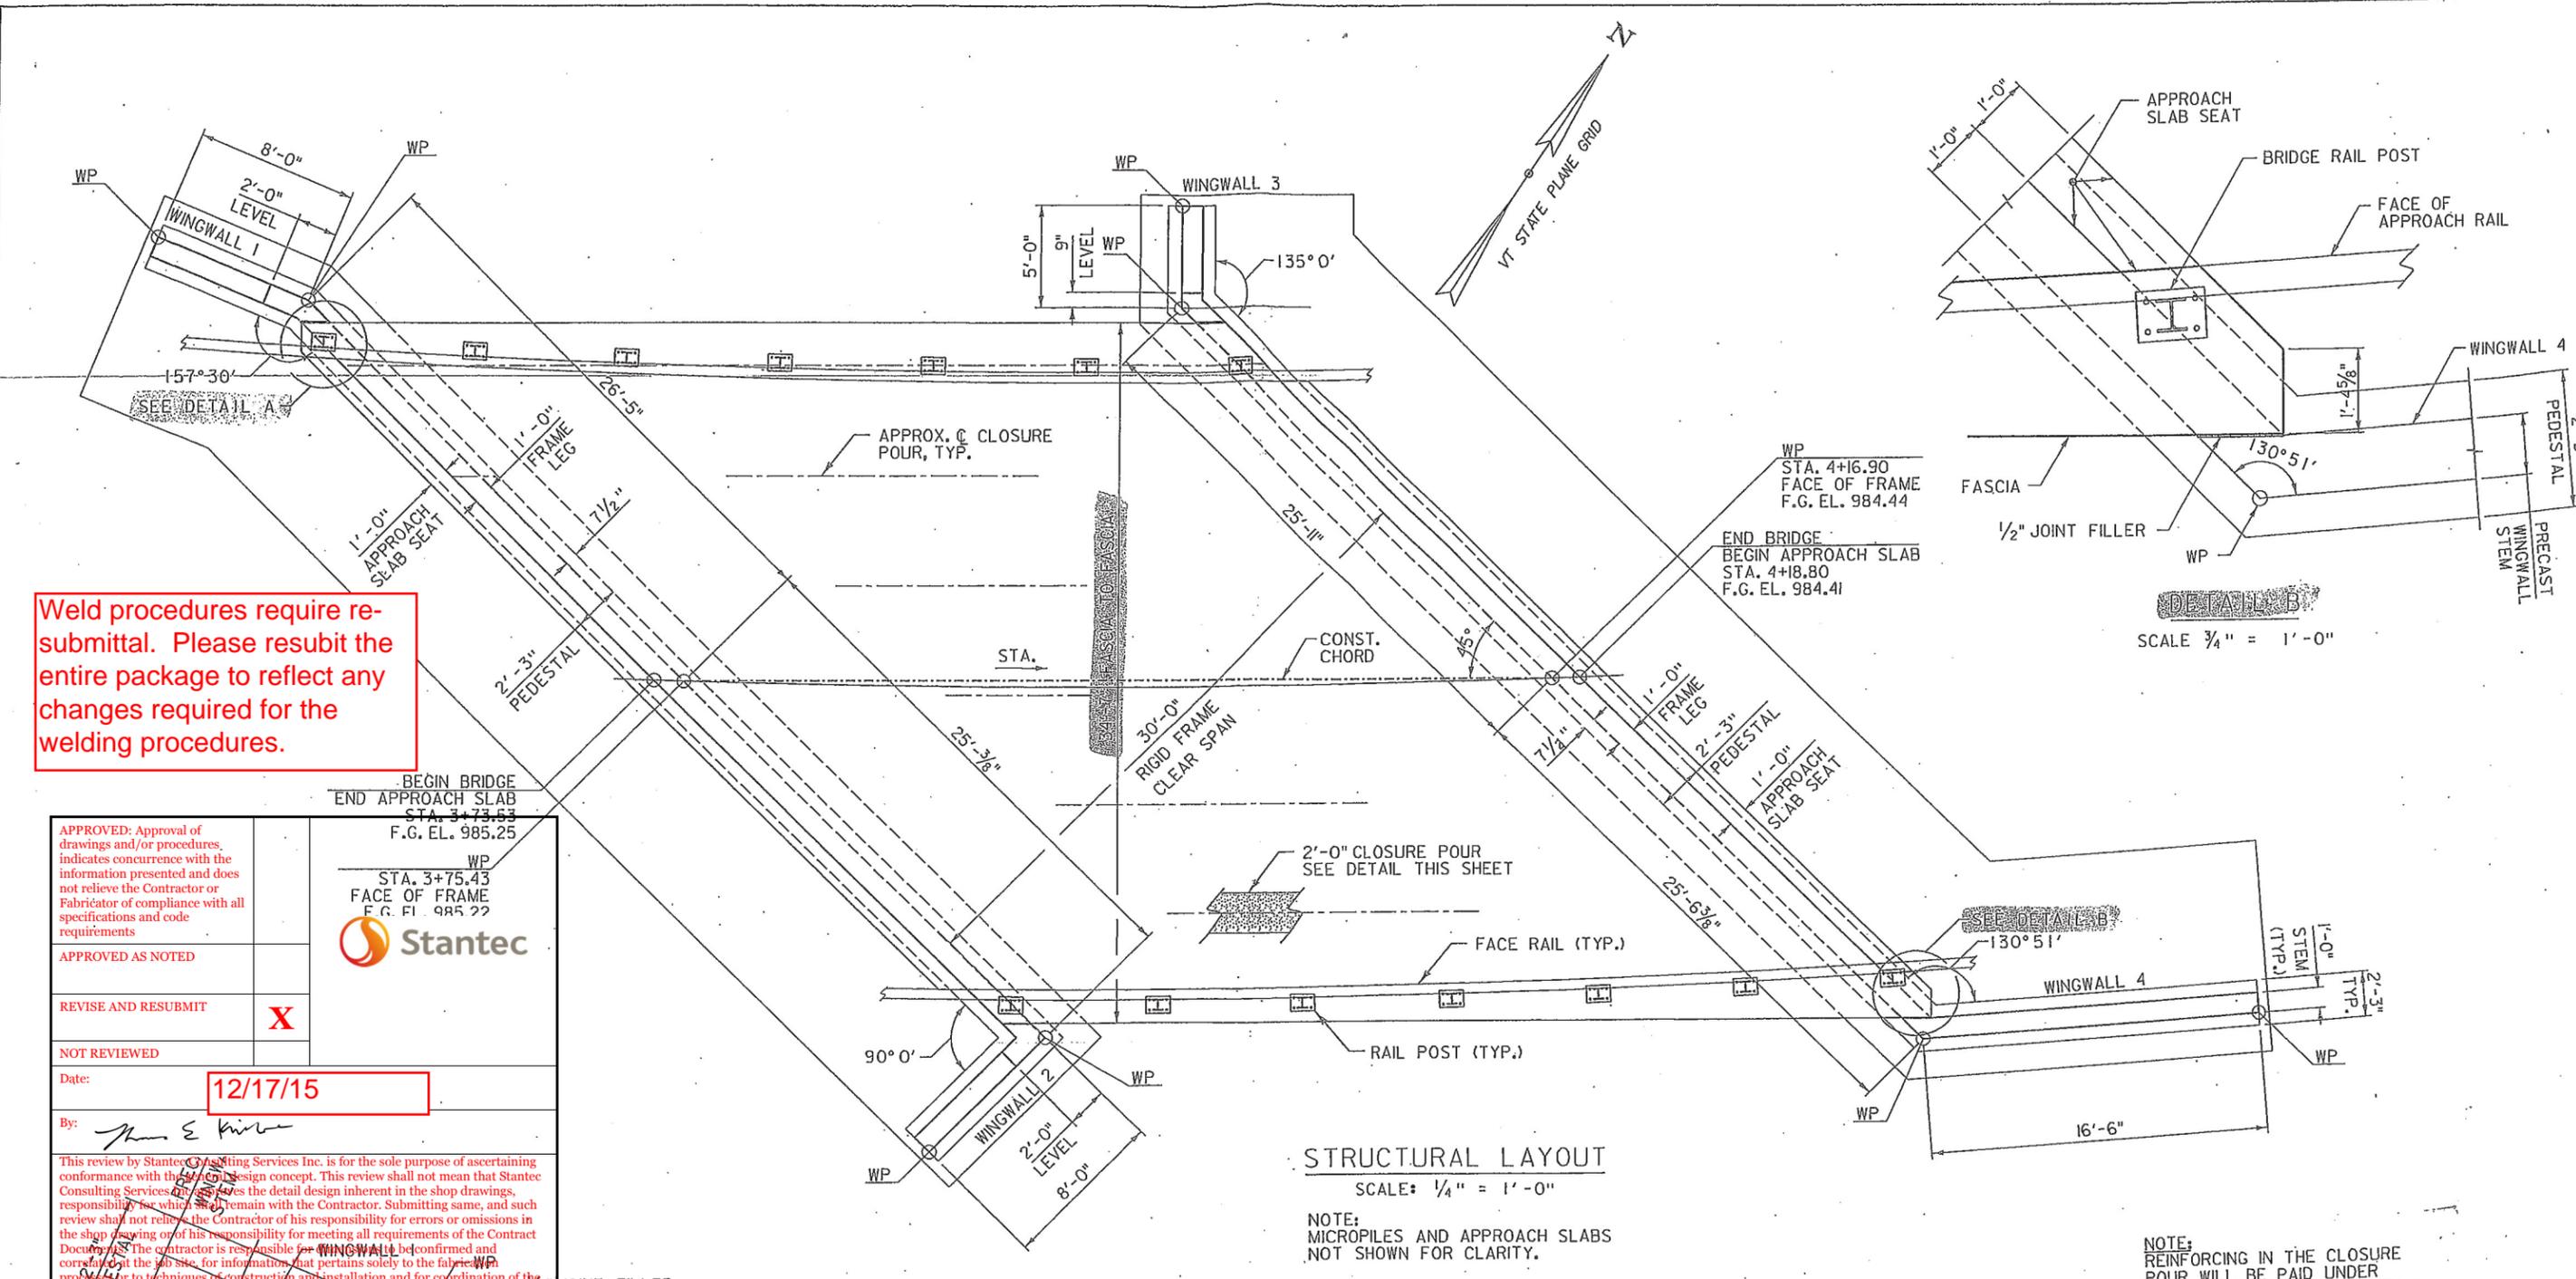

ITEM #: 525.335
STRUCTURAL STEEL TO COMPLY W/ ASTM A6

TOLERANCE UNLESS OTHERWISE NOTED:
FRACTIONS = ± 1/16"
ANGLES = ± 1/2"
DIAMETERS = ± 1/32"


R NO.	DATE	DESCRIPTION	BY	R NO.	DATE	DESCRIPTION	BY

BRIDGE RAIL DETAILS SHEET
VERMONT ROUTE 108 (MAJOR COLLECTOR, RURAL), BRIDGE # 24
TOWN OF WOODSTOCK, COUNTY OF WINDSOR, VT.

ELDERLEE, INC.
OAKS CORNERS, NEW YORK 14678
email: dlong@elderlee.com / speck@elderlee.com
Tel: 315-789-6870 Fax: 315-789-6815

DRAWN: E.P. 11/30/15
CHECKED: D.L. 11-23-16
APPROVED: [Signature]
SCALE: SCHEMATIC
DRAWING NO. FR. LAFAYETTE-WOODSTOCK (16)

SHEET 3 OF 4

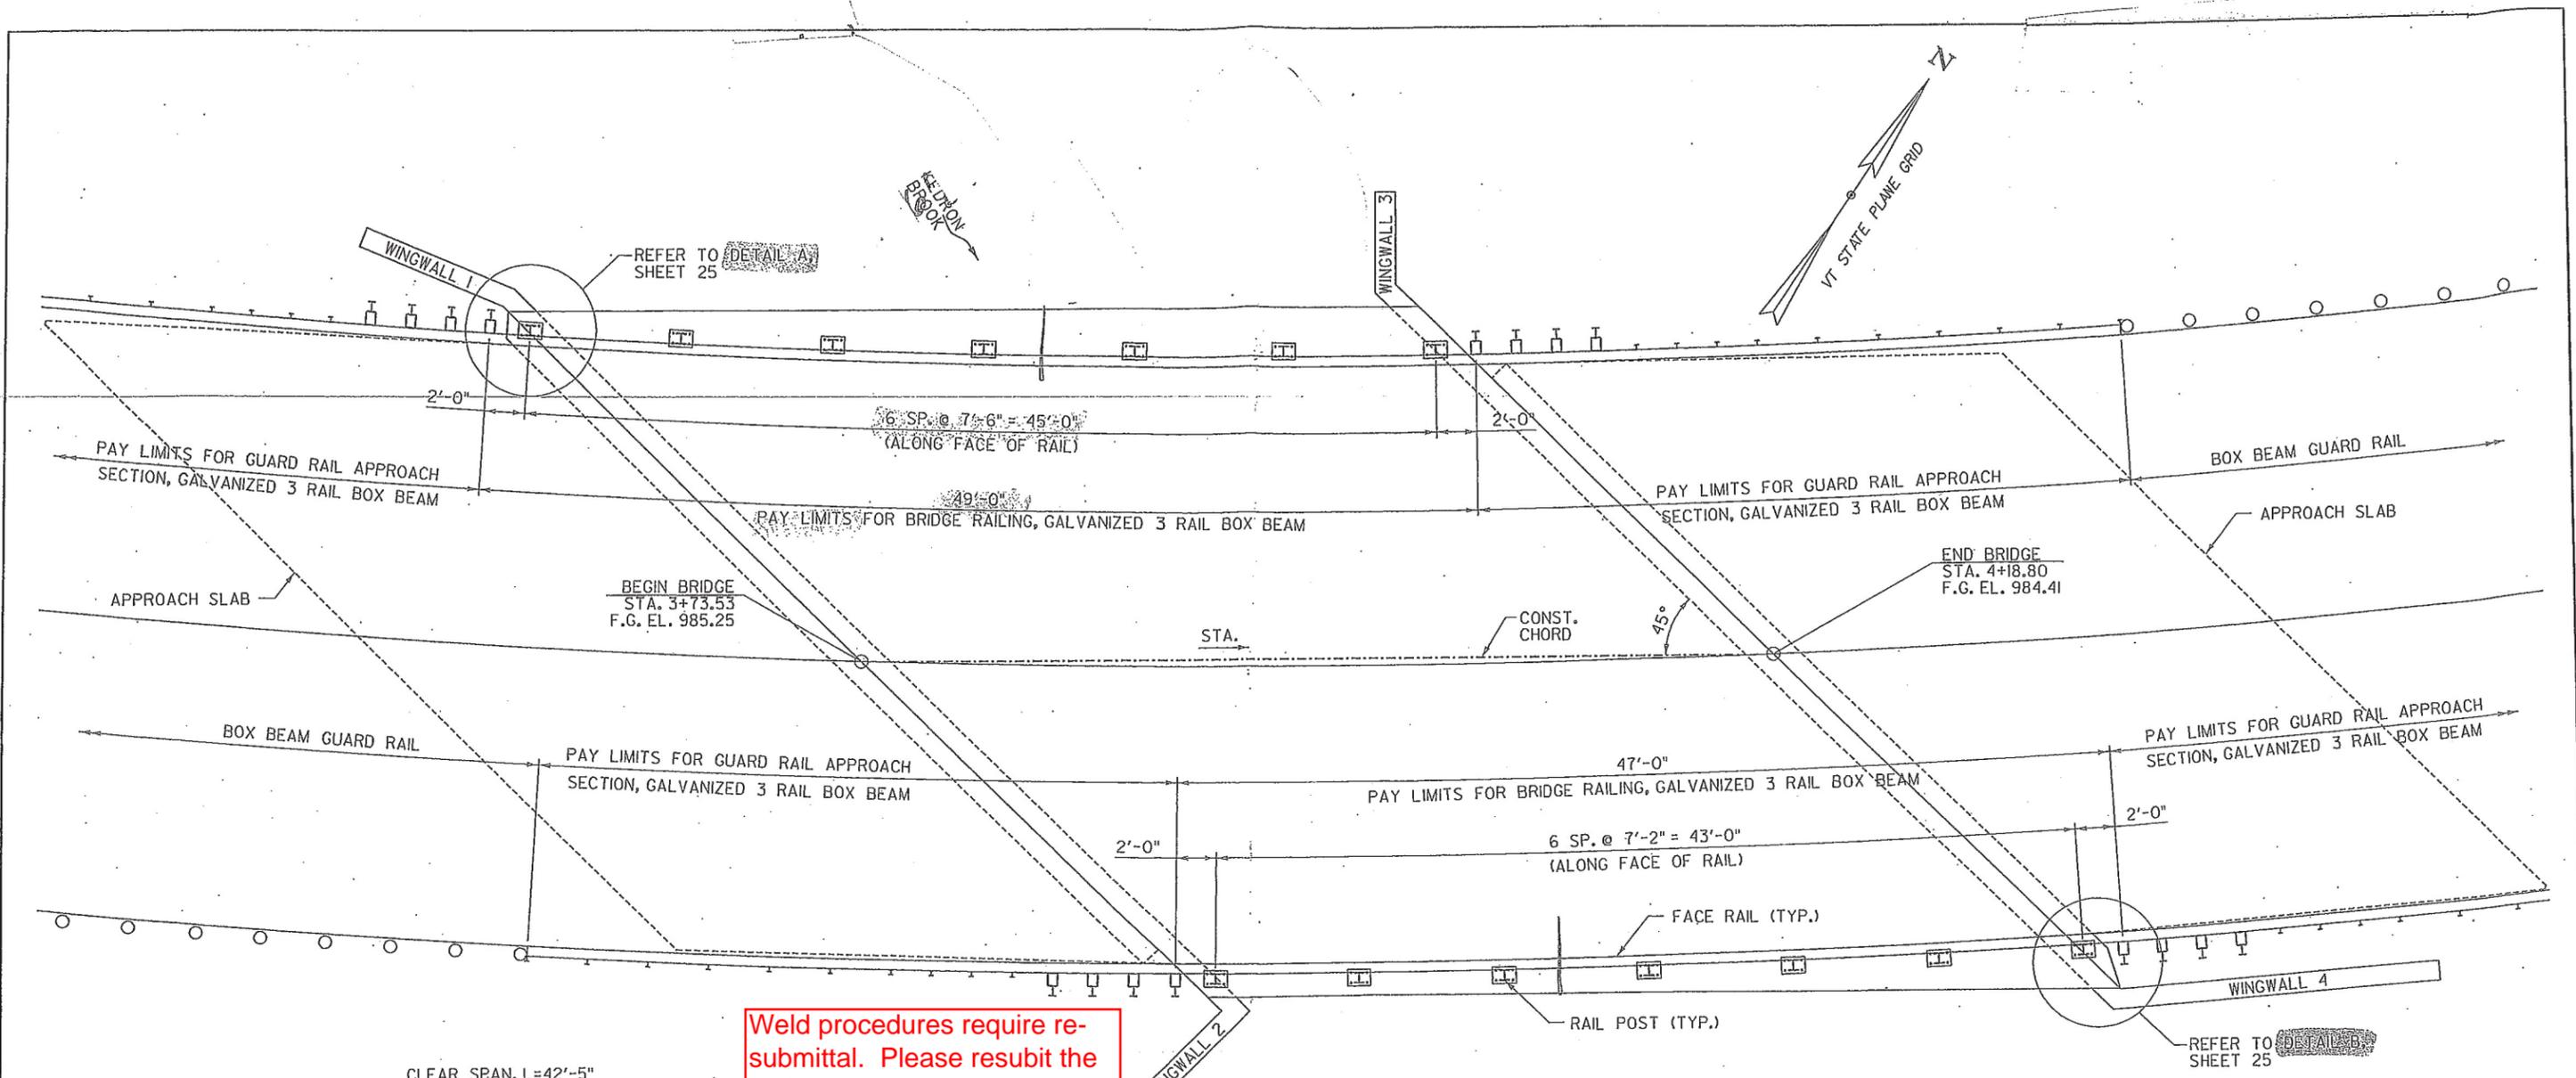

Weld procedures require re-submittal. Please resubmit the entire package to reflect any changes required for the welding procedures.

BRIDGE RAIL LAYOUT
SCALE: 1/4" = 1'-0"

NOTE:
RAIL POST SPACING IS BASED ON ASSUMED FRAME LEG THICKNESS OF 1'-0". THE FABRICATOR SHALL ADJUST DIMENSIONS AS NECESSARY BASED ON ACTUAL FRAME LEG THICKNESS USED.

APPROVED: Approval of drawings and/or procedures indicates concurrence with the information presented and does not relieve the Contractor or Fabricator of compliance with all specifications and code requirements

APPROVED AS NOTED


REVISE AND RESUBMIT

NOT REVIEWED

Date: **12/17/15**

By: *John E. Kille*

This review by Stantec Consulting Services Inc. is for the sole purpose of ascertaining conformance with the general design concept. This review shall not mean that Stantec Consulting Services Inc. approves the detail design inherent in the shop drawings, responsibility for which shall remain with the Contractor. Submitting same, and such review shall not relieve the Contractor of his responsibility for errors or omissions in the shop drawing or of his responsibility for meeting all requirements of the Contract Documents. The contractor is responsible for dimensions to be confirmed and correlated at the job site, for information that pertains solely to the fabrication processes or to techniques of construction and installation and for coordination of the work of all subcontractors.

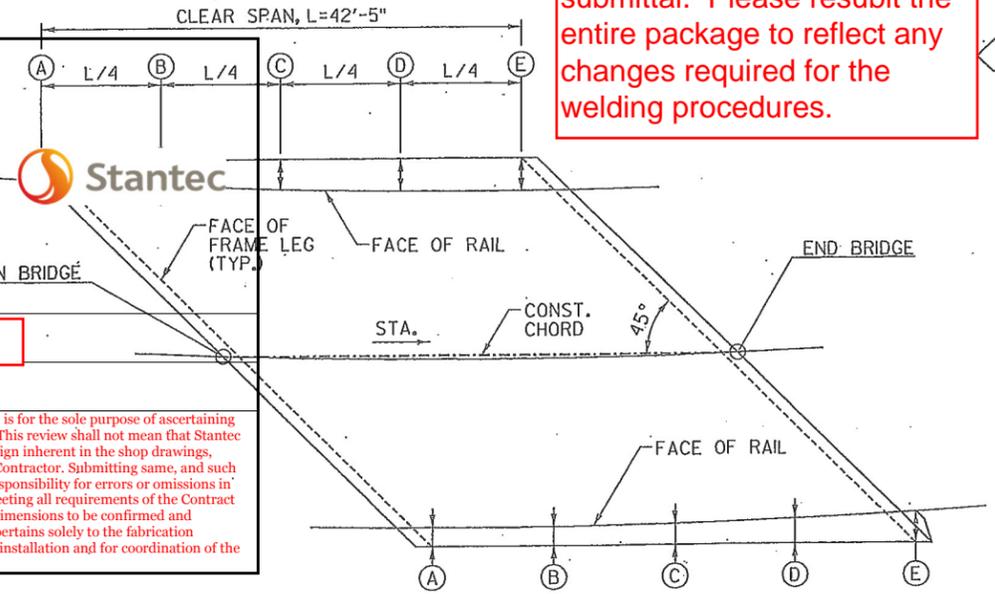

FACE OF RAIL TO FASCIA OFFSET
NOT TO SCALE

TABLE OF OFFSETS FROM FACE OF RAIL TO FASCIA		
POINT	OFFSET TO LEFT FASCIA (FT)	OFFSET TO RIGHT FASCIA (FT)
A	1.73	1.68
B	2.31	1.69
C	2.7	1.88
D	2.92	2.23
E	2.96	2.76

ITEM #: 525.335

STRUCTURAL STEEL TO COMPLY W/ ASTM A6

TOLERANCE UNLESS OTHERWISE NOTED:
FRACTIONS = ± 1/16"
ANGLES = ± 1/2"
DIAMETERS = ± 1/32"

SHEET 4 OF 4

BRIDGE RAIL DETAILS SHEET
VERMONT ROUTE 108 (MAJOR COLLECTOR, RURAL), BRIDGE # 24
TOWN OF WOODSTOCK, COUNTY OF WINDSOR, VT.

R NO.	DATE	DESCRIPTION	BY	R NO.	DATE	DESCRIPTION	BY

ELDERLEE, INC.
OAKS CORNERS, NEW YORK 14618
email: dlong@elderlee.com / epes@elderlee.com
Tel: 815-789-6870 Fax: 815-789-6815

ORTHOGONAL PROJECTION

SCALE: SCHEMATIC

DRAWING NO. F.R. LAFAYETTE-WOODSTOCK (14)

WELDING PROCEDURE SPECIFICATION

PQR ELDERLEE#1

Material Specification	A572 GRD. 50 /A992-06a		
Welding Process	FCAW		
Manual or Machine	SEMAUTOMATIC		
Position of Welding	FLAT/HORIZONTAL		
Filler Metal Specification	A5.20		
Filler Metal Classification	E70 LINCOLN OUTERSHEILD		
Flux	N/A		
Shielding Gas	CO 2	Dew Point	-40DEG F Flow Rate 50 CFM
Single or Multiple Pass	SINGLE		(45 TO 63 CFM)
Single or Multiple Arc	N/A		
Welding Current	DC		
Polarity	DCEP		
Welding Progression	STRINGER		
Root Treatment	PER D1.5		
Preheat and Interpass Temperature	PER D1.5		
Postheat Temperature	NONE		
Heat Input	Min		Max

CFH

WELDING PROCEDURE

Pass no.	Electrode size	Welding Current		Travel speed	Joint detail
		Amperes	Volts		
1	3/32	390	27	12	
Variable	LIMITS	351	25	11	
		TO 429	TO 29	TO 13	

This procedure may vary due to fabrication sequence, fit-up, pass size, etc., within the limitation of variables given in Section 5.

Procedure No. 3008

Contractor Elderlee, Inc.

Revision No. _____

Authorized By RANDY SCOTT

Date 5/29/2013

WELDING PROCEDURE SPECIFICATION

PQR ELDERLEE #3

Material Specification	A709 TO A500 GR B		
Welding Process	FCAW-G		
Manual or Machine	SEMAUTOMATIC		
Position of Welding	FLAT/HORIZONTAL		
Filler Metal Specification	A5.29		
Filler Metal Classification	E81T1-Ni1C-JH4		
Flux	N/A		
Shielding Gas	CO 2	Dew Point	-40DEG F Flow Rate 50CFH
Single or Multiple Pass	SINGLE		
Single or Multiple Arc	SINGLE		
Welding Current	DC		
Polarity	REVERSE ELECTRODE POSITIVE		
Welding Progression	STRINGER		
Root Treatment	D1.5		
Preheat and Interpass Temperature	D1.5		
Postheat Temperature	NONE		
Heat Input	Min		Max

WELDING PROCEDURE

Pass no.	Electrode size	Welding Current		Travel speed	Joint detail
		Amperes	Volts		
1	1/16	310	25	11	
Variable	LIMITS	341	27	12	
		TO 269	TO 23	TO 10	

This procedure may vary due to fabrication sequence, fit-up, pass size, etc., within the limitation of variables given in Section 5.

Procedure No. 3009

Contractor Elderlee, Inc.



Revision No. _____

Authorized By RANDY SCOTT

Date 3/20/2014


32' - PAY LIMIT FOR TRANSITION - BRIDGE RAILING TO BOX BEAM GUIDE RAIL

ELEVATION VIEW

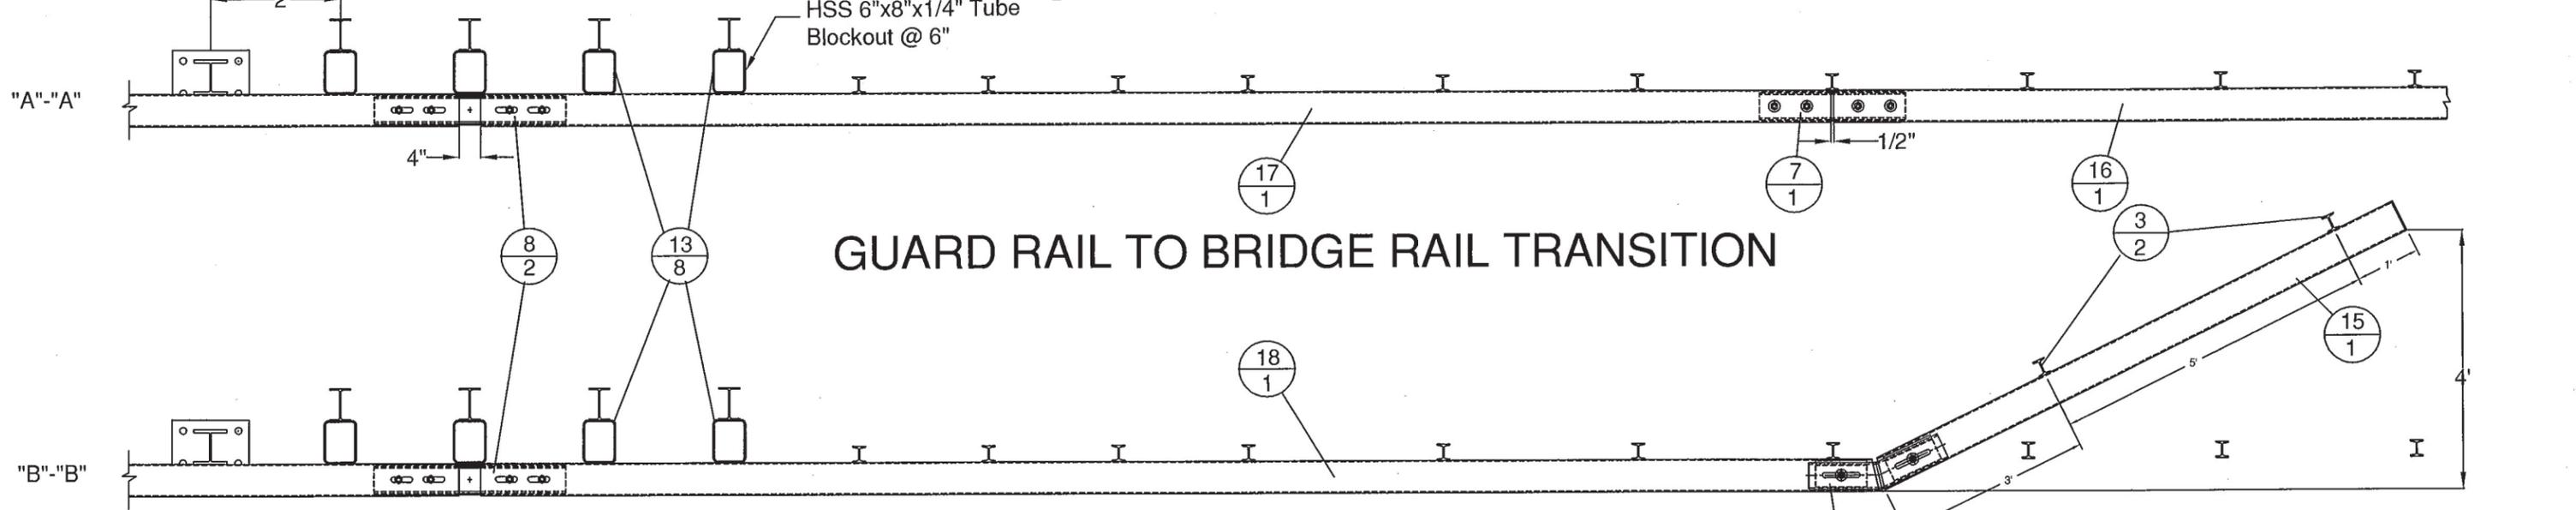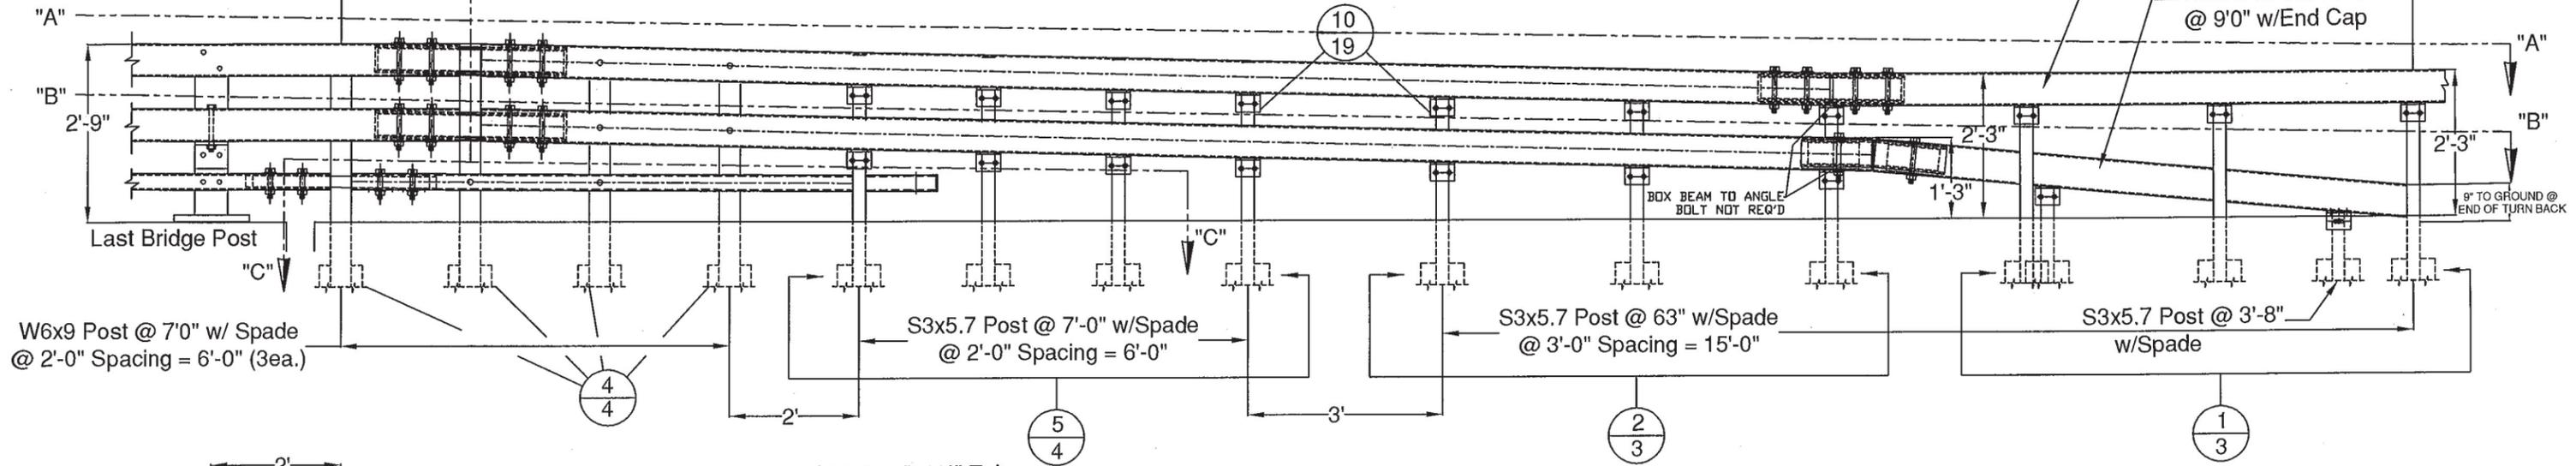

GUARD RAIL TO BRIDGE RAIL TRANSITION

NORTH TRANSITION TO HAVE 620' CONVEX RADIUS,
SOUTH TRANSITION TO HAVE 650' CONCAVE RADIUS.

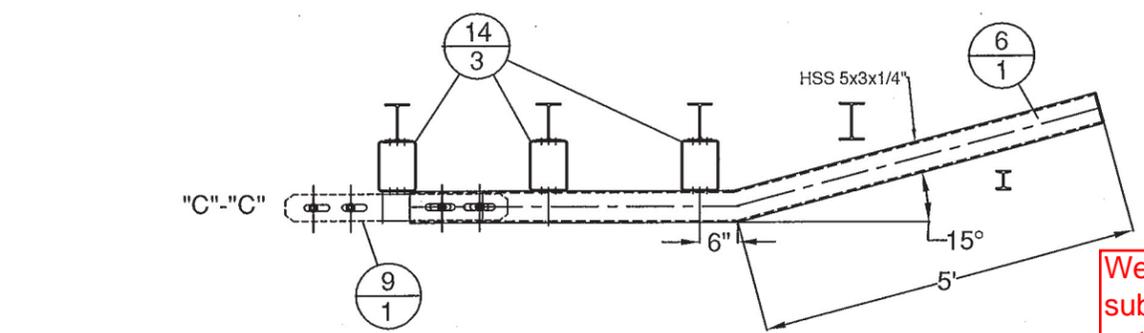

Weld procedures require re-submittal. Please resubmit the entire package to reflect any changes required for the welding procedures.

APPROVED: Approval of drawings and/or procedures indicates concurrence with the information presented and does not relieve the Contractor or Fabricator of compliance with all specifications and code requirements.

APPROVED AS NOTED

REVISE AND RESUBMIT

NOT REVIEWED

Date:

By: *J. E. Hill*

This review by Stantec Consulting Services Inc. is for the sole purpose of ascertaining conformance with the general design concept. This review shall not constitute Stantec Consulting Services Inc. approving the detail design inherent in the shop drawings, responsibility for which shall remain with the Contractor. Submitting name, and each review shall not relieve the Contractor of his responsibility for errors or omissions in the shop drawing or of his responsibility for meeting all requirements of the Contract Documents. The contractor is responsible for dimensions to be confirmed and corrected at the job site, for information that pertains solely to the fabrication process or to techniques of construction and installation and for coordination of the work of all trades.

Stantec

ITEM #: 621.725

STRUCTURAL STEEL TO COMPLY W/ ASTM A6

TOLERANCE UNLESS OTHERWISE NOTED:
FRACTIONS = ± 1/16"
ANGLES = ± 1/2"
DIAMETERS = ± 1/32"

SHEET 1 of 5

GUARD RAIL TO BRIDGE RAIL TRANSITION DETAILS SHEET
VERMONT ROUTE 106 (MAJOR COLLECTOR, RURAL), BRIDGE # 24
TOWN OF WOODSTOCK, COUNTY OF WINDSOR, VT.






R NO.	DATE	DESCRIPTION	BY	R NO.	DATE	DESCRIPTION	BY

ELDERLEE, INC.
OAKS CORNERS, NEW YORK 14518
email: dlong@elderlee.com / epesk@elderlee.com
Tel: 315-789-6670 Fax: 315-789-6615

CERTIFIED FABRICATOR

ORTHOGONAL PROJECTION

DRAWN	E.P.	11/30/15
CHECKED	D.L.	11/30/15
APPROVED		
SCALE	SCHMATIC	
DRAWING NO. F.R.LAFAYETTE-WOODSTOCK (21)		

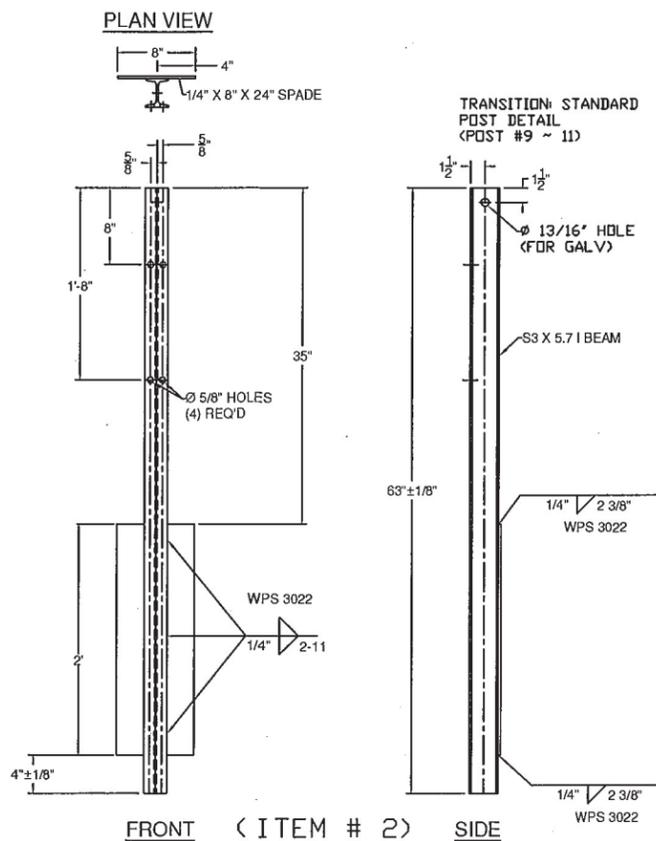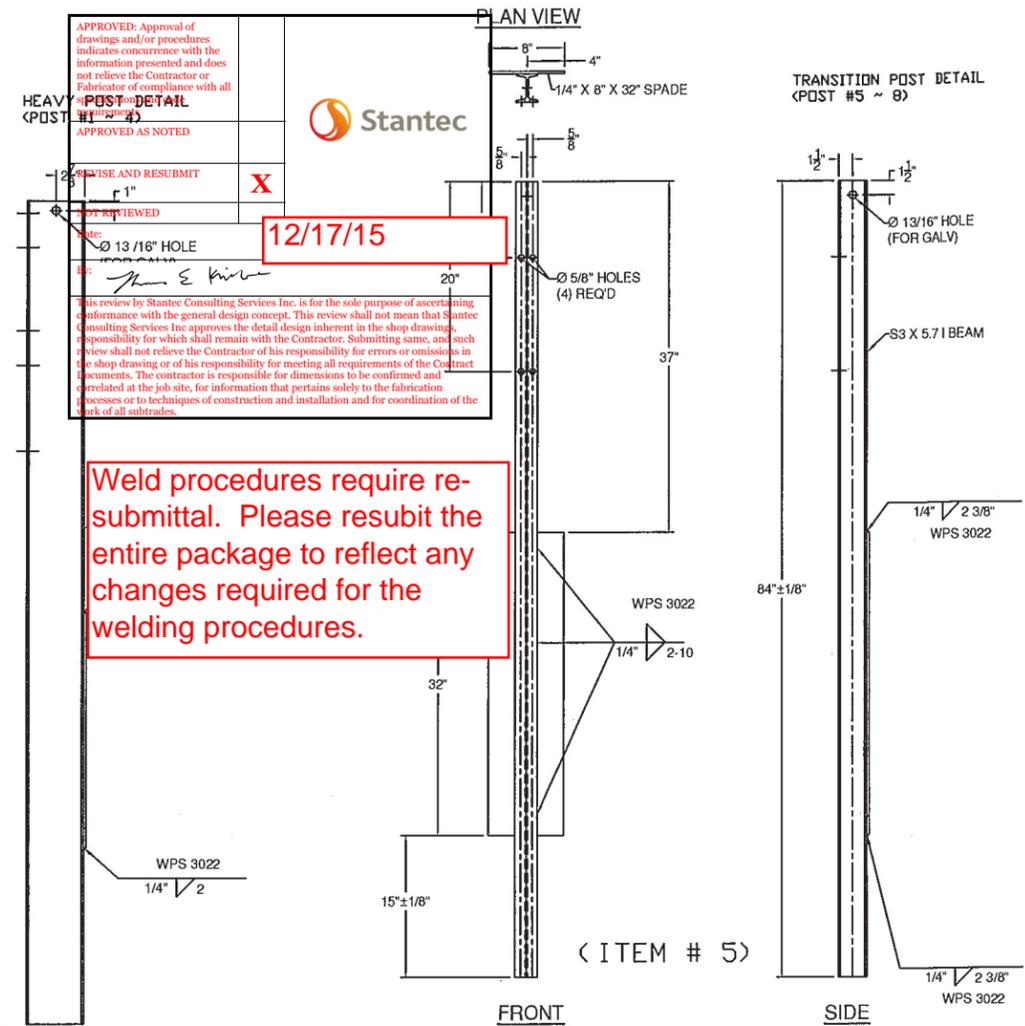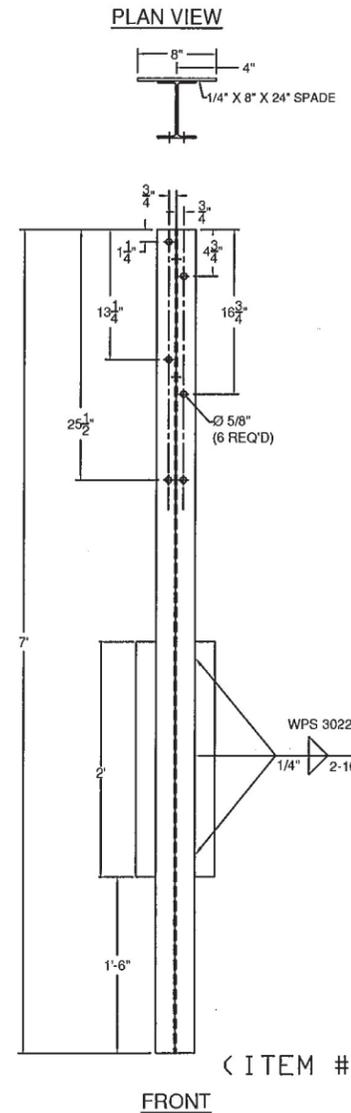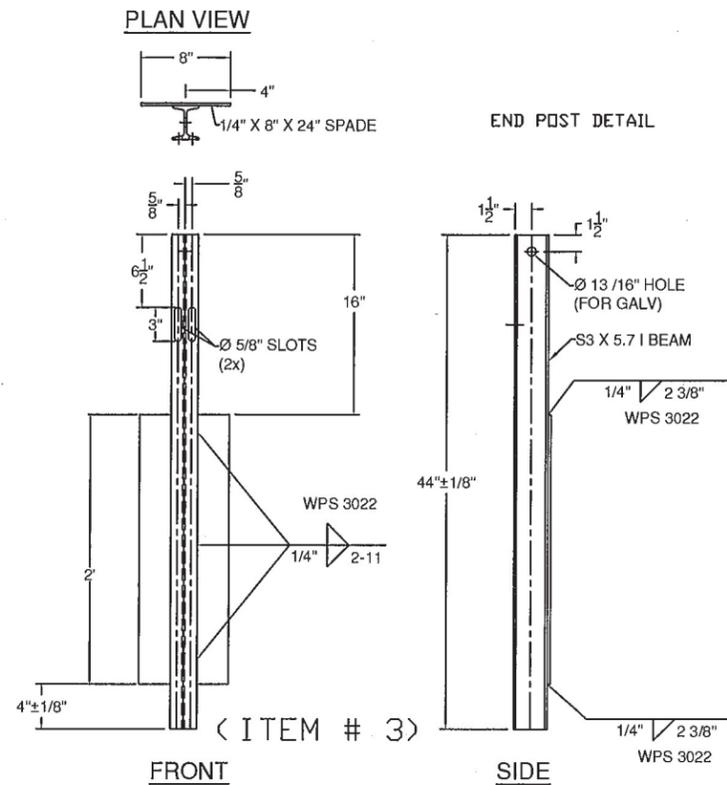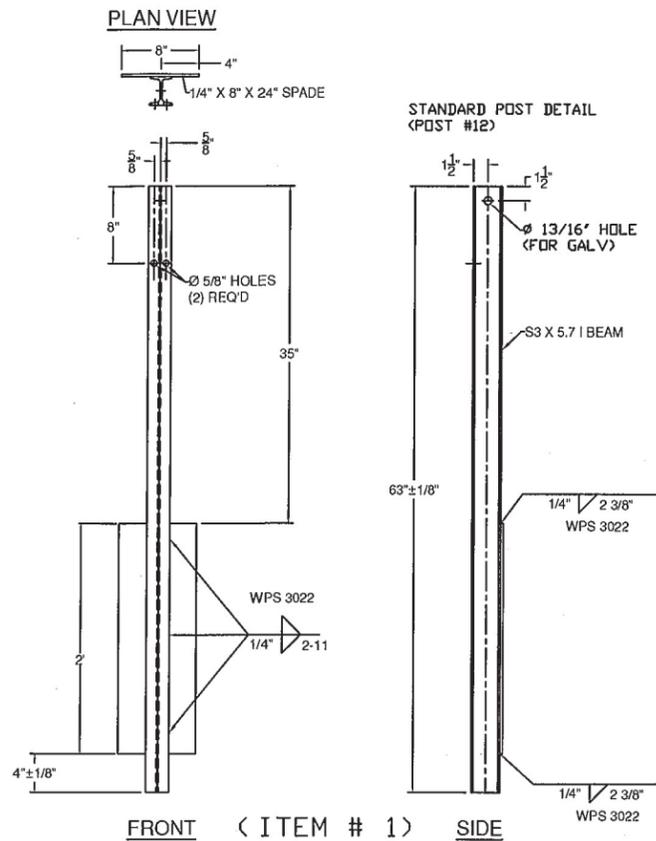

GENERAL NOTES:

- 1) ALL RAILING IS TO BE FABRICATED AND ERECTED ACCORDING TO SECTION 525 OF THE STANDARD SPECIFICATIONS.
- 2) BOLTS SHALL BE TORQUED SNUG TIGHT (APPROXIMATELY 100 FT-LB).
- 3) PROTRUSIONS CAUSED BY WELDING OR GALVANIZING ARE NOT PERMITTED ON THE ADJOINING SURFACES OF THE BOX BEAM RAILS, SPLICE TUBES AND FILL PLATES.
- 4) BOX BEAM TUBE AND STEEL POST MATERIALS, DIMENSION SIZES AND NOTES SHALL BE THE SAME AS THOSE OF THE BRIDGE RAIL, UNLESS OTHERWISE NOTED.
- 5) ANY BENDING OF RAIL SHALL BE DONE AT THE FABRICATION PLANT. RADII GREATER THAN 16" TO BE CURVED ON A TUBE BENDING MACHINE, RADII EQUAL OR LESS THAN 16" TO BE "PIE CUT" AND WELDED. CURVED RAILING WILL HAVE AN 18" LENGTH ON EACH END STRAIGHT TO ACCOMADATE SPLICES. "PIE CUTS ARE LOCATED SO AS TO NOT CONFLICT WITH POST FASTENING HOLES. PIE CUTS WILL BE WELDED ACCORDING TO PROCEDURE WPS-3026.

BILL OF MATERIALS (EACH CORNER)				
ITEM #	QTY.	COMPONENT #	DESCRIPTION	MATERIAL (ASTM)
1	3	0013.57021	S3 X 5.7 POST, PUNCH 8' W/SPD @ 63' LG	ASTM A572 Gr. 50
2	3	0013.57025	S3 X 5.7 POST, PUNCH 8', & 20' W/SPD @ 63' LG	ASTM A572 Gr. 50
3	2	0013.57060	S3 X 5.7 END POST W/SPD @ 3'-8" LG	ASTM A572 Gr. 50
4	4	0013.09001	W6 X 9 POST @ 7' W/SPD & 5/8" HOLES	ASTM A572 Gr. 50
5	4	0013.57010	S3 X 5.7 POST, PUNCH 8' & 20', W/ØX32" SPADE @7'	ASTM A572 Gr. 50
6	1	0033.80403	3 X 5' BTM TRANS RAIL W/5'-0" KB, EXP END	A500 Gr. B
7	1	0033.00640	HSS 5X5 TUBE SPLICE @27' LG W/ 1/4" SHIMS	A500 Gr. B / A572 Gr 50
8	2	0033.00730	HSS 5x5 EXP TUBE SPLICE @ 36" LG W/ 1/4" SHIMS	A500 Gr. B / A572 Gr 50
9	1	0033.00930	BR EXP BAR SPLICE 2-1/8" X 4-1/4" @ 36" LG	ASTM A36
10	19	0054.00050	REG BB SHELF ANGLES @ 4-1/2"	ASTM A36
12	1	0054.00074	HSS 5 X 5 X 5/16" DBL BEND TUBE SPL @ 27' LG,	A500 Gr. B / A572 Gr 50
13	8	0054.00563	6 X 8 X 1/4" TRANS. TUBE B/D @ 6' LG	A500 Gr. B
14	3	0054.00565	6 X 8 X 1/4" TRANS. TUBE B/D @ 3' LG	A500 Gr. B
15	1	0054.09000	6 X 6 X 3/16" BB @ 9'-0" KICKBACK, W/ CAP, & 13° MITER	A500 Gr. B / A36
*16A	1	T.B.D.	6 X 6 X 3/16" BB @ 9'-0" (THIS PAY ITEM), DRILL 3" CC, 620' CONVEX	A500 Gr. B
*16B	1	T.B.D.	6 X 6 X 3/16" BB @ 9'-0" (THIS PAY ITEM), DRILL 3" CC, 650' CONCAVE	A500 Gr. B
*17A	1	T.B.D.	6 X 6 X 3/16" BB TOP TRANS @ 20'-9 5/8" LG W/EXP END, 620' CONVEX	A500 Gr. B
*17B	1	T.B.D.	6 X 6 X 3/16" BB TOP TRANS @ 20'-9 5/8" LG W/EXP END, 650' CONCAVE	A500 Gr. B
*18A	1	T.B.D.	6 X 6 X 3/16" BB BTM TRANS @ 21'-4 5/8" LG W/EXP END, 620' CONVEX	A500 Gr. B
*18B	1	T.B.D.	6 X 6 X 3/16" BB BTM TRANS @ 21'-4 5/8" LG W/EXP END, 650' CONCAVE	A500 Gr. B
19	18	0080.03355	3/8" X 7 1/2" BOLT, NUT, & 2 FW	A307, A563 DH, F436
20	19	0080.04100	1/2" x 1-1/2" BOLT, NUT, & FW	A307, A563 DH, F436
21	22	0080.04120	1/2" x 1-1/2" BOLT, NUT, 2 FW & LW	A307, A563 DH, F436
22	4	0080.06255	3/4" X 4-1/2" BOLT, NUT, 2 FW	A325, A563 DH, F436
23	12	0080.06340	3/4" X 7-1/2" BOLT, NUT, 2 FW	A325, A563 DH, F436
24	6	0080.06370	3/4" X 8" CARR BOLT, NUT, FW & LW	A307, A563 DH, F436
25	2	0080.06400	3/4" X 8" BOLT, NUT, 2 FW, & LW	A325, A563 DH, F436

* ITEM #'S 16, 17, & 18 - WW 1 & 3 TO HAVE 620' CONVEX RADIUS, WW 2 & 4 TO HAVE 650' CONCAVE RADIUS

APPROVED: Approval of drawings and/or procedures indicates concurrence with the information presented and does not relieve the Contractor or Fabricator of compliance with all requirements of the Contract Documents. APPROVED AS NOTED

DATE: 12/17/15

Weld procedures require re-submittal. Please resubmit the entire package to reflect any changes required for the welding procedures.

HARDWARE NOTES	
ITEM #	FUNCTION
19	BOLT RAIL TO SHELF ANGLE (ITEM #10)
20	BOLT SHELF ANGLE (ITEM #'S 10 & 11) TO POST
21	BOLT BLOCK-OUTS (ITEM #'S 13 & 14) TO HEAVY POST
22	(4) PER SPLICE BAR (ITEM #9)
23	(4) PER SPLICE TUBING (ITEM #'S 7 & 8)
24	BOLT RAIL (ITEMS #'S 6,17, & 18 TO BLOCK-OUTS (ITEM #'S 13 & 14) [WHERE FASTENED])
25	BOLT DOUBLE BEND SPLICE TUBE (ITEM #12) TO RAIL (ITEM #18) & KICKBACK (ITEM #15)

APPLICABLE NOTES IN THE BRIDGE RAIL DRAWING SHALL ALSO BE APPLICABLE ON THESE DRAWINGS

ITEM #: 621.725

STRUCTURAL STEEL TO COMPLY W/ ASTM A6

TOLERANCE UNLESS OTHERWISE NOTED:
 FRACTIONS = ± 1/16"
 ANGLES = ± 1/2"
 DIAMETERS = ± 1/32"

SHEET 2 OF 5

GUARD RAIL TO BRIDGE RAIL TRANSITION DETAILS SHEET

VERMONT ROUTE 106 (MAJOR COLLECTOR, RURAL), BRIDGE # 24
 TOWN OF WOODSTOCK, COUNTY OF WINDSOR, VT.


R NO.	DATE	DESCRIPTION	BY	R NO.	DATE	DESCRIPTION	BY

ELDERLEE, INC.
 OAKS CORNERS, NEW YORK 14518
 email: dlong@elderlee.com / epeek@elderlee.com
 Tel: 315-789-6670 Fax: 315-789-6615

CERTIFIED FABRICATOR
 ORTHOGRAPHIC PROJECTION



DRAWN	E.P.	11/30/15
CHECKED	D.L.	11/30/15
APPROVED		
SCALE		

DRAWING NO. F.R. LAFAYETTE-WOODSTOCK (21)

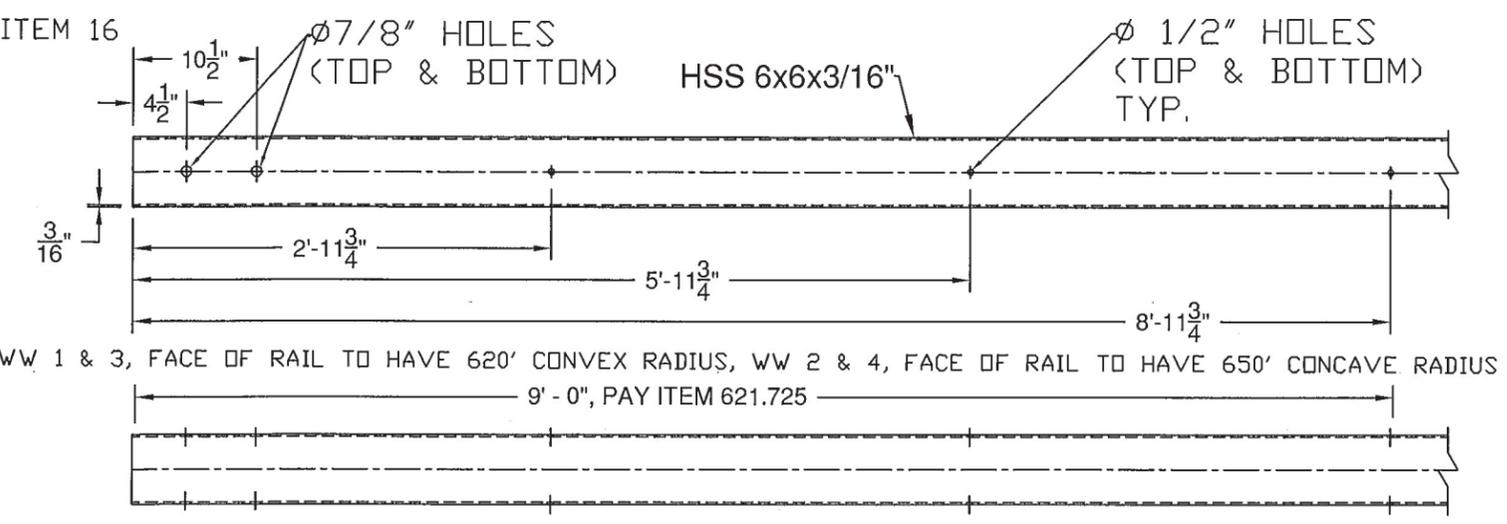

Weld procedures require re-submittal. Please resubmit the entire package to reflect any changes required for the welding procedures.

APPROVED: Approval of drawings and/or procedures indicates concurrence with the information presented and does not relieve the Contractor or Fabricator of compliance with all specifications and code requirements		
APPROVED AS NOTED		
REVISE AND RESUBMIT	X	
NOT REVIEWED		
Date:	12/17/15	
By:		
This review by Stantec Consulting Services Inc. is for the sole purpose of ascertaining conformance with the general design concept. This review shall not mean that Stantec Consulting Services Inc. approves the detail design inherent in the shop drawings, responsibility for which shall remain with the Contractor. Submitting same, and such review shall not relieve the Contractor of his responsibility for errors or omissions in the shop drawing or of his responsibility for meeting all requirements of the Contract Documents. The contractor is responsible for dimensions to be confirmed and correlated at the job site, for information that pertains solely to the fabrication processes or to techniques of construction and installation and for coordination of the work of all subtrades.		

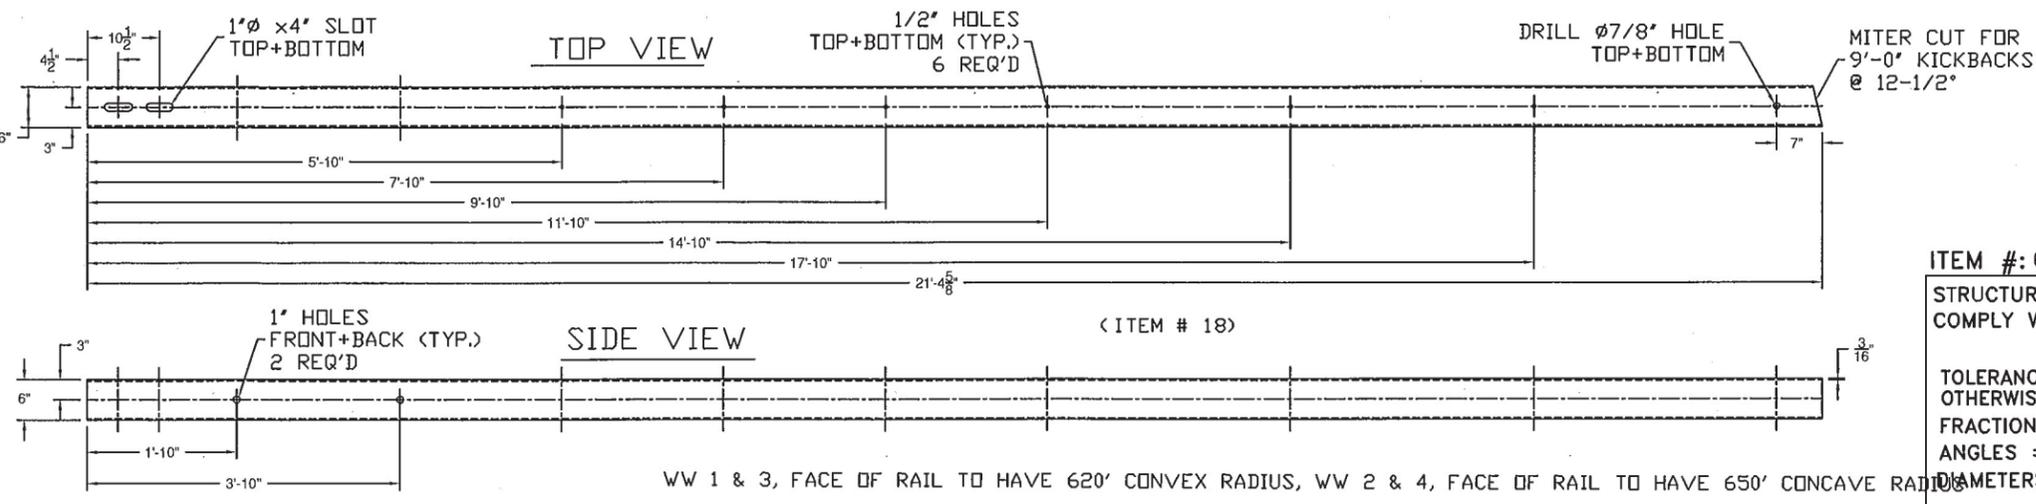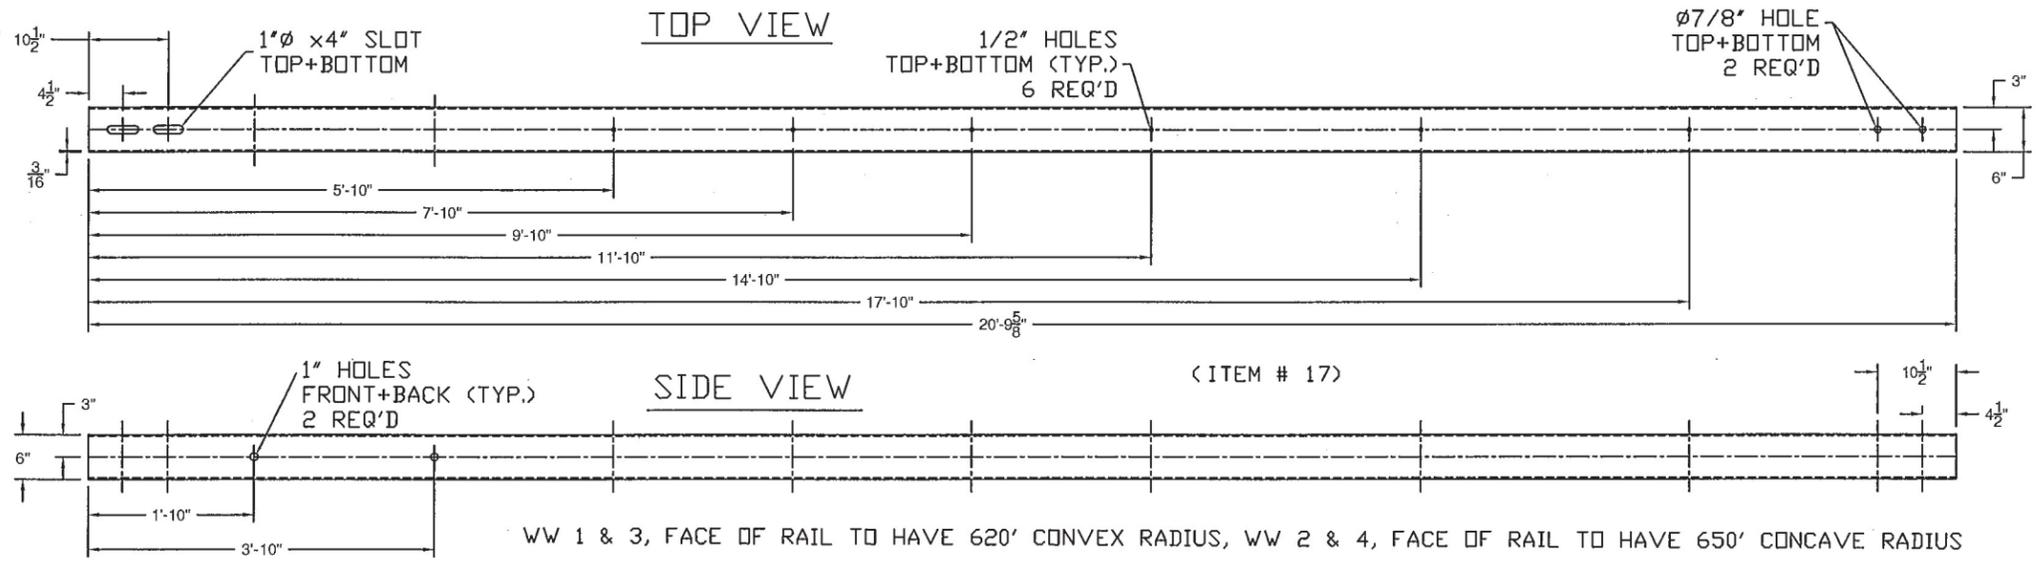

ITEM #: 621.725
 STRUCTURAL STEEL TO COMPLY W/ ASTM A6
 TOLERANCE UNLESS OTHERWISE NOTED:
 FRACTIONS = ± 1/16"
 ANGLES = ± 1/2°
 DIAMETERS = ± 1/32"

SHEET 4 OF 5

GUARD RAIL TO BRIDGE RAIL TRANSITION DETAILS SHEET

VERMONT ROUTE 106 (MAJOR COLLECTOR, RURAL), BRIDGE # 24
TOWN OF WOODSTOCK, COUNTY OF WINDSOR, VT.

R NO.	DATE	DESCRIPTION	BY	R NO.	DATE	DESCRIPTION	BY



DRAWN	E.P.	11/30/15
CHECKED	D.L.	11/30/15
APPROVED		
SCALE	SCHEMATIC	

DRAWING NO. F.R. LAFAYETTE-WOODSTOCK (2)

ELDERLEE, INC.



OAKS CORNERS, NEW YORK 14518
 email: dlong@elderlee.com / epeek@elderlee.com
 Tel: 315-789-6670 Fax: 315-789-6615

SPLICE BAR - EXPANSION

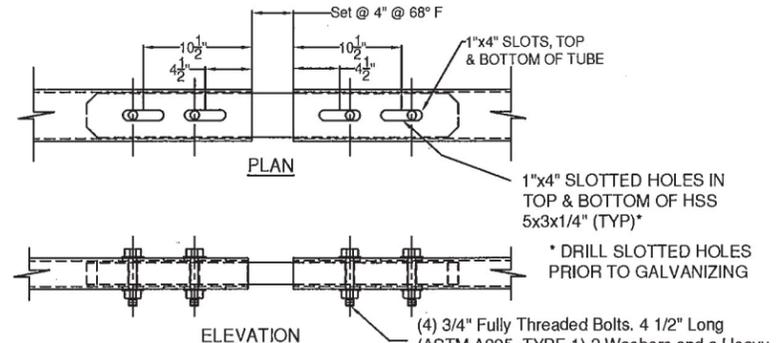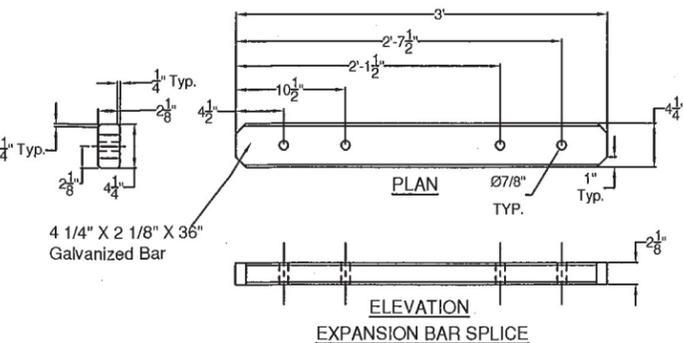

< ITEM # 9 >



SPLICE TUBE - EXPANSION

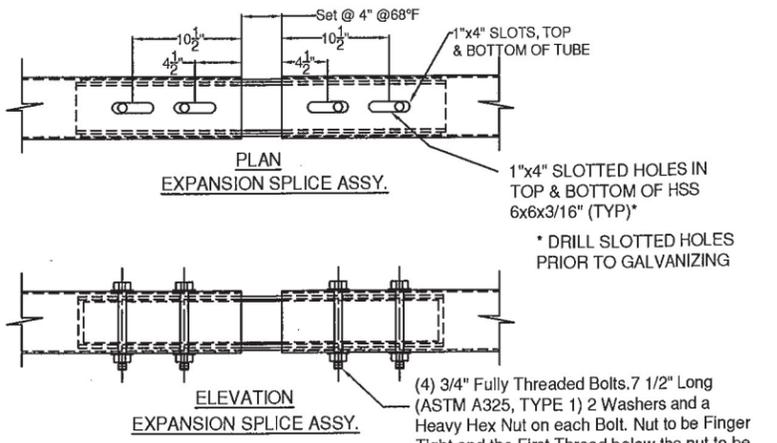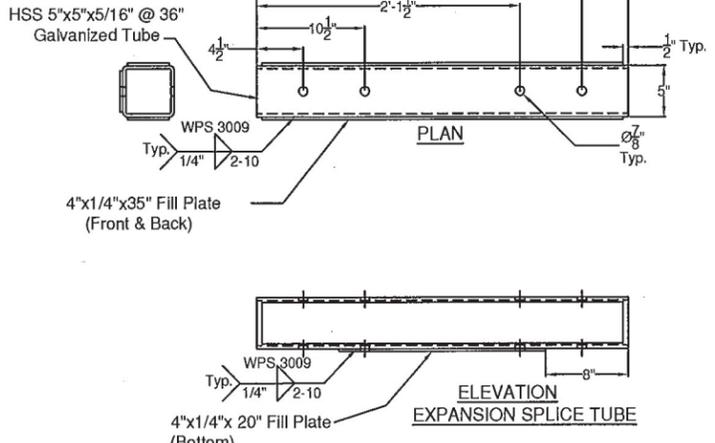

< ITEM # 8 >

Weld procedures require re-submittal. Please resubmit the entire package to reflect any changes required for the welding procedures.

APPROVED: Approval of drawings and/or procedures indicates concurrence with the information presented and does not relieve the Contractor or Fabricator of compliance with all specifications and code requirements		
APPROVED AS NOTED		
REVISE AND RESUBMIT	X	
NOT REVIEWED		
Date:	12/17/15	
By:	<i>John E. Kirsh</i>	
<small>This review by Stantec Consulting Services Inc. is for the sole purpose of ascertaining conformance with the general design concept. This review shall not mean that Stantec Consulting Services Inc approves the detail design inherent in the shop drawings, responsibility for which shall remain with the Contractor. Submitting same, and such review shall not relieve the Contractor of his responsibility for errors or omissions in the shop drawing or of his responsibility for meeting all requirements of the Contract Documents. The contractor is responsible for dimensions to be confirmed and correlated at the job site, for information that pertains solely to the fabrication processes or to techniques of construction and installation and for coordination of the work of all subtrades.</small>		

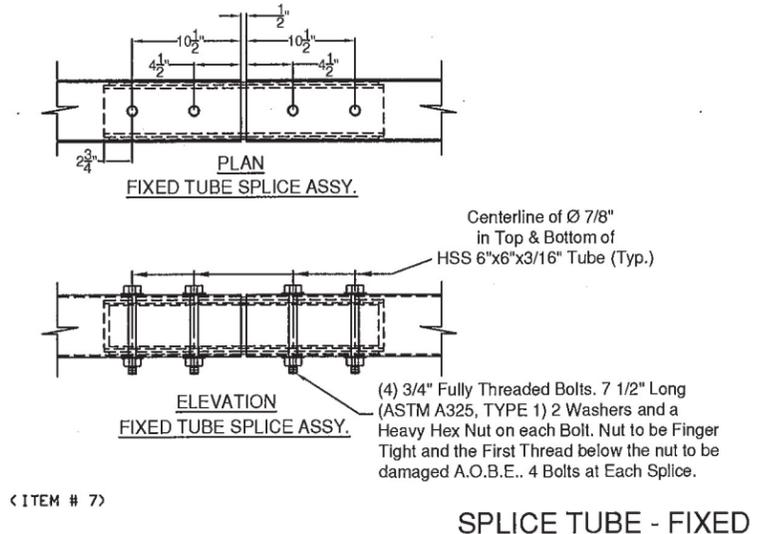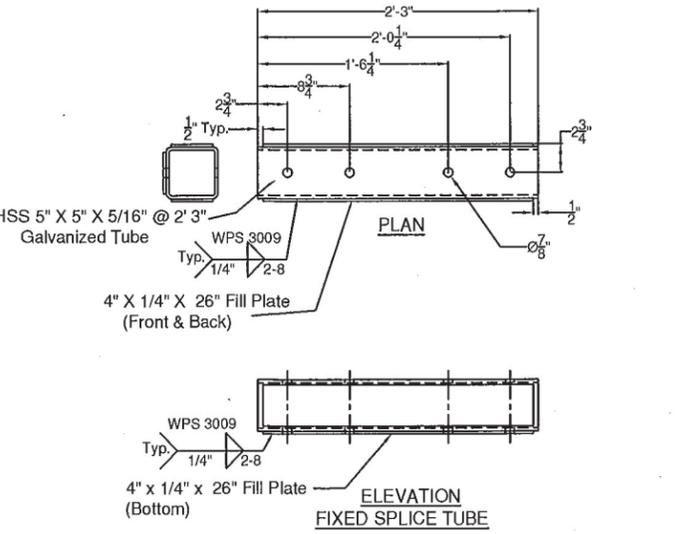

< ITEM # 7 >

SPLICE TUBE - FIXED

ITEM #: 621.725

SHEET 5 OF 5

STRUCTURAL STEEL TO COMPLY W/ ASTM A6

GUARD RAIL TO BRIDGE RAIL TRANSITION DETAILS SHEET

VERMONT ROUTE 106 (MAJOR COLLECTOR, RURAL), BRIDGE # 24

TOWN OF WOODSTOCK, COUNTY OF WINDSOR, VT.

TOLERANCE UNLESS OTHERWISE NOTED:
 FRACTIONS = ± 1/16"
 ANGLES = ± 1/2"
 DIAMETERS = ± 1/32"

R	NO.	DATE	DESCRIPTION	BY	R	NO.	DATE	DESCRIPTION	BY
E					E				
V					V				

DRAWN	E.P.	11/30/15
CHECKED	D.L.	11/30/15
APPROVED		
SCALE	SCHMATIC	
DRAWING NO. F.R. LAFAYETTE-WOODSTOCK (21)		

ELDERLEE, INC.
 OAKS CORNERS, NEW YORK 14518
 email: dlong@elderlee.com / epsek@elderlee.com
 Tel: 315-789-6670 Fax: 315-789-6615

ORTHOGONAL PROJECTION

WELDING PROCEDURE SPECIFICATION

PQR ELDERLEE#3

Material Specification	A500 GR B to A572 GR 50
Welding Process	FCAW-G
Manual or Machine	SEMAUTOMATIC
Position of Welding	FLAT/HORIZONTAL
Filler Metal Specification	A5.29
Filler Metal Classification	E81T1-Ni1C-JH4
Flux	N/A
Shielding Gas	CO 2 Dew Point -40DEG F Flow Rate 50CFH
Single or Multiple Pass	SINGLE
Single or Multiple Arc	SINGLE
Welding Current	DC
Polarity	REVERSE ELECTRODE POSITIVE
Welding Progression	STRINGER
Root Treatment	PER D1.5
Preheat and Interpass Temperature	PER D1.5
Postheat Temperature	NONE
Heat Input	Min _____ Max _____

WELDING PROCEDURE

Pass no.	Electrode size	Welding Current		Travel speed	Joint detail
		Amperes	Volts		
1	1/16	310	25	11	
Variable	LIMITS	341	27	12	
		TO	TO	TO	
		269	23	10	

30 deg.

B-U2a-F

Is this a NY joint detail?

3/16

This procedure may vary due to fabrication sequence, fit-up, pass size, etc., within the limitation of variables given in Section 5.

Procedure No. 3007

Contractor Elderlee, Inc.

Revision No. _____

Authorized By RANDY SCOTT

Date 7/28/2014

WELDING PROCEDURE SPECIFICATION

PQR ELDERLEE #3

Material Specification	A709 TO A500 GR B
Welding Process	FCAW-G
Manual or Machine	SEMAUTOMATIC
Position of Welding	FLAT/HORIZONTAL
Filler Metal Specification	A5.29
Filler Metal Classification	E81T1-Ni1C-JH4
Flux	N/A
Shielding Gas	CO 2 Dew Point -40DEG F Flow Rate 50CFH
Single or Multiple Pass	SINGLE
Single or Multiple Arc	SINGLE
Welding Current	DC
Polarity	REVERSE ELECTRODE POSITIVE
Welding Progression	STRINGER
Root Treatment	D1.5
Preheat and Interpass Temperature	D1.5
Postheat Temperature	NONE
Heat Input	Min _____ Max _____

WELDING PROCEDURE.

Pass no.	Electrode size	Welding Current		Travel speed	Joint detail
		Amperes	Volts		
1	1/16	310	25	11	
Variable	LIMITS	341	27	12	
		TO 269	TO 23	TO 10	

This procedure may vary due to fabrication sequence, fit-up, pass size, etc., within the limitation of variables given in Section 5.

Procedure No. 3009

Contractor Elderlee, Inc.

Revision No. _____

Authorized By RANDY SCOTT


Date 3/20/2014

WELDING PROCEDURE SPECIFICATION

PQR ELDERLEE #3

Material Specification	A500 TO A572 GR 50
Welding Process	FCAW-G
Manual or Machine	SEMAUTOMATIC
Position of Welding	FLAT/HORIZONTAL
Filler Metal Specification	A5.29
Filler Metal Classification	E81T1-Ni1C-JH4
Flux	N/A
Shielding Gas	CO 2 Dew Point -40DEG F Flow Rate 50CFH
Single or Multiple Pass	SINGLE
Single or Multiple Arc	SINGLE
Welding Current	DC
Polarity	REVERSE
Welding Progression	STRINGER
Root Treatment	PER D1.5
Preheat and Interpass Temperature	PER D1.5
Postheat Temperature	NONE
Heat Input	Min _____ Max _____

WELDING PROCEDURE

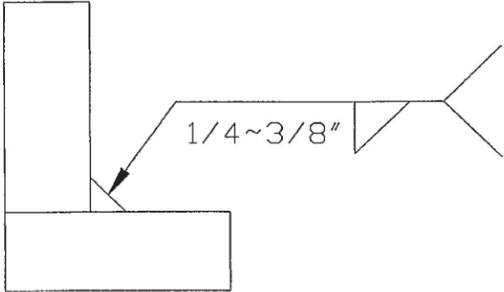Pass no.	Electrode size	Welding Current		Travel speed	Joint detail
		Amperes	Volts		
1	1/16	310	25	11	
Variable	LIMITS	341	27	12	
		TO 269	TO 23	TO 10	

This procedure may vary due to fabrication sequence, fit-up, pass size, etc., within the limitation of variables given in Section 5.

Procedure No. 3016

Contractor Elderlee, Inc.

Revision No. _____

Authorized By RANDY SCOTT

Date 8/4/2014

WELDING PROCEDURE SPECIFICATION

Material Specification	A572 GR 50	
Welding Process	GMAW	
Manual or Machine	SEMIAUTOMATIC/ROBOTIC	
Position of Welding	FLAT/HORIZONTAL	
Filler Metal Specification	A5.18	
Filler Metal Classification	L-56	LINCOLN
Flux	N/A	
Shielding Gas	90% ARGON /10% CO2 Dew Point -40DEG F Flow Rate 45CFH	
Single or Multiple Pass	SINGLE	
Single or Multiple Arc	SINGLE	
Welding Current	DC	
Polarity	REVERSE	
Welding Progression	STRINGER	
Root Treatment	PER D1.5	
Preheat and Interpass Temperature	PER D1.5	
Postheat Temperature	NONE	
Heat Input	Min _____	Max _____

WELDING PROCEDURE

Pass no.	Electrode size	Welding Current		Travel speed	Joint detail
		Amperes	Volts		
Variable	LIMITS	190	22	19	
		171	20	17	
		TO	TO	TO	
		209	24	21	

This procedure may vary due to fabrication sequence, fit-up, pass size, etc., within the limitation of variables given in Section 5.

Procedure No. 3022

Contractor Elderlee, Inc.

Revision No. _____

Authorized By RANDY SCOTT

Date 3/20/2014