

I ABUTMENT #1 ELEVATION
F2 1/2" = 1'-0"

Vermont Agency of Transportation
RECEIVED
 CK'D BY OK'D BY Rob Young
 May 1, 2015
 RESUBMIT No Approved
 BY Rob Young DATE 05/04/2015

SHOP DRAWING REVIEW


REVIEWED AS REQUIRED BY THE CONSTRUCTION CONTRACT DOCUMENTS AND APPROVED, BUT ONLY FOR CONFORMANCE TO THE DESIGN CONCEPT OF THE WORK AND SUBJECT TO FURTHER LIMITATIONS AND REQUIREMENTS CONTAINED IN THE CONSTRUCTION CONTRACT DOCUMENTS.

REJECTED REVISE AND RESUBMIT APPROVED AS NOTED


CORRECTIONS OR COMMENTS MADE ON THE SHOP DRAWINGS DURING THIS REVIEW DO NOT RELIEVE CONTRACTOR FROM COMPLIANCE WITH REQUIREMENTS OF THE DRAWINGS AND SPECIFICATIONS. THIS CHECK IS ONLY FOR REVIEW OF GENERAL CONFORMANCE WITH THE DESIGN CONCEPT OF THE PROJECT AND GENERAL COMPLIANCE WITH THE INFORMATION GIVEN IN THE CONTRACT DOCUMENTS. THE CONTRACTOR IS RESPONSIBLE FOR CONFIRMING AND CORRELATING ALL QUANTITIES AND DIMENSIONS, SELECTING FABRICATION PROCESSES AND TECHNIQUES OF CONSTRUCTION, COORDINATING THEIR WORK WITH THAT OF ALL OTHER TRADES, AND PERFORMING THEIR WORK IN A SAFE AND SATISFACTORY MANNER.

CLD Consulting Engineers
 840 Commercial Street
 Manchester, NH 03101
 603-688-8223


Job Number: 120121
 Reviewed by: SRB
 Date: 05/03/2015

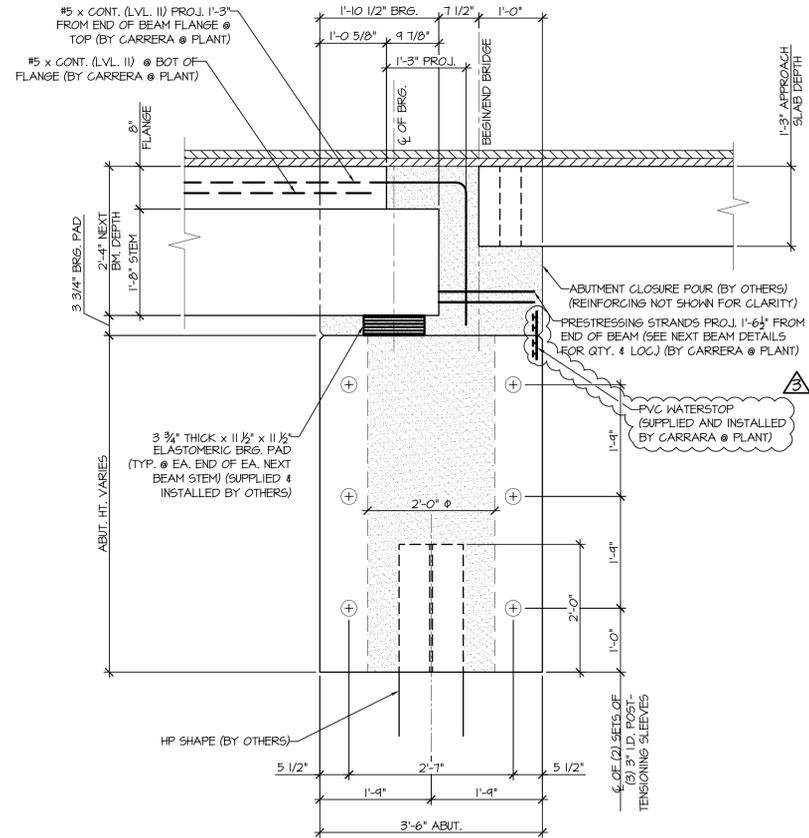


A BEARING SECTION
F2 3/4" = 1'-0"
 NEXT BEAM STEM BEARING

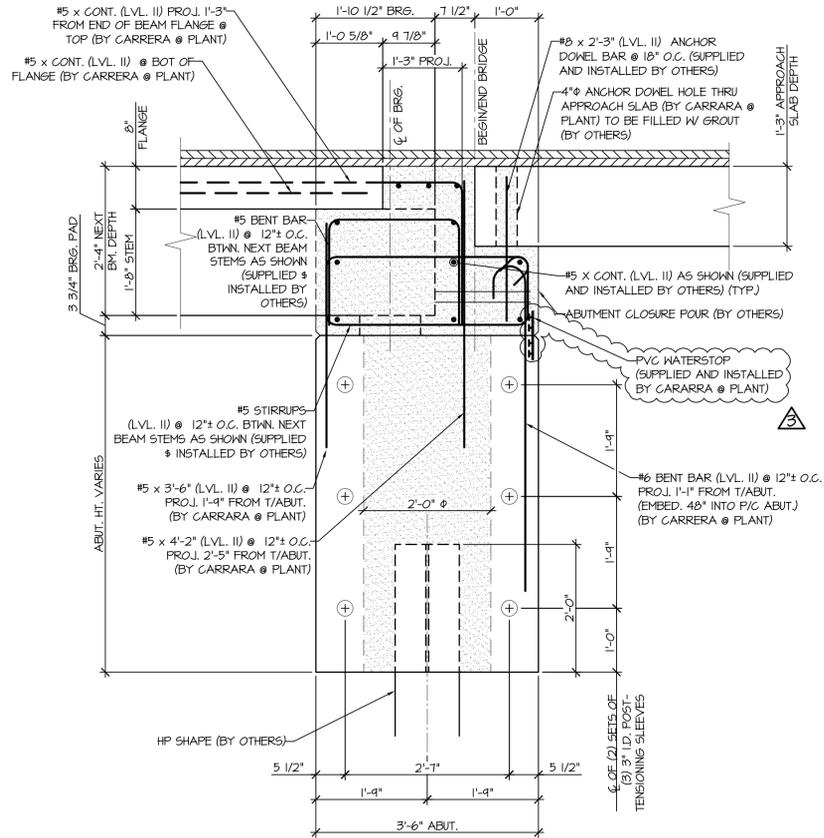

A.I BEARING SECTION
F2 3/4" = 1'-0"
 BETWEEN NEXT BEAM STEM BEARING

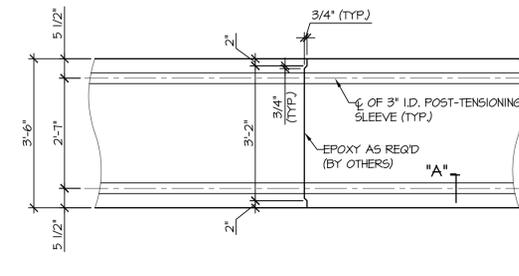

B MATCH CAST SECTION @
F2 P.T. SLEEVE 1/2" = 1'-0"

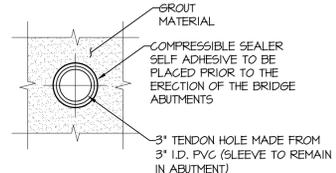

SECTION - "A"
 1/2" = 1'-0"

APPROVAL STAMP:	J.P. CARRARA & SONS INC. Precast & Prestress Manufacturer 2464 CASE STR., MIDDLEBURY, VERMONT 05753 Phone:(802)388-6361 Fax:(802)388-9010	T. BUCK CONSTRUCTION, INC. CONTRACTOR AUBURN, MAINE
STATE OF VERMONT AGENCY OF TRANSPORTATION COUNTY OF CALEDONIA		DATE: MAR. 26, 2015
TOWN OF BURKE VERMONT ROUTE 114 BRIDGE NO.: 13 PROJECT NO.: BRF 0269(13)		SCALE: NOTED
PRECAST ABUTMENT # 1 ELEVATION & SECTIONS		CHKD: DFTM: JDK JOB NO: 23454-015
		DWG. NO: F2