



PO Box 508
Barton, VT 05822
Phone: (802)525-9506
Fax: (802)525-4616
www.jpsicard.com

Submittal Data Sheet

Submittal #: 8A

Submission #: 2

Date: 5/23/2016

Project Name: Irasburg IM Deck (46)

Owner: Vermont Agency of Transportation

Engineer: VTrans

Contractor: J.P. Sicard, Inc.

Item Number: 507.11

Supplier: Dimension Fabricators, Inc.

Description of Item: 507.11 Reinforcing Steel, Placement Drawings: Span 1 Curb Reinforcing Placement REV1


Substitution: NO

Engineers Review Comments:

Submitted By: Brad Drake

Title: Project Manager

Company: JP Sicard, Inc.

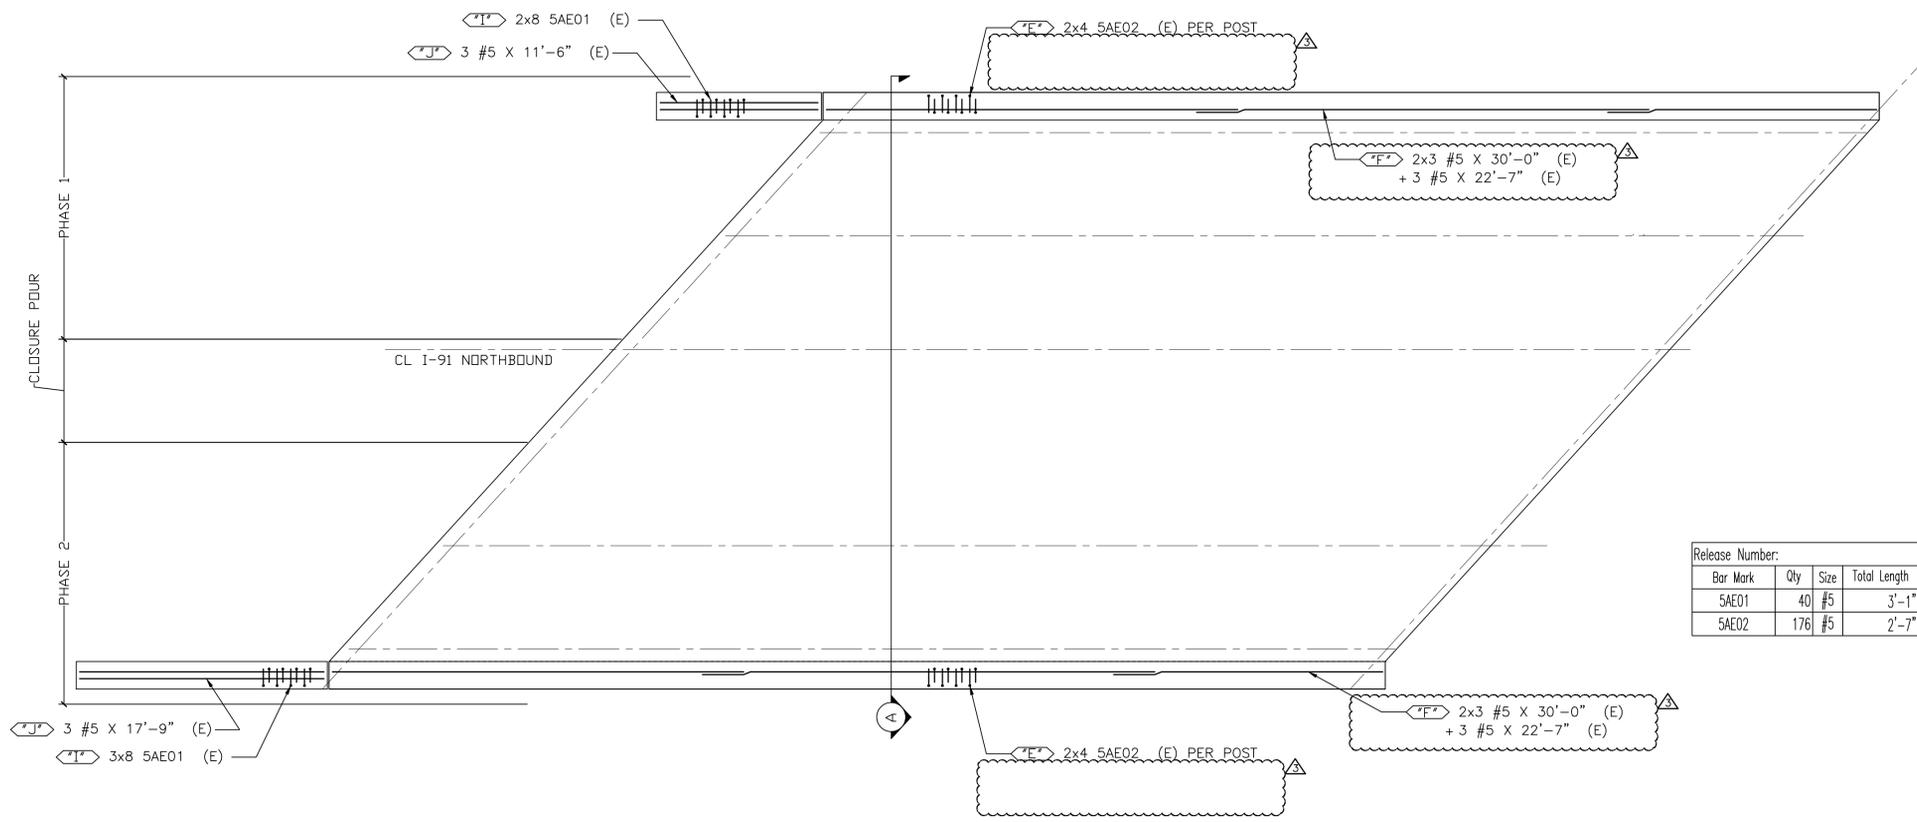

DECK REINFORCEMENT PLAN - SPAN #1
CONTRACT DWG. REF. 19 OF 49

SHOP DRAWING REVIEW

REVIEWED AS REQUIRED BY THE CONSTRUCTION CONTRACT DOCUMENTS AND APPROVED, BUT ONLY FOR CONFORMANCE TO THE DESIGN CONCEPT OF THE WORK, AND SUBJECT TO FURTHER LIMITATIONS AND REQUIREMENTS CONTAINED IN THE CONSTRUCTION CONTRACT DOCUMENTS.

REJECTED REVISE AND RESUBMIT APPROVED AS NOTED

CORRECTIONS OR COMMENTS MADE ON THE SHOP DRAWINGS DURING THIS REVIEW DID NOT RELIEVE CONTRACTOR FROM COMPLIANCE WITH REQUIREMENTS OF THE DRAWINGS AND SPECIFICATIONS. THIS CHECK IS ONLY FOR REVIEW OF GENERAL CONFORMANCE WITH THE DESIGN CONCEPT OF THE PROJECT AND GENERAL COMPLIANCE WITH THE INFORMATION GIVEN IN THE CONTRACT DOCUMENTS. THE CONTRACTOR IS RESPONSIBLE FOR CONFIRMING AND CORRELATING ALL QUANTITIES AND DIMENSIONS; SELECTING FABRICATION PROCESSES AND TECHNIQUES OF CONSTRUCTION; COORDINATING THEIR WORK WITH THAT OF ALL OTHER TRADES; AND PERFORMING THEIR WORK IN A SAFE AND SATISFACTORY MANNER.


CLD Consulting Engineers
340 Commercial Street
Manchester, NH 03101
603-666-6223

Job Number: 150223
Reviewed by: SRB
Date: 05/23/2015

Release Number: _____ BAR LIST

Bar Mark	Qty	Size	Total Length	Type	'a'	'b'	'c'	'd'	'e'	'f'	'g'	'h'	'i'	'k'	'o'	'r'
5AE01	40	#5	3'-1"	17		1'-4"	1'-9"									
5AE02	176	#5	2'-7"	17		1'-3"	1'-4"									

BAR MARKS MAY CHANGE, DUE TO REVISIONS

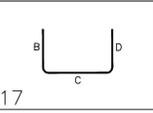


FOR APPROVAL

LAP CHART

#5	3'-0"
----	-------

Vermont Agency of Transportation
RECEIVED
ON: **May 23, 2016**
and Checked for
CONFORMANCE
BY: Jennifer Fitch DATE: 05/23/16

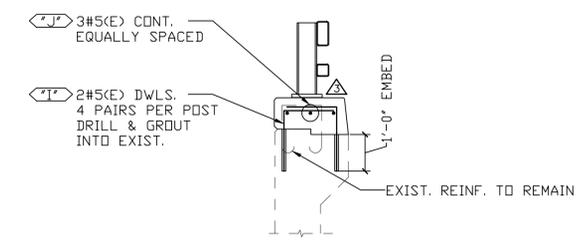

TYPICAL WINGWALL SECTION
CONTRACT DWG. REF. 24 OF 49


LEGEND:

CONT.-CONTINUOUS	E.E.-EACH END
TRANS.-TRANSVERSE	E.F.-EACH FACE
DWLS.-DWELS	F.F.-FRONT FACE
VERTS.-VERTICAL	R.F.-REAR FACE
HDRIZ.-HORIZONTAL	E.W.-EACH WAY
T&B -TOP & BOTTOM	D.C.-ON CENTER
I.F.-INNER FACE	L.W.-LONG WAY
O.F.-OUTER FACE	S.W.-SHORT WAY

ELEVATIONS & DIMENSIONS SHOWN ON THIS DWG. ARE FOR REINF. DETAILING PURPOSES ONLY AND ARE NOT INTENDED FOR DIMENSIONAL CONSTRUCTION.

EPOXY REINF. BARS ASTM A615 GRADE 60, MARKED (E)

VERIFICATION OF UNCLEAR INFORMATION MAY BE REQUESTED ON THIS DRAWING. SHOULD VERIFICATION BE LEFT UN-ADDRESSED IT WILL REMAIN AS SHOWN AND ASSUME TO BE CORRECT.

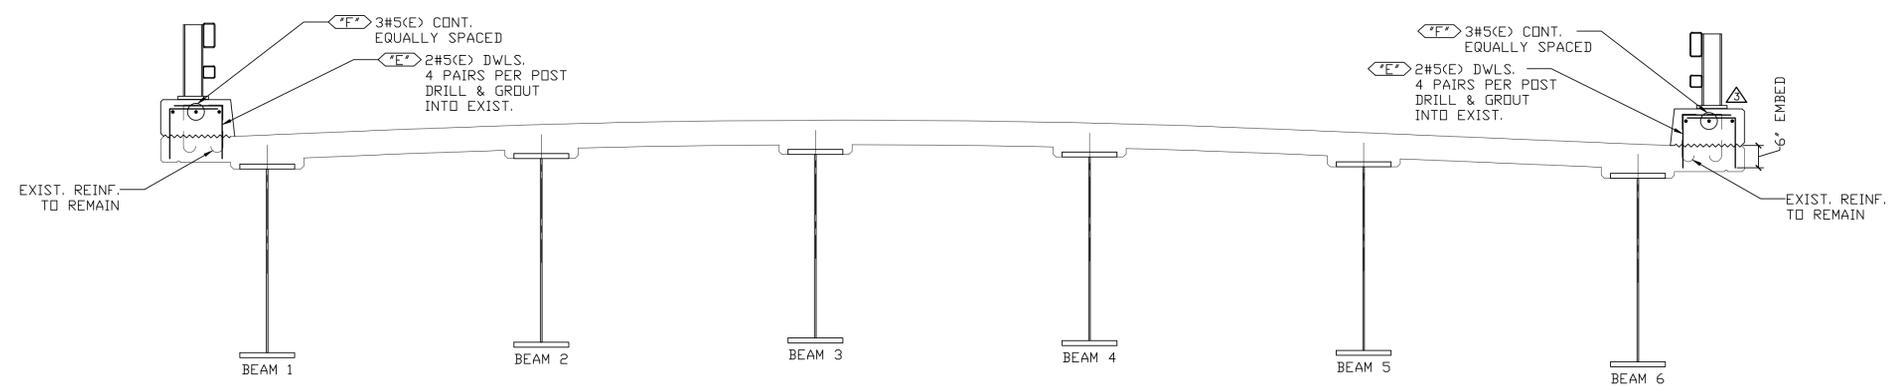

SECTION A
CONTRACT DWG. REF. A / 19 OF 49 & 24 OF 49

ALL REINF. EPOXY

6			
5			
4	5/23/16	△	REVISED PER APPROVAL / FOR APPROVAL
3	5/20/16	△	REVISED ENTIRE DWG. / FOR APPROVAL
2	5/6/16	△	REVISED PER APPROVAL / FOR APPROVAL
1	5/3/16	-	FOR APPROVAL
DATE	REV.#	SENT FOR	
2000 7TH STREET SCOTIA, N.Y. 12552 Ph: (518) 374-1936 Fax: (518) 374-4830 www.dimensionfabricators.com			
STRUCTURE:	VTAOT IRASBURG IM DECK (46)		
LOCATION:	INTERSTATE 91 (PRINCIPLE ARTERIAL) BRIDGE NO. 107N		
ARCHITECT:	TOWN OF IRASBURG, COUNTY OF ORLEANS		
ENGINEER:	CLD CONSULTING ENGINEERS		
CUSTOMER:	J.P. SICARD, INC.		
DRAWN BY:	DATE	DFI #	
CMB	4/26/16	9737	
DRAWING COVERS		DRAWING #	
DECK SLAB - SPAN 1		A	