

TRAFFIC CONTROL PLAN FOR THE ROCKINGHAM BRF 0126(12) PROJECT

SHEET S1-SIGNAL PLAN
SHEET S2-TRAFFIC SIGN LAY-OUT
SHEET S3-TRAFFIC SIGN LAY-OUT



Philip J. Savoy

T.Y. LIN INTERNATIONAL

THE STAMPED DOCUMENTS ARE HEREBY:

- APPROVED
- APPROVED AS NOTED
- REVISE AND RESUBMIT

SEE TRANSMITTAL FOR ADDITIONAL INFORMATION AS APPLICABLE.

THIS REVIEW IS FOR GENERAL CONFORMANCE WITH DESIGN CONCEPT ONLY. ANY DEVIATION FROM THE PLANS OR SPECIFICATIONS NOT CLEARLY NOTED BY THE CONTRACTOR HAS NOT BEEN REVIEWED. REVIEW BY THE ENGINEER SHALL NOT RELIEVE THE CONTRACTOR OF THE CONTRACTUAL RESPONSIBILITY FOR ANY ERRORS OR DEVIATION FROM THE CONTRACT REQUIREMENTS.

RICK HEBERT
REVIEWER

11/3/2014
DATE

APPROVED

By Todd Sumner at 11:32 am, Nov 05, 2014

PREPARED
BY
COLD RIVER BRIDGES, LLC

COLD RIVER BRIDGES, LLC 10 LANBRO LANE WALPOLE, NH TEL 603-756-9300 FAX 603-756-9303	
ROCKINGHAM BRF 0126 (12)	
TRAFFIC CONTROL PLAN	SHEET NUMBER
DATE: 10-22-14	COVER
scale:	

T.Y. LIN INTERNATIONAL

THE STAMPED DOCUMENTS ARE HEREBY:


- ____ APPROVED
- X APPROVED AS NOTED
- ____ REVISE AND RESUBMIT

SEE TRANSMITTAL FOR ADDITIONAL INFORMATION AS APPLICABLE.

THIS REVIEW IS FOR GENERAL CONFORMANCE WITH DESIGN CONCEPT ONLY. ANY DEVIATION FROM THE PLANS OR SPECIFICATIONS NOT CLEARLY NOTED BY THE CONTRACTOR HAS NOT BEEN REVIEWED. REVIEW BY THE ENGINEER SHALL NOT RELIEVE THE CONTRACTOR OF THE CONTRACTUAL RESPONSIBILITY FOR ANY ERRORS OR DEVIATION FROM THE CONTRACT REQUIREMENTS.

RICK HEBERT REVIEWER 11/3/2014 DATE

As discussed at the Pre-Construction Conference, moveable temporary concrete barrier should be placed behind the Type III Barricades and ahead of any hazard area to protect an errant vehicle that could mistakenly pass through the barricades. It is understood these barriers may be moved to provide for Contractor access during working hours, but they are to be in-place during nights or any other non-work hours.

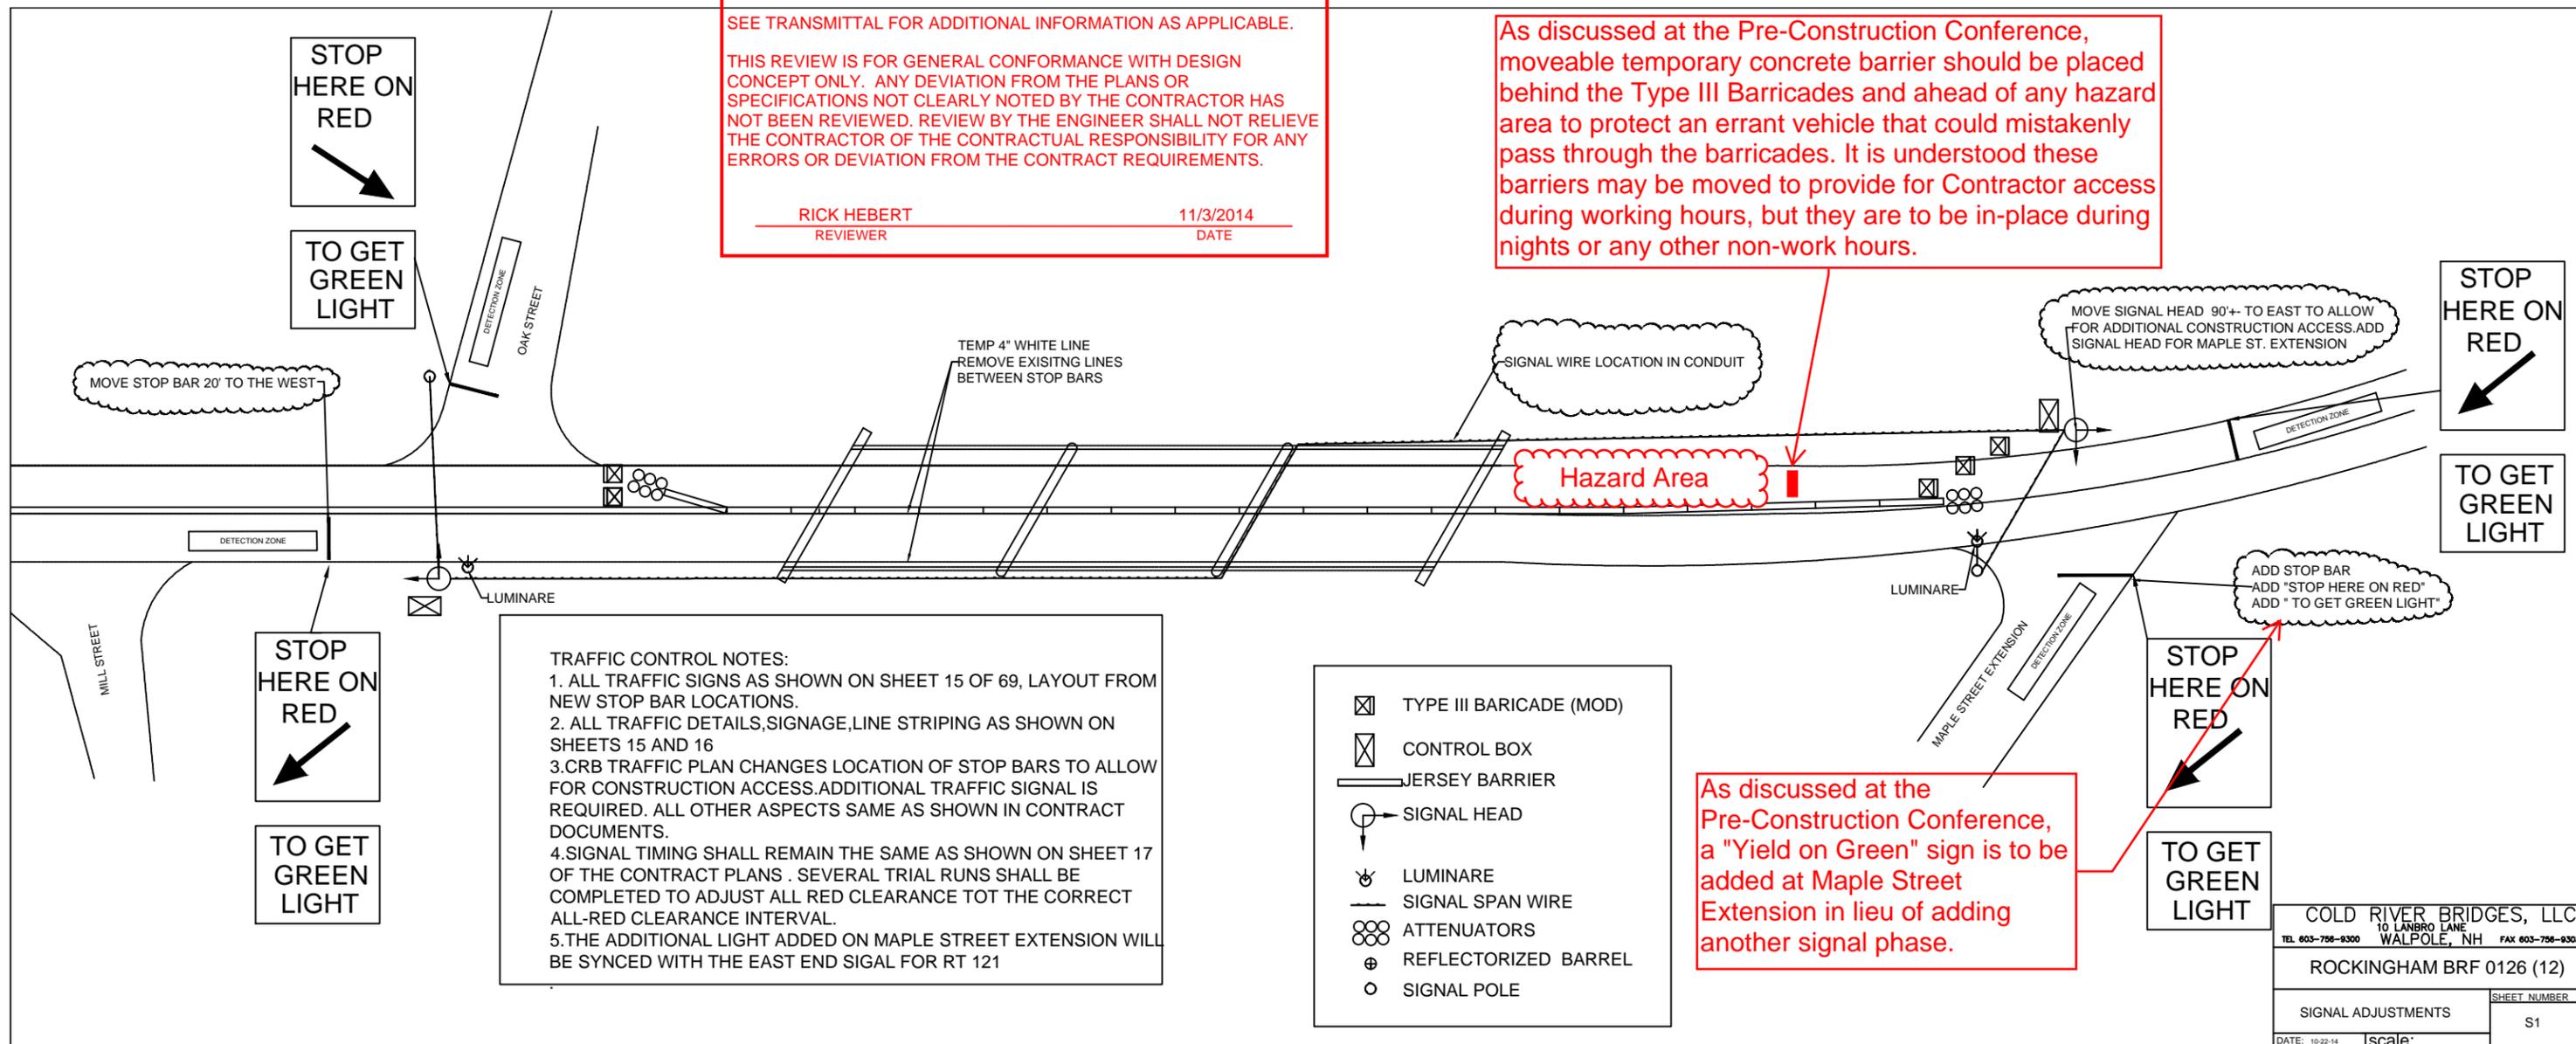


TRAFFIC CONTROL NOTES:

1. ALL TRAFFIC SIGNS AS SHOWN ON SHEET 15 OF 69, LAYOUT FROM NEW STOP BAR LOCATIONS.
2. ALL TRAFFIC DETAILS, SIGNAGE, LINE STRIPING AS SHOWN ON SHEETS 15 AND 16
3. CRB TRAFFIC PLAN CHANGES LOCATION OF STOP BARS TO ALLOW FOR CONSTRUCTION ACCESS. ADDITIONAL TRAFFIC SIGNAL IS REQUIRED. ALL OTHER ASPECTS SAME AS SHOWN IN CONTRACT DOCUMENTS.
4. SIGNAL TIMING SHALL REMAIN THE SAME AS SHOWN ON SHEET 17 OF THE CONTRACT PLANS. SEVERAL TRIAL RUNS SHALL BE COMPLETED TO ADJUST ALL RED CLEARANCE TO THE CORRECT ALL-RED CLEARANCE INTERVAL.
5. THE ADDITIONAL LIGHT ADDED ON MAPLE STREET EXTENSION WILL BE SYNCED WITH THE EAST END SIGNAL FOR RT 121

- ☒ TYPE III BARRICADE (MOD)
- ☒ CONTROL BOX
- JERSEY BARRIER
- ⊙ SIGNAL HEAD
- ⊙ LUMINAIRE
- SIGNAL SPAN WIRE
- ⊙ ATTENUATORS
- ⊙ REFLECTORIZED BARREL
- SIGNAL POLE

As discussed at the Pre-Construction Conference, a "Yield on Green" sign is to be added at Maple Street Extension in lieu of adding another signal phase.

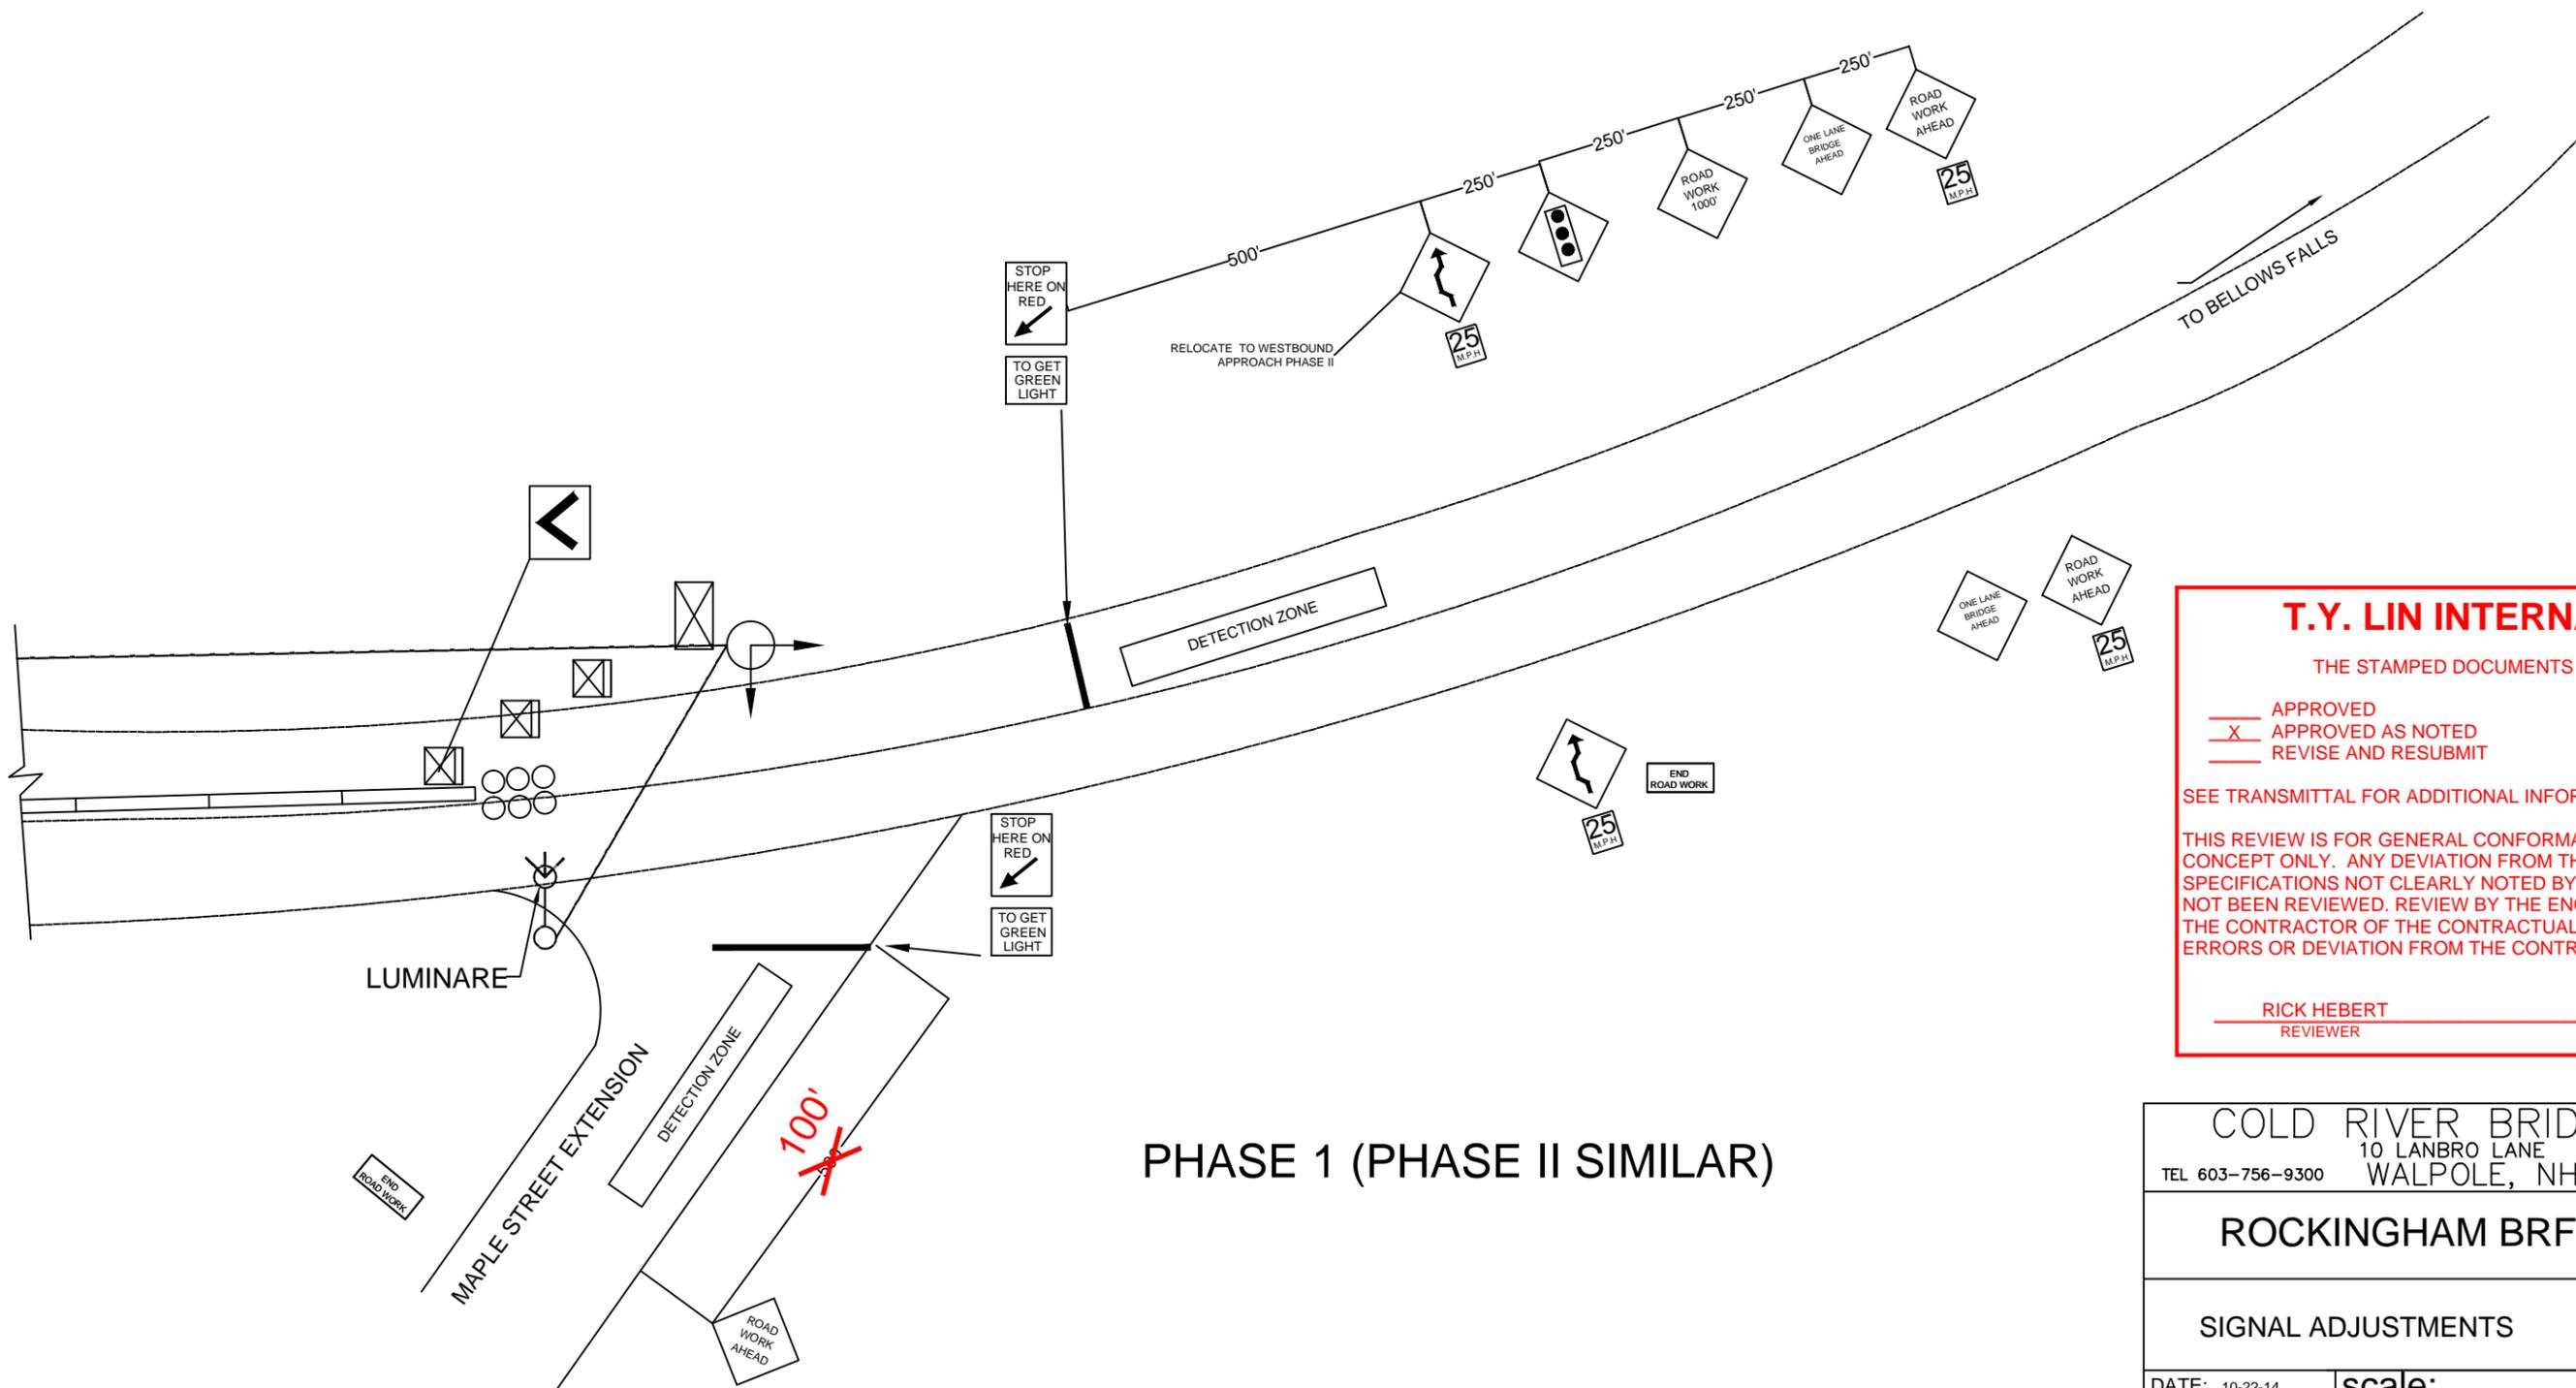

PHASE 1 (PHASE II SIMILAR)

T.Y. LIN INTERNATIONAL

THE STAMPED DOCUMENTS ARE HEREBY:

APPROVED
 APPROVED AS NOTED
 REVISE AND RESUBMIT


SEE TRANSMITTAL FOR ADDITIONAL INFORMATION AS APPLICABLE.

THIS REVIEW IS FOR GENERAL CONFORMANCE WITH DESIGN CONCEPT ONLY. ANY DEVIATION FROM THE PLANS OR SPECIFICATIONS NOT CLEARLY NOTED BY THE CONTRACTOR HAS NOT BEEN REVIEWED. REVIEW BY THE ENGINEER SHALL NOT RELIEVE THE CONTRACTOR OF THE CONTRACTUAL RESPONSIBILITY FOR ANY ERRORS OR DEVIATION FROM THE CONTRACT REQUIREMENTS.

RICK HEBERT
 REVIEWER

11/3/2014
 DATE

COLD RIVER BRIDGES, LLC 10 LANBRO LANE WALPOLE, NH	
TEL 603-756-9300 FAX 603-756-9303	
ROCKINGHAM BRF 0126 (12)	
SIGNAL ADJUSTMENTS	SHEET NUMBER
DATE: 10-22-14	S2
scale:	

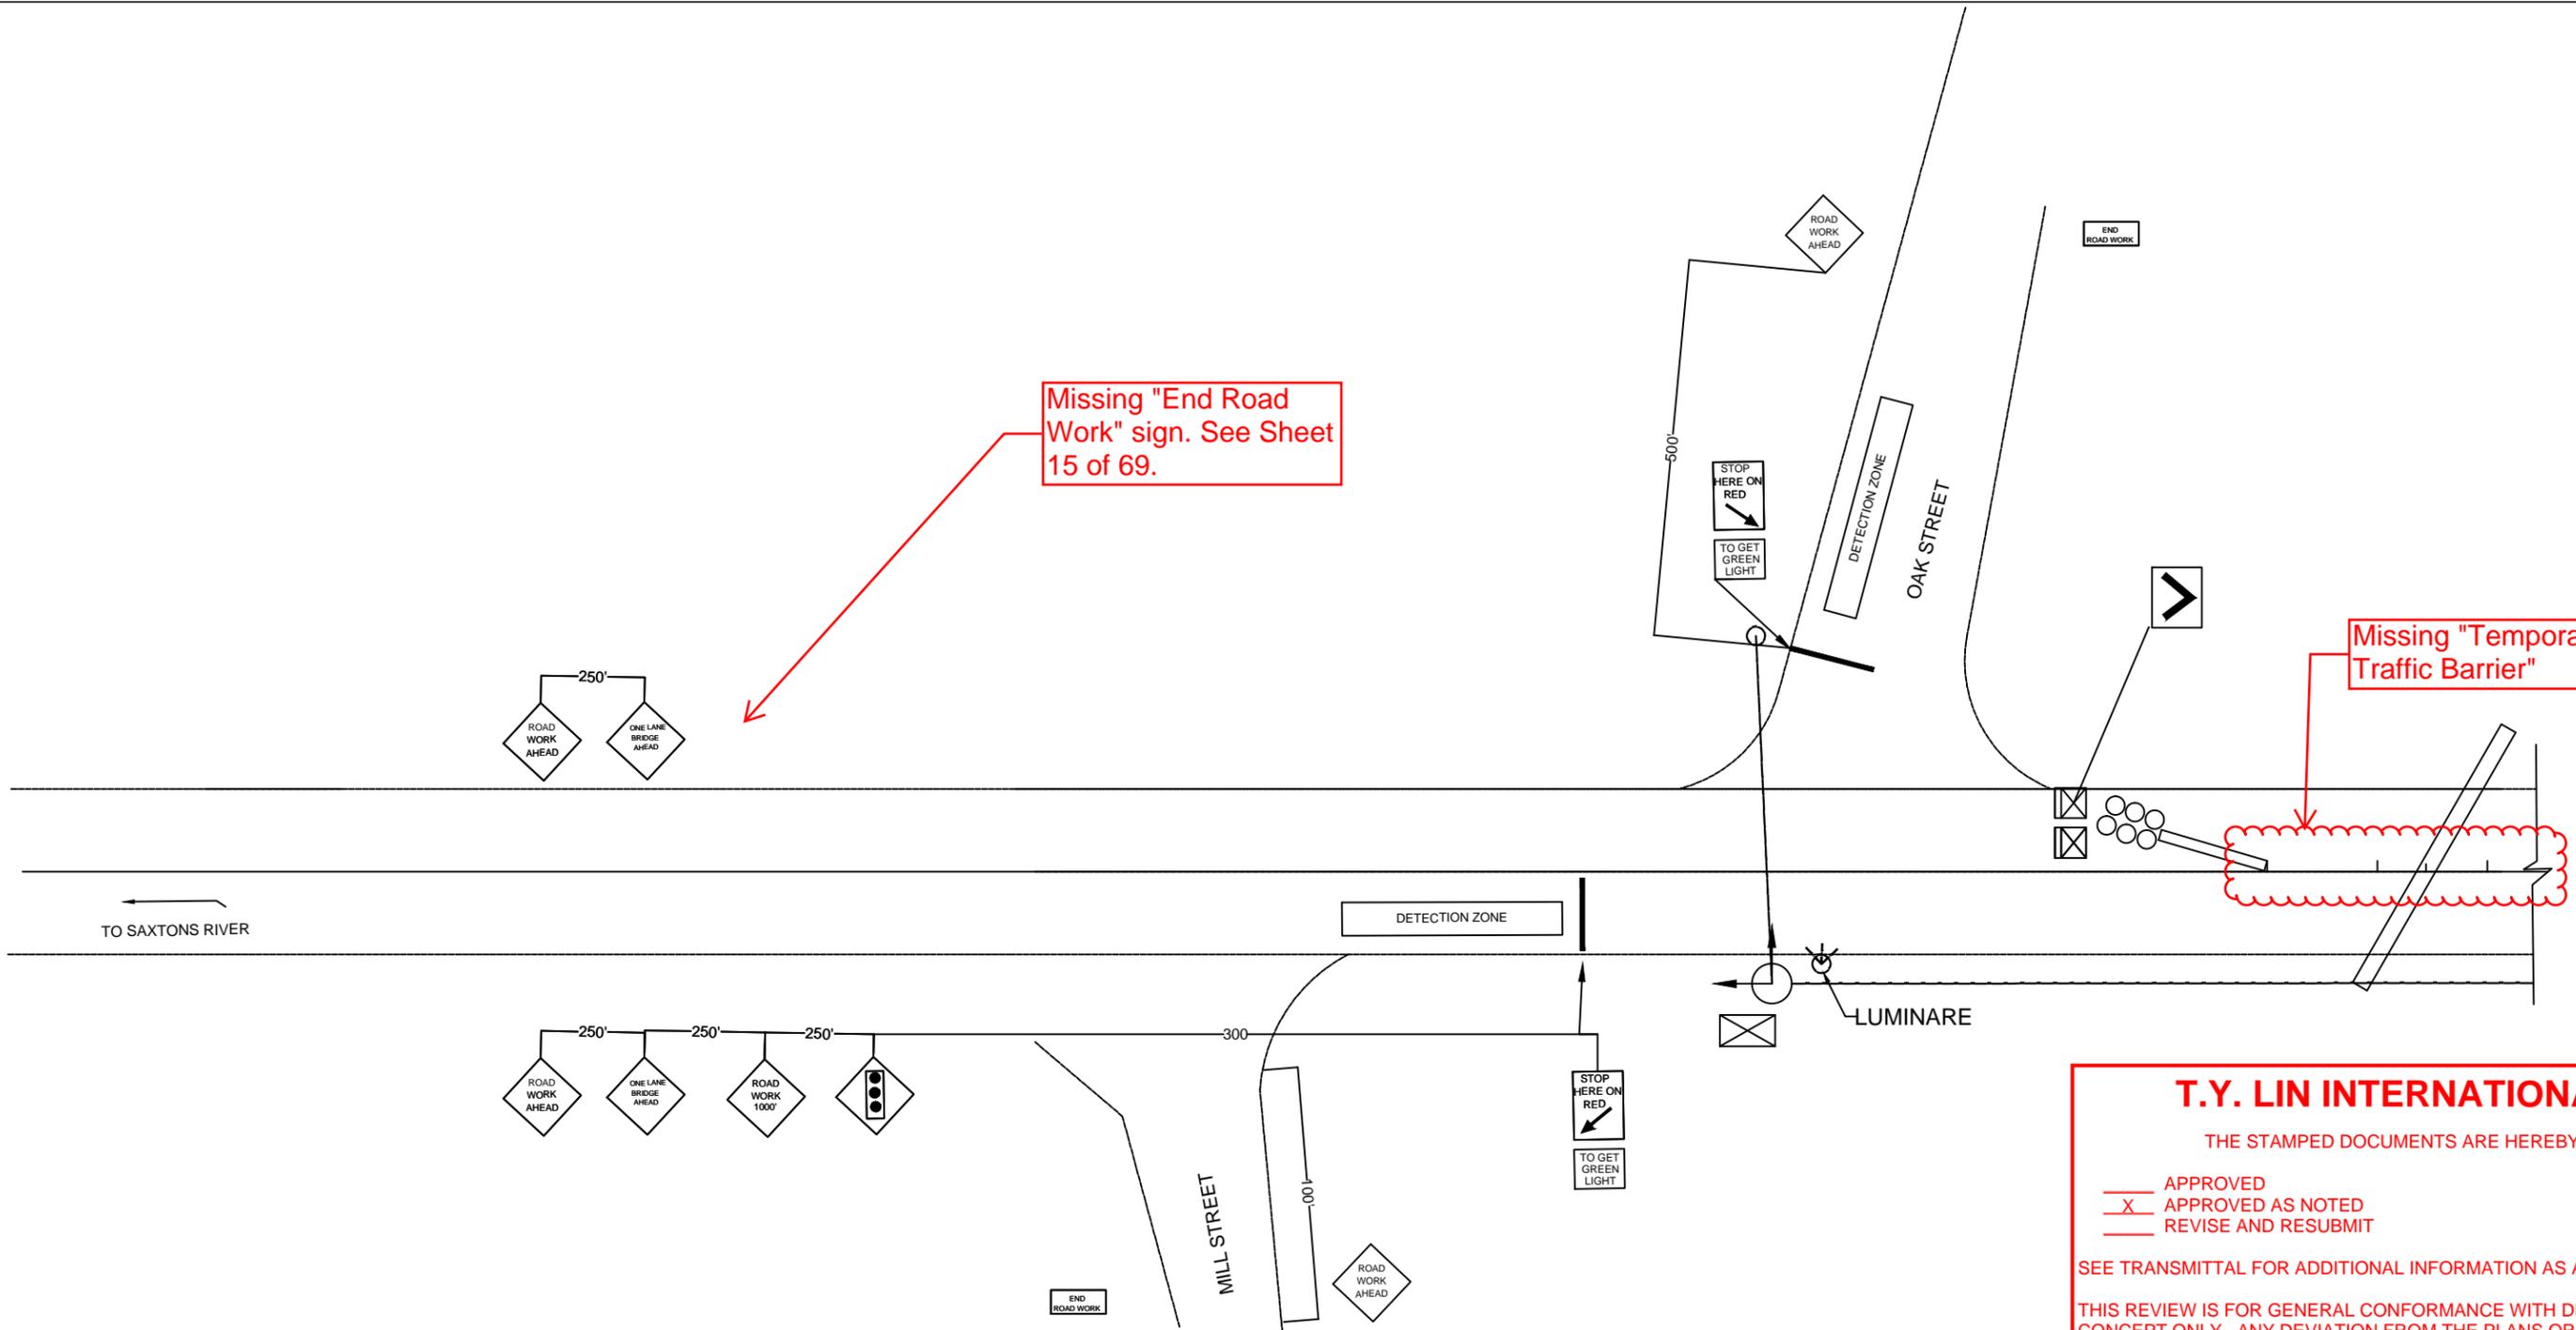

PHASE 1 (PHASE II SIMILAR)

T.Y. LIN INTERNATIONAL
 THE STAMPED DOCUMENTS ARE HEREBY:
 _____ APPROVED
 X APPROVED AS NOTED
 _____ REVISE AND RESUBMIT

SEE TRANSMITTAL FOR ADDITIONAL INFORMATION AS APPLICABLE.

THIS REVIEW IS FOR GENERAL CONFORMANCE WITH DESIGN CONCEPT ONLY. ANY DEVIATION FROM THE PLANS OR SPECIFICATIONS NOT CLEARLY NOTED BY THE CONTRACTOR HAS NOT BEEN REVIEWED. REVIEW BY THE ENGINEER SHALL NOT RELIEVE THE CONTRACTOR OF THE CONTRACTUAL RESPONSIBILITY FOR ANY ERRORS OR DEVIATION FROM THE CONTRACT REQUIREMENTS.

 RICK HEBERT REVIEWER

 11/3/2014 DATE

COLD RIVER BRIDGES, LLC
 10 LANBRO LANE
 WALPOLE, NH
 TEL 603-756-9300 FAX 603-756-9303

ROCKINGHAM BRIDGE 0126 (12)

SIGNAL ADJUSTMENTS	SHEET NUMBER
DATE: 10-22-14	S3

scale: