

SHOP DRAWING TRANSMITTAL

DATE RETURNED: 3/26/2015	DATE SENT: 3/20/2015	PAGE <u>1</u> of <u>1</u>
---------------------------------	-----------------------------	----------------------------------

TO/FROM: TEL.# 518-453-4734 CHA III WINNERS CIRCLE ALBANY, NY 12205 ATTN:	TO/FROM: TEL.# () MARK SARGENT PROJECT MANAGER - STRUCTURES 1 NATIONAL LIFE DRIVE MONTPELIER, VT 05633-5001
--	---

CHA PROJECT No.20615 CONTRACT No. BRF 3000(19) TITLE: RUTLAND CITY (RIPLEY ROAD)	
---	--

SHOP DRAWING DATA: (TO BE FILLED IN BY CONTRACTOR) TOPIC: SANITARY SEWER MANHOLE COVER SPECIFICATION: 604.56	
<i>DO NOT MIX SUBMISSIONS FROM DIFFERENT SPEC DIVISIONS ON THIS FORM. FILL OUT NEW FORM EACH TIME!</i>	FOR CHA'S RECEIVED STAMP.

THE ABOVE NAMED CONTRACTOR HAS EVALUATED EACH ITEM IDENTIFIED IN THIS TRANSMITTAL & CERTIFIES IT TO BE IN CONFORMANCE WITH THE CONTRACT DOCUMENTS.

****THIS SUBMITTAL IS NOT BEING PRESENTED AS A SUBSTITUTION****

CERTIFIED BY: JAMES RASHFORD **TITLE:** DESIGN MANAGER **DATE:** 3/26/2015

ID NUMBER	QUANTITY		DESCRIPTION OF ITEM(S) BEING SUBMITTED <small>(Reference specification section and/or drawing number for each item being submitted)</small>	ENGINEER'S REVIEW STATUS
	SENT	RETURN		
604.56-01	1	1	Sanitary Sewer Manhole Cover	NET

NET = NO EXCEPTIONS TAKEN **MCN** = MAKE CORRECTIONS NOTED **R&R** = REVISE AND RESUBMIT
REJ = REJECTED **SSI** = SUBMIT SPECIFIED ITEM **NR** = NOT REVIEWED
***RESUBMIT REQUIRED IF REVIEW STATUS IS R&R, REJ, SSI**

CONTRACTOR'S COMMENTS: 	Engineer's Comments: None
---------------------------------------	-------------------------------------

(FOR ENGINEER'S INTERNAL USE ONLY)

Forwarded To: <u>MARK SARGENT</u>	DUE BACK TO CONTRACTOR: _____
Reviewed By: <u>JAMES RASHFORD</u>	DATE SENT: <u>3/20/2015</u>
Returned to Contractor By: <u>DALE GOZALKOWSKI</u>	DATE RETURNED: <u>3/26/2015</u>

(ENTER DATE ABOVE)

Rutland City BRF 3000 (2014036)
SUBMITTAL 34

Issued 03/16/15
Respond by 03/30/15

To
Timothy Pockette, PE

Topic	604.56 Cast Iron Cover with Frame, Sewer
Status	For Approval
Spec section	604.56
Responsibility	(19) Ripley Road
Sent to approver	3/16/15
Required from approver	3/30/15

From
Volker H.D. Burkowski

Signed by  Date 3/16/15

Proceed as Indicated _____ Date _____
Owner Authorized Representative

- NO EXCEPTION TAKEN MAKE CORRECTIONS NOTED
- REJECTED REVISE AND RESUBMIT
- SUBMIT SPECIFIED ITEM

CHECKING IS ONLY FOR THE GENERAL CONFORMANCE WITH THE DESIGN CONCEPT OF THE PROJECT AND GENERAL COMPLIANCE WITH THE INFORMATION GIVEN IN THE CONTRACT DOCUMENTS. ANY ACTION SHOWN IS SUBJECT TO THE REQUIREMENTS OF THE PLANS AND SPECIFICATIONS. CONTRACTOR IS RESPONSIBLE FOR DIMENSIONS WHICH SHALL BE CONFIRMED AND CORRELATED AT THE JOB SITE; FABRICATION PROCESSES AND TECHNIQUES OF CONSTRUCTION; COORDINATION OF HIS WORK WITH THAT OF ALL OTHER TRADES AND THE SATISFACTORY PERFORMANCE OF THE WORK.




CHA

DATE 3/25/2015 BY James Rashford



- NO EXCEPTION TAKEN
- MAKE CORRECTIONS NOTED
- REJECTED
- REVISE AND RESUBMIT
- SUBMIT SPECIFIED ITEM

CHECKING IS ONLY FOR THE GENERAL CONFORMANCE WITH THE DESIGN CONCEPT OF THE PROJECT AND GENERAL COMPLIANCE WITH THE INFORMATION GIVEN IN THE CONTRACT DOCUMENTS. ANY ACTION SHOWN IS SUBJECT TO THE REQUIREMENTS OF THE PLANS AND SPECIFICATIONS. CONTRACTOR IS RESPONSIBLE FOR DIMENSIONS WHICH SHALL BE CONFIRMED AND CORRELATED AT THE JOB SITE; FABRICATION PROCESSES AND TECHNIQUES OF CONSTRUCTION; COORDINATION OF HIS WORK WITH THAT OF ALL OTHER TRADES AND THE SATISFACTORY PERFORMANCE OF THE WORK.

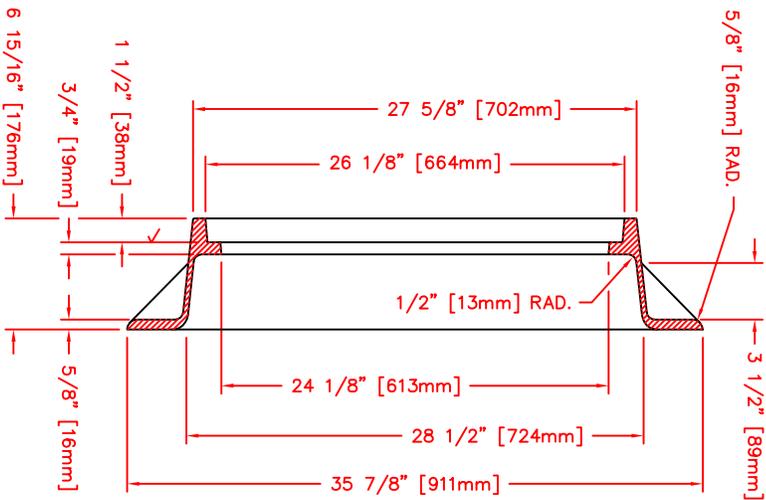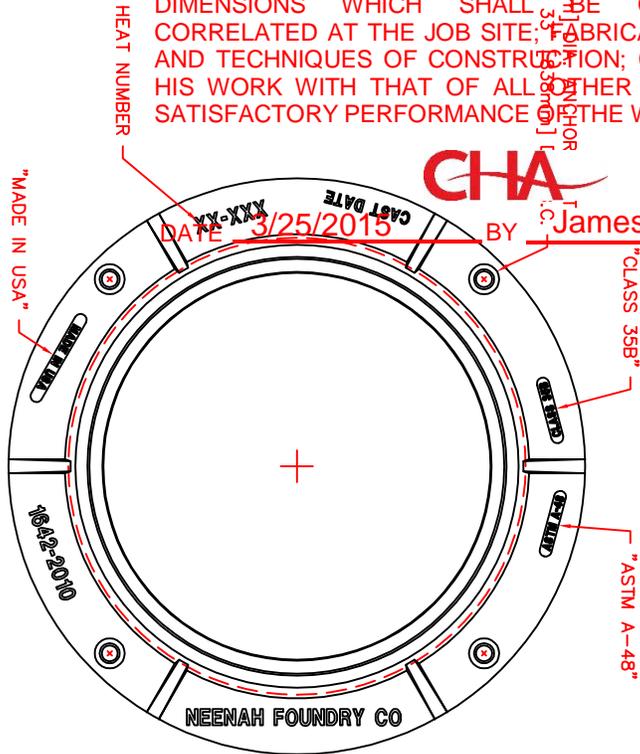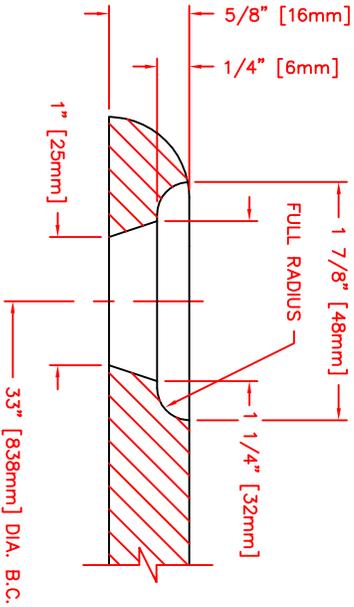

ANCHOR HOLE DETAIL

FULL SCALE

CAD DWG. REF: 16422010.DWG- 4

NO.	DATE	DESCRIPTION	BY	CHK.
1	10-14-2003	CONVERTED BULETS		
2	02-28-2005	ISSUED LETTERING ON FLANGE		
3	10-22-08	CHK. P-H. DIM. FROM 28 9/8"		
4		REVISION		

DR.	E. REMME
CH.	
APP.	
DATE	2-10-96

SCALE	1/8"=1"
TITLE	
DWG. CHK.	

NEENAH
FOUNDRY COMPANY
VERONA WISCONSIN 53093

NF-16422010 B

NOTE: ALL DIMENSIONS ARE SHOWN IN ENGLISH AND [METRIC]
SUITABLE FOR HS-25 LOADING
MATERIAL: CAST GRAY IRON ASTM A-48, CLASS 35B
FINISH: NOT PAINTED
WEIGHT: 147#
WAS COMPONENT NO. 1642-0001


R-1642
FRAME

CHA

BY: James Rashford


MADE IN USA
DATE: 3/25/2015
HEAT NUMBER

NEENAH FOUNDRY CO

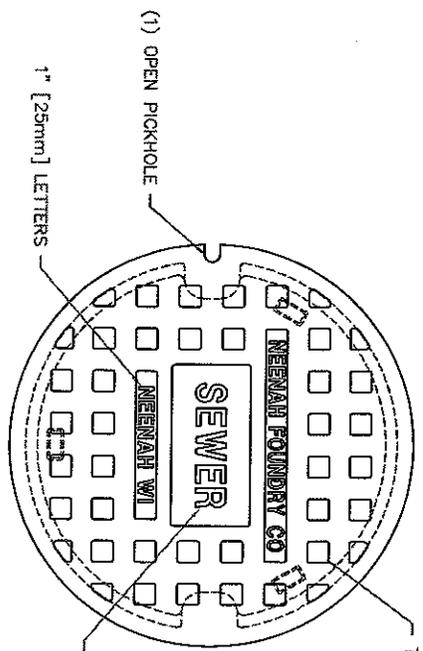

- NO EXCEPTION TAKEN
- MAKE CORRECTIONS NOTED
- REJECTED
- REVISE AND RESUBMIT
- SUBMIT SPECIFIED ITEM

CHECKING IS ONLY FOR THE GENERAL CONFORMANCE WITH THE DESIGN CONCEPT OF THE PROJECT AND GENERAL COMPLIANCE WITH THE INFORMATION GIVEN IN THE CONTRACT DOCUMENTS. ANY ACTION SHOWN IS SUBJECT TO THE REQUIREMENTS OF THE PLANS AND SPECIFICATIONS. CONTRACTOR IS RESPONSIBLE FOR DIMENSIONS WHICH SHALL BE CONFIRMED AND CORRELATED AT THE JOB SITE; FABRICATION PROCESSES AND TECHNIQUES OF CONSTRUCTION; COORDINATION OF HIS WORK WITH THAT OF ALL OTHER TRADES AND THE SATISFACTORY PERFORMANCE OF THE WORK.

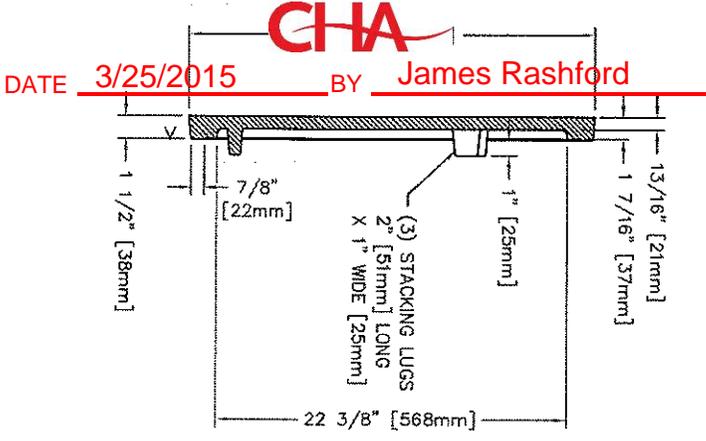

NOTE: ALL DIMENSIONS SHOWN ARE IN ENGLISH AND [METRIC]
 MATERIAL: CAST GRAY IRON ASTM A-48, CLASS 35B
 FINISH: NO PAINT
 WEIGHT: 125#

DATE	01-18-95	DR.	CSK	SCALE	1/8"=1"	TITLE	R-1642
DATE		CH.				NEENAH	TYPE "B" PLATEN LID
DATE		APP.				FOUNDRY COMPANY	
DATE		INT.				NEENAH WISCONSIN 54956	NF-16425028 B