



CONSTRUCTION LEADERS

LETTER OF TRANSMITTAL	
DATE: <b>May 1, 2015</b>	PCL JOB NO: <b>5515002</b>
ATTN: <b>Chris Barker</b>	TRANSMITTAL NO: <b>066</b>

To: **State of Vermont Agency of Transportation**  
 One National Life Drive  
 Montpelier, VT 05633-5001  
 (802) 828-0053

Re: Hartford Lateral Slide  
 Project No.: IM 091-2(79)  
 Contract ID.: 12A132

County: Windsor

PCL FILE NO: 5515002-43

WE ARE SENDING  Attached  Under separate cover via Email & SP the following:  
 Shop drawings  Prints  Plans  Samples  Specifications  
 Copy of Letter  Change Order  Other

COPIES	SPEC.	REVISION	DESCRIPTION
1	Sheet 5, Note 73		US-5 As-Built Drawings

TRANSMITTED for as checked below:

For approval  Approved as submitted  Resubmit  1 Copies for approval  
 For your use  Approved as noted  Submit  Copies for distribution  
 As requested  Returned for corrections  Return  Corrected prints  
 For review and comment

**Remarks:**

Please return an email of this approved submittal to Erich Heymann ([ewheymann@pcl.com](mailto:ewheymann@pcl.com)) and Jeremy Mackling ([jmackling@pcl.com](mailto:jmackling@pcl.com)).

We request the review and return of this submittal within 2 days. Please advise if this request cannot be met so we can plan accordingly.

---

By: **Erich Heymann**, Project Engineer

COPY TO: Project Files



**CONSTRUCTION LEADERS**

**SUBMITTAL NO. : 43  
US-5 As-Built Drawings**

<b>Item No.</b>	<b>Specification</b>	<b>Description</b>
1	Sheet 5, Note 73	US-5 As-Built Drawings


***PROJECT:***  
**HARTFORD LATERAL SLIDE**  
**PROJECT NO.: IM 091-2(79)**  
**CONTRACT ID.: 12A132**

***OWNER:***  
**STATE OF VERMONT AGENCY OF TRANSPORTATION**

***ENGINEER OF RECORD:***  
**STATE OF VERMONT AGENCY OF TRANSPORTATION**

***CONTRACTOR:***  
**PCL CIVIL CONSTRUCTORS, INC.**

**MAY 1, 2015**

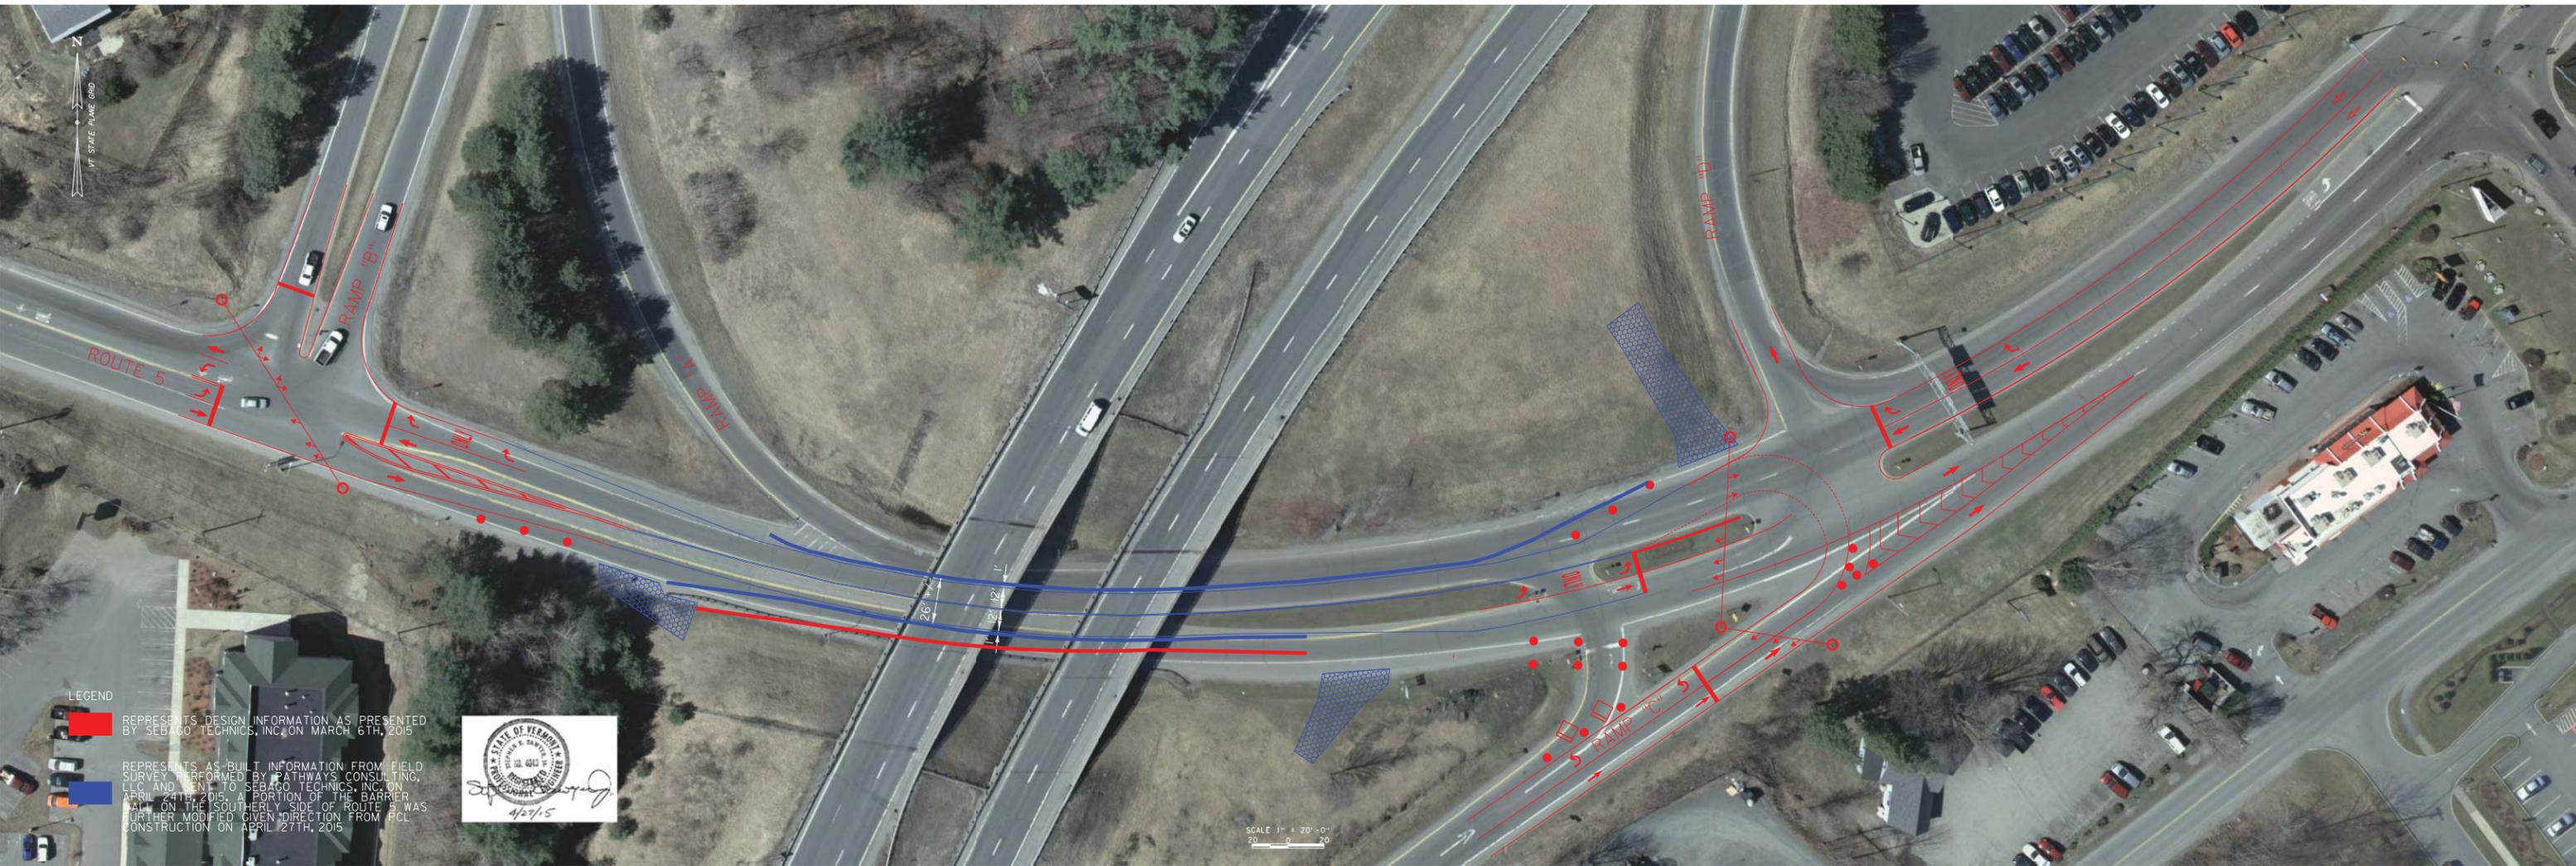

VT STATE PLANE GRID

LEGEND

REPRESENTS DESIGN INFORMATION AS PRESENTED BY SEBAGO TECHNICS, INC. ON MARCH 6TH, 2015

REPRESENTS AS-BUILT INFORMATION FROM FIELD SURVEY PERFORMED BY PATHWAYS CONSULTING, LLC AND SENT TO SEBAGO TECHNICS, INC. ON APRIL 24TH, 2015. A PORTION OF THE BARRIER WALL ON THE SOUTHERLY SIDE OF ROUTE 5 WAS FURTHER MODIFIED GIVEN DIRECTION FROM PCL CONSTRUCTION ON APRIL 27TH, 2015.



SCALE 1" = 20'-0"  
20 0 20