

RECEIVED

ON: **May 1, 2015**


and Checked for

CONFORMANCE


BY: Jennifer Fitch DATE: 06/08/2015

#5 FOR APPROACH SLAB (TYP)

19'-6" TO ALLOW FOR 3" CLEAR (TYP)

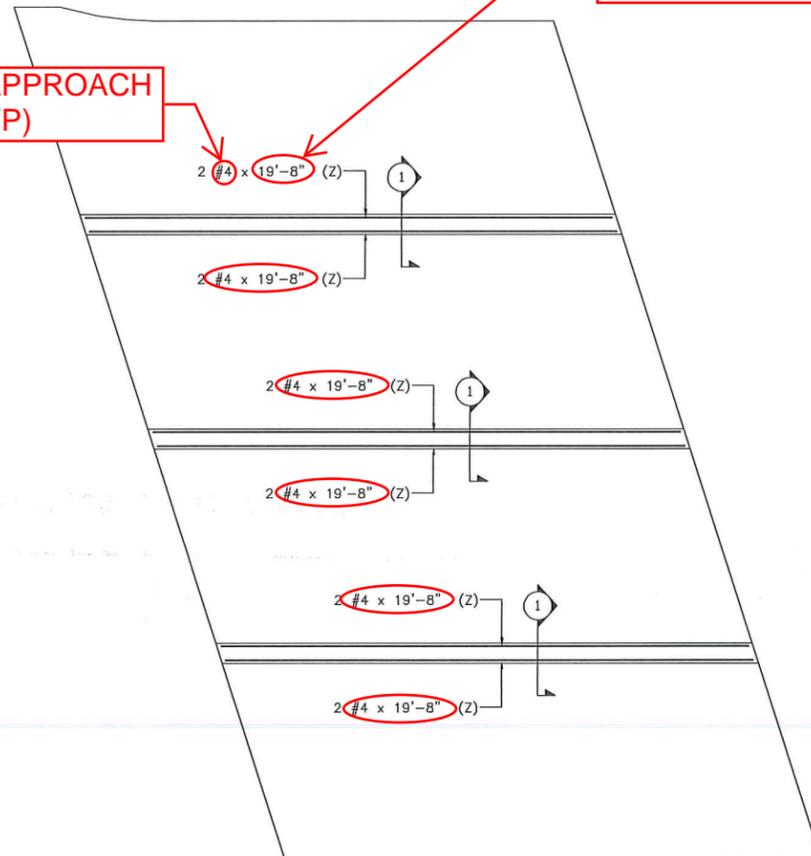


APPROACH SLAB #1 CLOSURE POURS PLAN

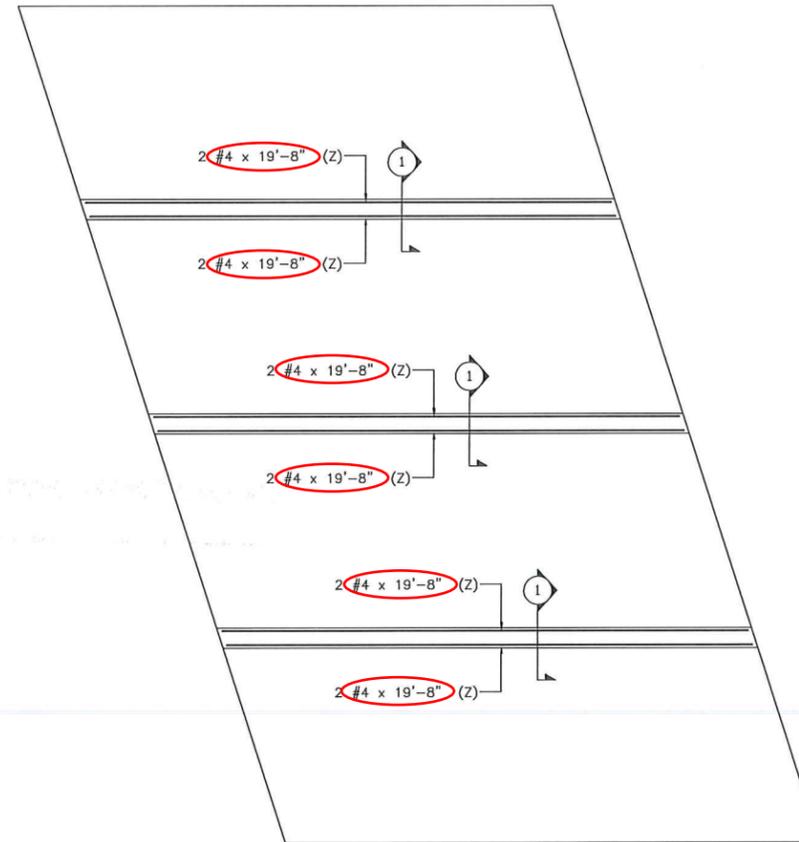

APPROACH SLAB #2 CLOSURE POURS PLAN

#5 FOR APPROACH SLAB (TYP)

2 #4 DUAL COATED

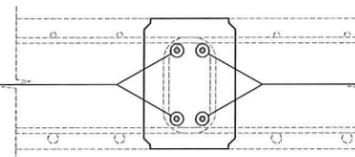

2 #4 DUAL COATED

(3 THUS)
 SECT. 1

ALL DUAL COATED REINF. DENOTED (Z)

ELEVATIONS & DIMENSIONS SHOWN ON THIS DWG. ARE FOR REINF. DETAILING PURPOSES ONLY AND ARE NOT INTENDED FOR CONSTRUCTION.

REINF. BARS ASTM A615 GRADE 60 DUAL COATED

VERIFICATION OF UNCLEAR INFORMATION MAY BE REQUESTED ON THIS DRAWING. SHOULD VERIFICATION BE LEFT UN-ADDRESSED IT WILL REMAIN AS SHOWN AND ASSUME TO BE CORRECT.

FOR APPROVAL

SHOP DRAWING REVIEW

- REVIEWED AS REQUIRED BY THE CONSTRUCTION CONTRACT DOCUMENTS AND APPROVED, BUT ONLY FOR CONFORMANCE TO THE DESIGN CONCEPT OF THE WORK, AND SUBJECT TO FURTHER LIMITATIONS AND REQUIREMENTS CONTAINED IN THE CONSTRUCTION CONTRACT DOCUMENTS.
- REJECTED REVISE AND RESUBMIT FURNISH AS CORRECTED

CORRECTIONS OR COMMENTS MADE ON THE SHOP DRAWINGS DURING THIS REVIEW DO NOT RELIEVE CONTRACTOR FROM COMPLIANCE WITH REQUIREMENTS OF THE DRAWINGS AND SPECIFICATIONS. THIS CHECK IS ONLY FOR REVIEW OF GENERAL CONFORMANCE WITH THE DESIGN CONCEPT OF THE PROJECT AND GENERAL COMPLIANCE WITH THE INFORMATION GIVEN IN THE CONTRACT DOCUMENTS. THE CONTRACTOR IS RESPONSIBLE FOR: CONFIRMING AND CORRELATING ALL QUANTITIES AND DIMENSIONS; SELECTING FABRICATION PROCESSES AND TECHNIQUES OF CONSTRUCTION; COORDINATING HIS WORK WITH THAT OF ALL OTHER TRADES; AND PERFORMING HIS WORK IN A SAFE AND SATISFACTORY MANNER.

vhb
 40 IDX Drive
 Building 100, Suite 200
 South Burlington, VT 05403
 802.497.6100

Job Number: 57632.00
 Reviewed By: E.F. LAWES
 Date: June 8, 2015

6			
5			
4			
3			
2			
1	4/29/15		FOR APPROVAL
	DATE	REV.#	SENT FOR
	DIMENSION		
	DIMENSION FABRICATORS INC.		
	2000 37th STREET SCOTIA, N.Y. 12302 Ph: (518) 374-1838 Fax: (518) 374-4833 www.dimensionfabricators.com		
STRUCTURE	CASTLETON BRP 015-2(10) CLOSURE POURS REINFORCING		
LOCATION	CASTLETON, VT		
ARCHITECT			
ENGINEER			
CUSTOMER	W.M. SCHULTZ CONSTRUCTION INC.		
DRAWN BY	DATE	DATE	DR #
Ed Eras	4/29/15		9248
DRAWING COVERS			DRAWING #
APPROACH SLABS CLOSURE POURS DUAL COATED REINFORCING			B


RECEIVED

ON: **May 1, 2015**

and Checked for

CONFORMANCE

BY: Jennifer Fitch DATE: 06/08/2015

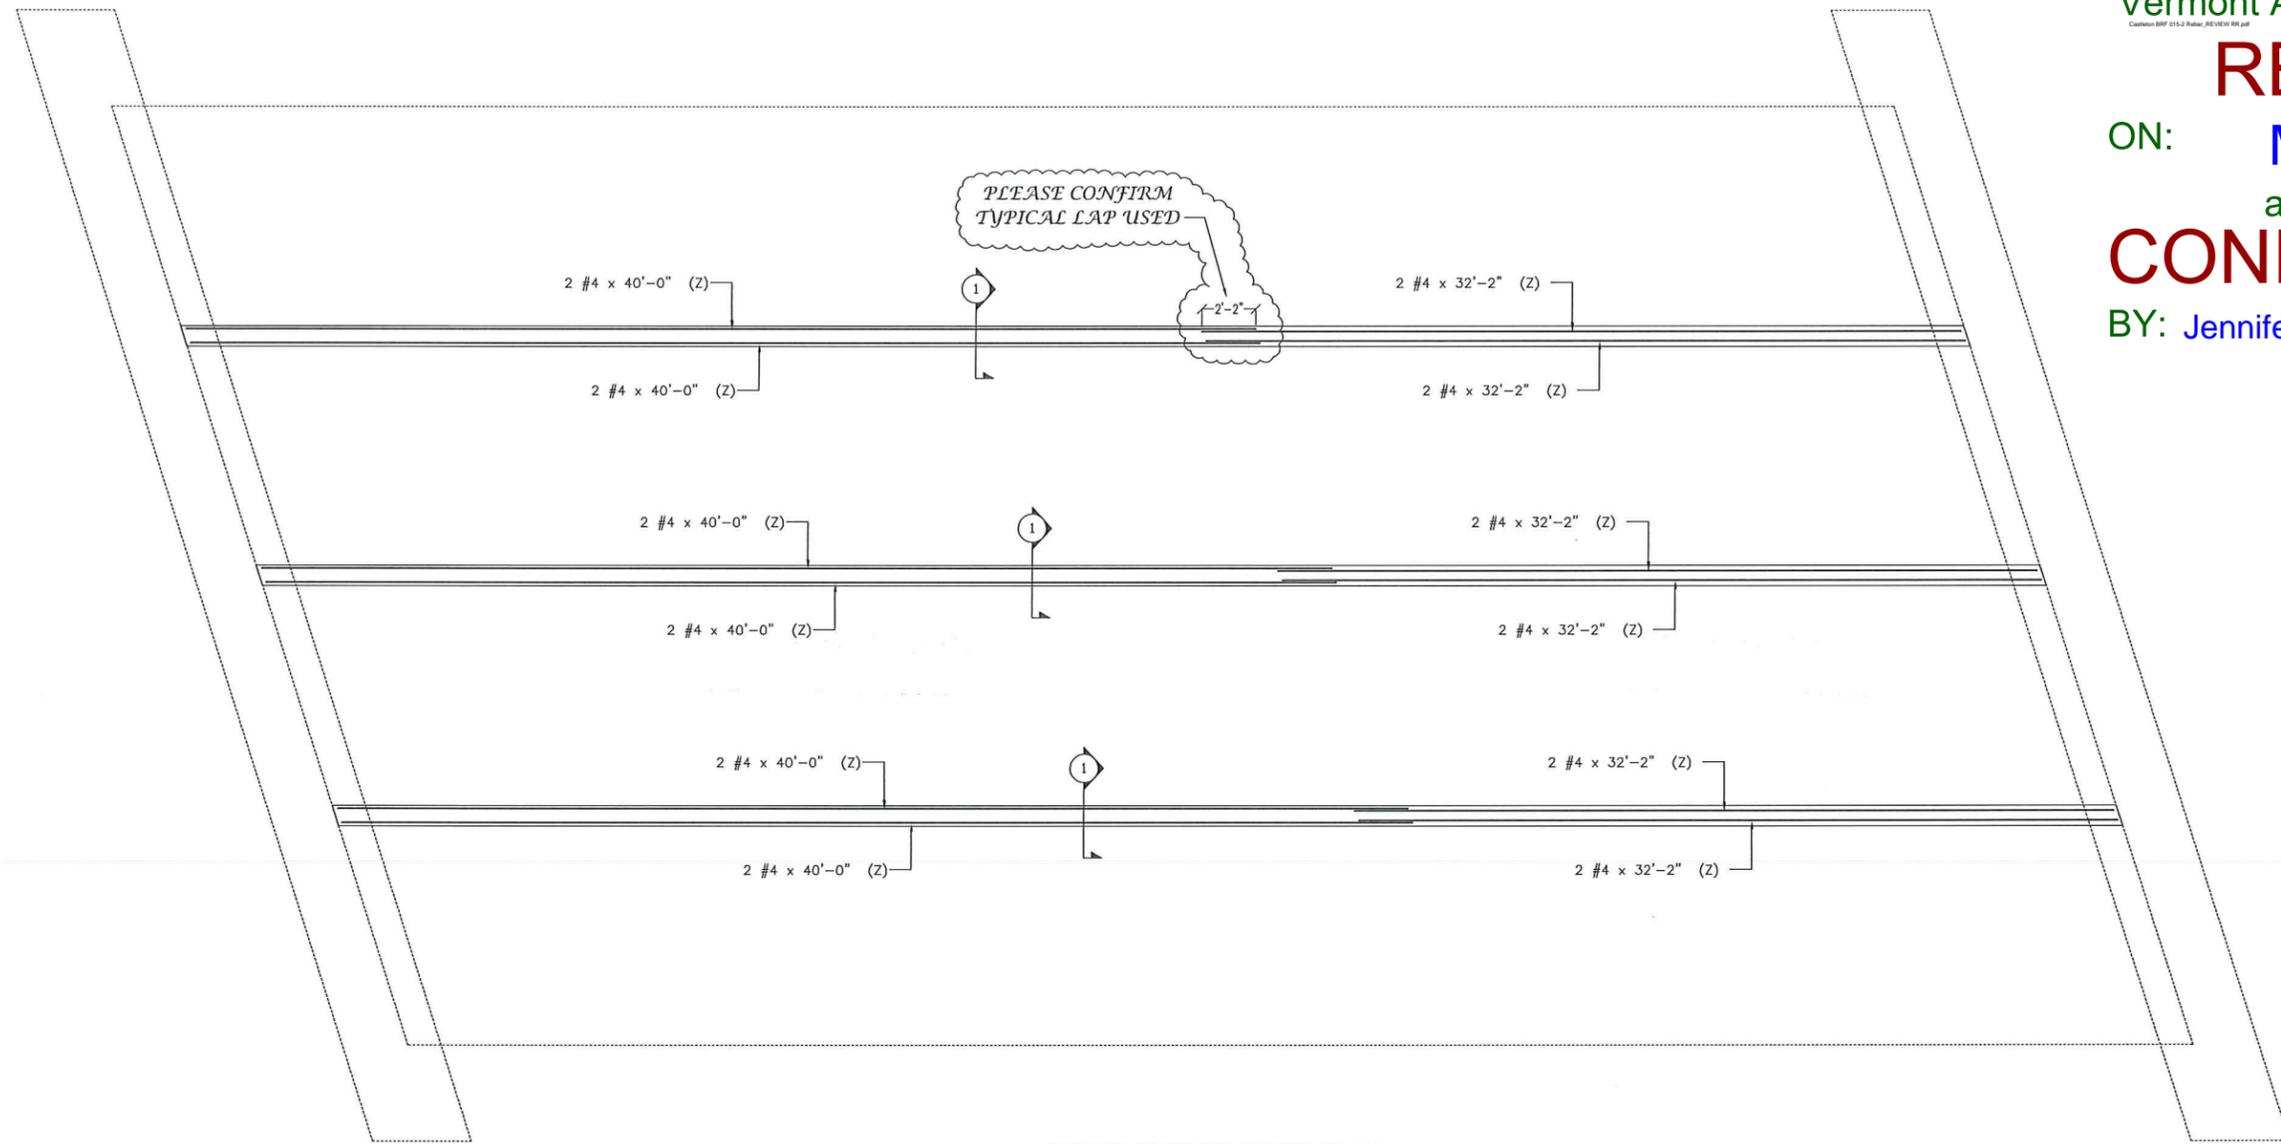

BRIDGE CLOSURE POURS PLAN

ALL DUAL COATED REINF. DENOTED (Z)


ELEVATIONS & DIMENSIONS SHOWN ON THIS DWG. ARE FOR REINF. DETAILING PURPOSES ONLY AND ARE NOT INTENDED FOR CONSTRUCTION.

REINF. BARS ASTM A615 GRADE 60 DUAL COATED

VERIFICATION OF UNCLEAR INFORMATION MAY BE REQUESTED ON THIS DRAWING. SHOULD VERIFICATION BE LEFT UN-ADDRESSED IT WILL REMAIN AS SHOWN AND ASSUME TO BE CORRECT.

FOR APPROVAL

DETAIL DOES NOT MATCH CLOSURE POUR JOINT SHAPE AS SHOWN IN THE SHOP DRAWINGS.

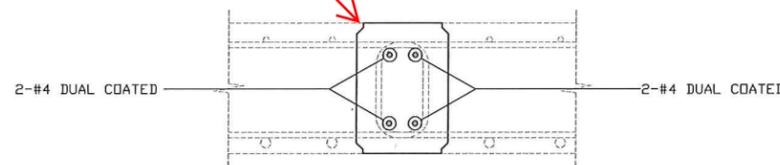

(3 THUS)

SECT. 1

SHOP DRAWING REVIEW



- REVIEWED AS REQUIRED BY THE CONSTRUCTION CONTRACT DOCUMENTS AND APPROVED, BUT ONLY FOR CONFORMANCE TO THE DESIGN CONCEPT OF THE WORK, AND SUBJECT TO FURTHER LIMITATIONS AND REQUIREMENTS CONTAINED IN THE CONSTRUCTION CONTRACT DOCUMENTS.
- REJECTED REVISE AND RESUBMIT FURNISH AS CORRECTED

CORRECTIONS OR COMMENTS MADE ON THE SHOP DRAWINGS DURING THIS REVIEW DO NOT RELIEVE CONTRACTOR FROM COMPLIANCE WITH REQUIREMENTS OF THE DRAWINGS AND SPECIFICATIONS. THIS CHECK IS ONLY FOR REVIEW OF GENERAL CONFORMANCE WITH THE DESIGN CONCEPT OF THE PROJECT AND GENERAL COMPLIANCE WITH THE INFORMATION GIVEN IN THE CONTRACT DOCUMENTS. THE CONTRACTOR IS RESPONSIBLE FOR: CONFIRMING AND CORRELATING ALL QUANTITIES AND DIMENSIONS; SELECTING FABRICATION PROCESSES AND TECHNIQUES OF CONSTRUCTION; COORDINATING HIS WORK WITH THAT OF ALL OTHER TRADES; AND PERFORMING HIS WORK IN A SAFE AND SATISFACTORY MANNER.

vhb
 40 IDX Drive
 Building 100, Suite 200
 South Burlington, VT 05403
 802.497.6100


Job Number: 57632.00
 Reviewed By: E.F. LAWES
 Date: June 8, 2015

6			
5			
4			
3			
2			
1	4/29/15		FOR APPROVAL
	DATE	REV.#	SENT FOR
	2000 7TH STREET SCOTIA, N.Y. 13302 Ph: (518) 374-1836 Fax: (518) 374-4833 www.dimensionfabricators.com		
STRUCTURE	CASTLETON BRF 015-2(10) CLOSURE POURS REINFORCING		
LOCATION	CASTLETON, VT		
ARCHITECT			
ENGINEER			
CUSTOMER	W.M. SCHULTZ CONSTRUCTION INC.		
DRAWN BY	DATE	OFF #	
Ed Eras	4/29/15	9248	
DRAWING CODES	BRIDGE CLOSURE POURS DUAL COATED REINFORCING		DRAWING # A

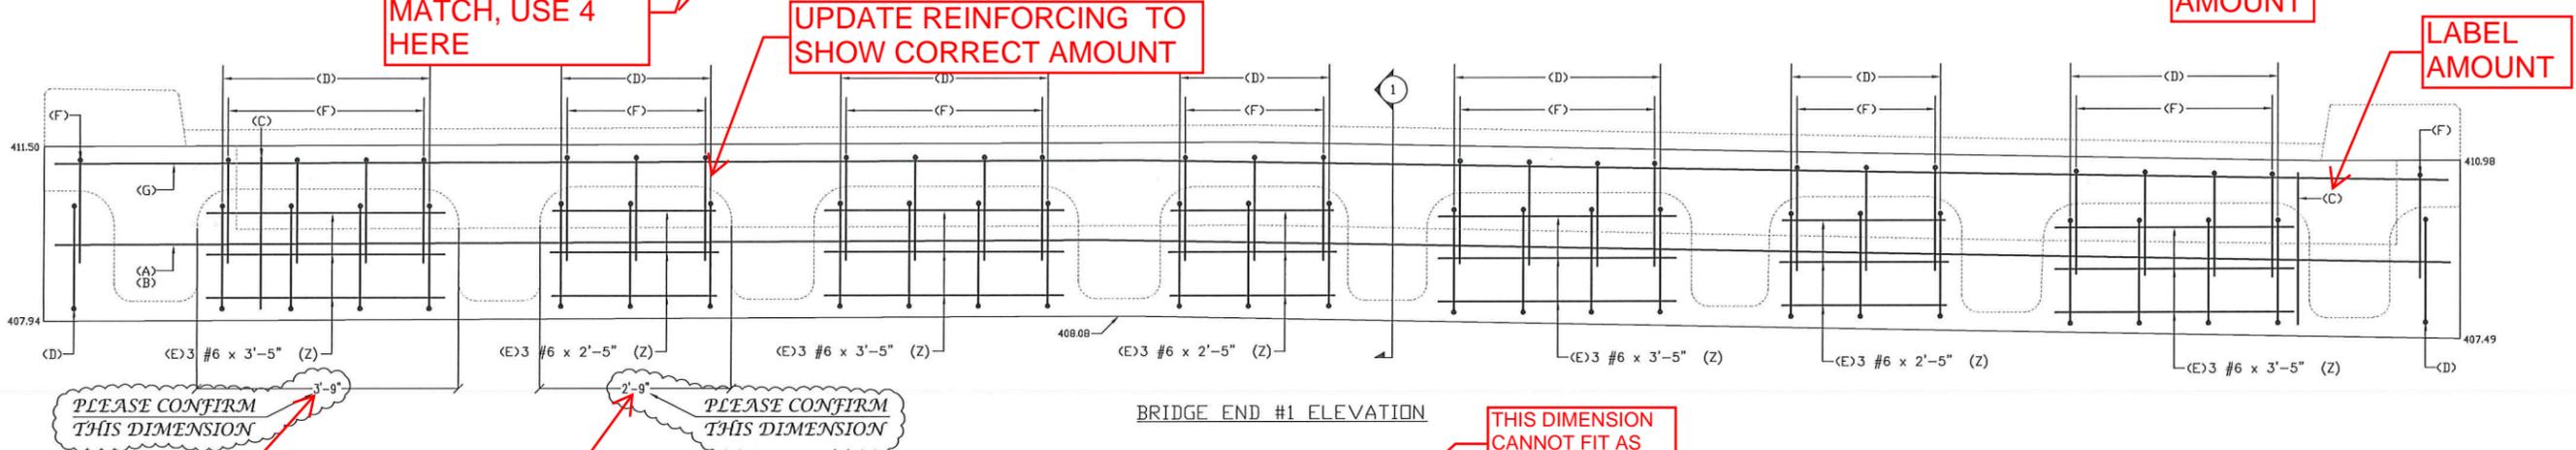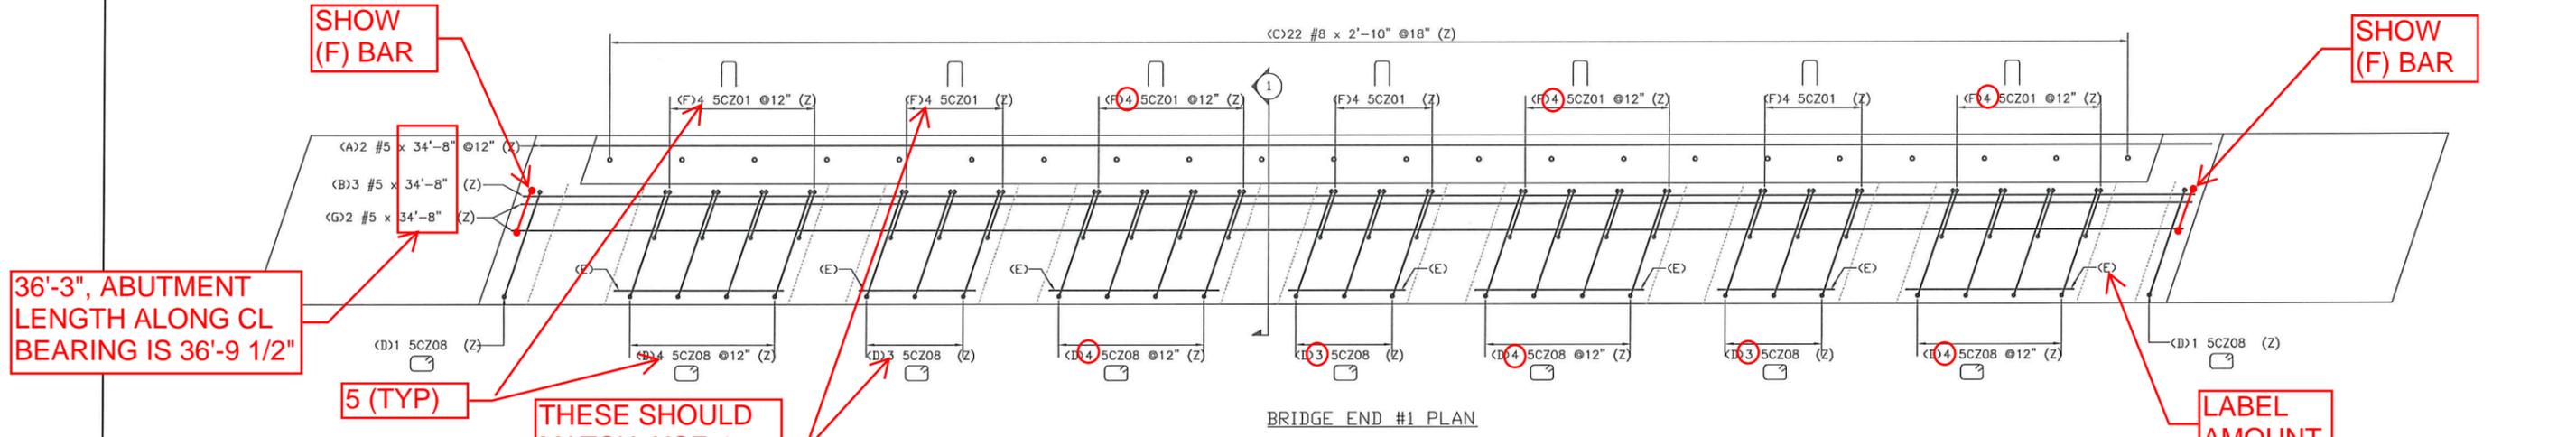

Release Number: 003

Bar Mark	Qty	Size	Total Length	Type	'A'	'B'	'C'	'D'	'E'	'F'	'G'	'H'	'J'	'K'	'O'	'R'
5CZ01	28	#5	6'-2"	17		2'-7"	1'-0"	2'-7"								
5CZ08	27	#5	8'-11"	T1	0'-5 1/2"	1'-8"	2'-4"	1'-8"	2'-4"	0'-5 1/2"						

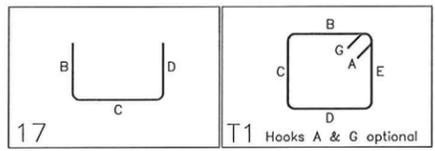


ALL DUAL COATED REINF. DENOTED (Z)

ELEVATIONS & DIMENSIONS SHOWN ON THIS DWG. ARE FOR REIN. DETAILING PURPOSES ONLY AND ARE NOT INTENDED FOR CONSTRUCTION.

REINF. BARS ASTM A615 GRADE 60 DUAL COATED

VERIFICATION OF UNCLEAR INFORMATION MAY BE REQUESTED ON THIS DRAWING. SHOULD VERIFICATION BE LEFT UN-ADDRESSED IT WILL REMAIN AS SHOWN AND ASSUME TO BE CORRECT.

FOR APPROVAL

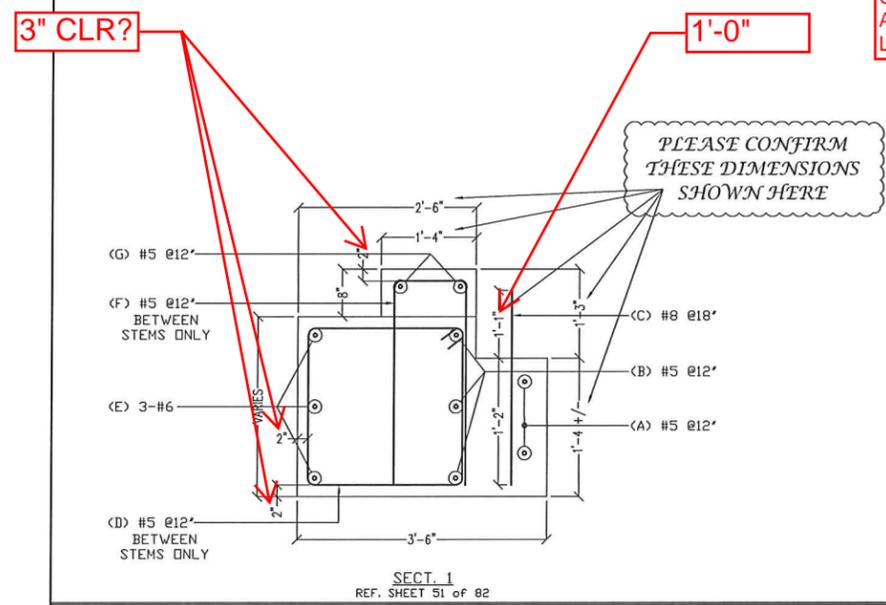

Vermont Agency of Transportation
RECEIVED
 ON: **May 1, 2015**
 and Checked for
CONFORMANCE
 BY: Jennifer Fitch DATE: 06/08/2015

SHOP DRAWING REVIEW

REVIEWED AS REQUIRED BY THE CONSTRUCTION CONTRACT DOCUMENTS AND APPROVED, BUT ONLY FOR CONFORMANCE TO THE DESIGN CONCEPT OF THE WORK, AND SUBJECT TO FURTHER LIMITATIONS AND REQUIREMENTS CONTAINED IN THE CONSTRUCTION CONTRACT DOCUMENTS.


REJECTED REVISE AND RESUBMIT FURNISH AS CORRECTED

CORRECTIONS OR COMMENTS MADE ON THE SHOP DRAWINGS DURING THIS REVIEW DO NOT RELIEVE CONTRACTOR FROM COMPLIANCE WITH REQUIREMENTS OF THE DRAWINGS AND SPECIFICATIONS. THIS CHECK IS ONLY FOR REVIEW OF GENERAL CONFORMANCE WITH THE DESIGN CONCEPT OF THE PROJECT AND GENERAL COMPLIANCE WITH THE INFORMATION GIVEN IN THE CONTRACT DOCUMENTS. THE CONTRACTOR IS RESPONSIBLE FOR: CONFIRMING AND CORRELATING ALL QUANTITIES AND DIMENSIONS; SELECTING FABRICATION PROCESSES AND TECHNIQUES OF CONSTRUCTION; COORDINATING HIS WORK WITH THAT OF ALL OTHER TRADES; AND PERFORMING HIS WORK IN A SAFE AND SATISFACTORY MANNER.


40 IDX Drive
 Building 100, Suite 200
 South Burlington, VT 05403
 802.497.6100

Job Number: **57632.00**
 Reviewed By: **E.F. LAWES**
 Date: **June 8, 2015**

6			
5			
4			
3			
2			
1	4/29/15	REV.#	FOR APPROVAL SENT FOR
STRUCTURE	CASTLETON BR# 015-2(10) CLOSURE POURS REINFORCING		
LOCATION	CASTLETON, VT		
ARCHITECT			
ENGINEER			
CUSTOMER	W.M. SCHULTZ CONSTRUCTION INC.		
DRAWN BY	Ed Eras	DATE	4/29/15
		DATE	9248
DRAWING COVERS	BRIDGE END #1	DRAWING #	C
	DUAL COATED REINFORCING		

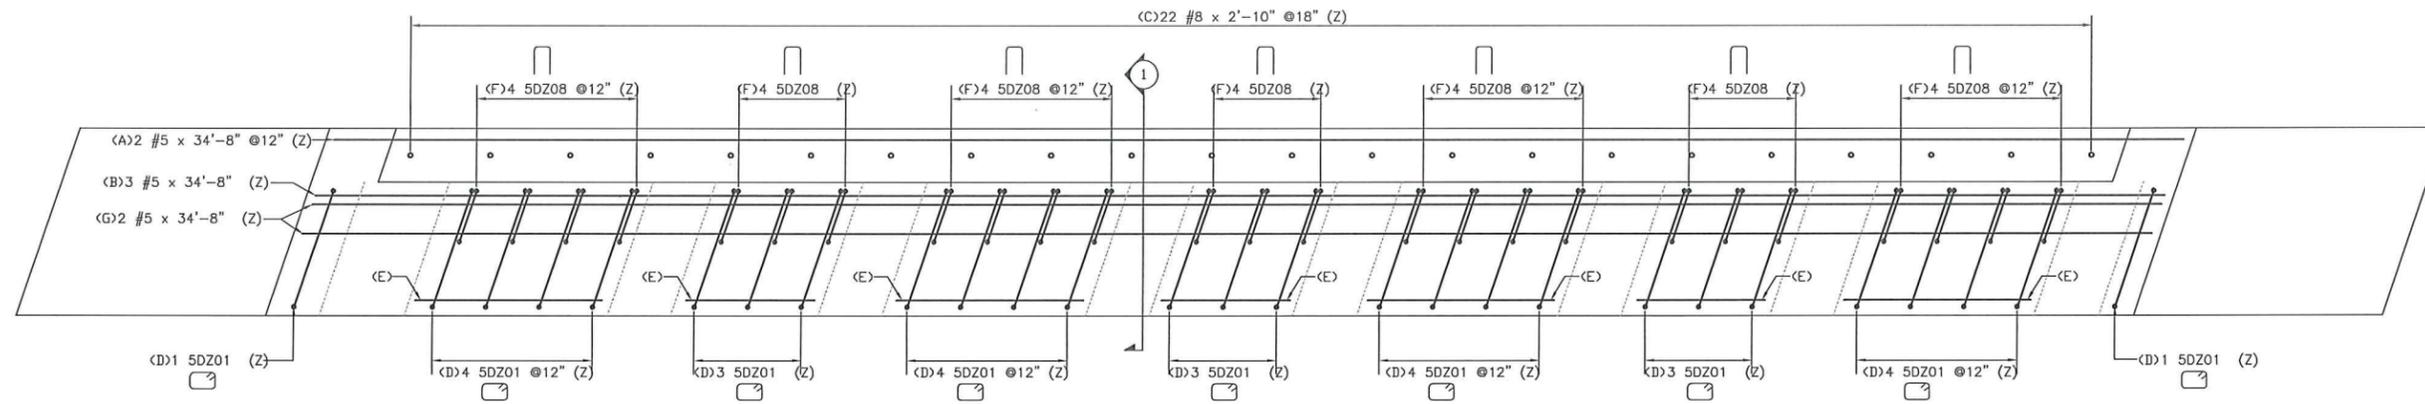

BRIDGE END #2 PLAN

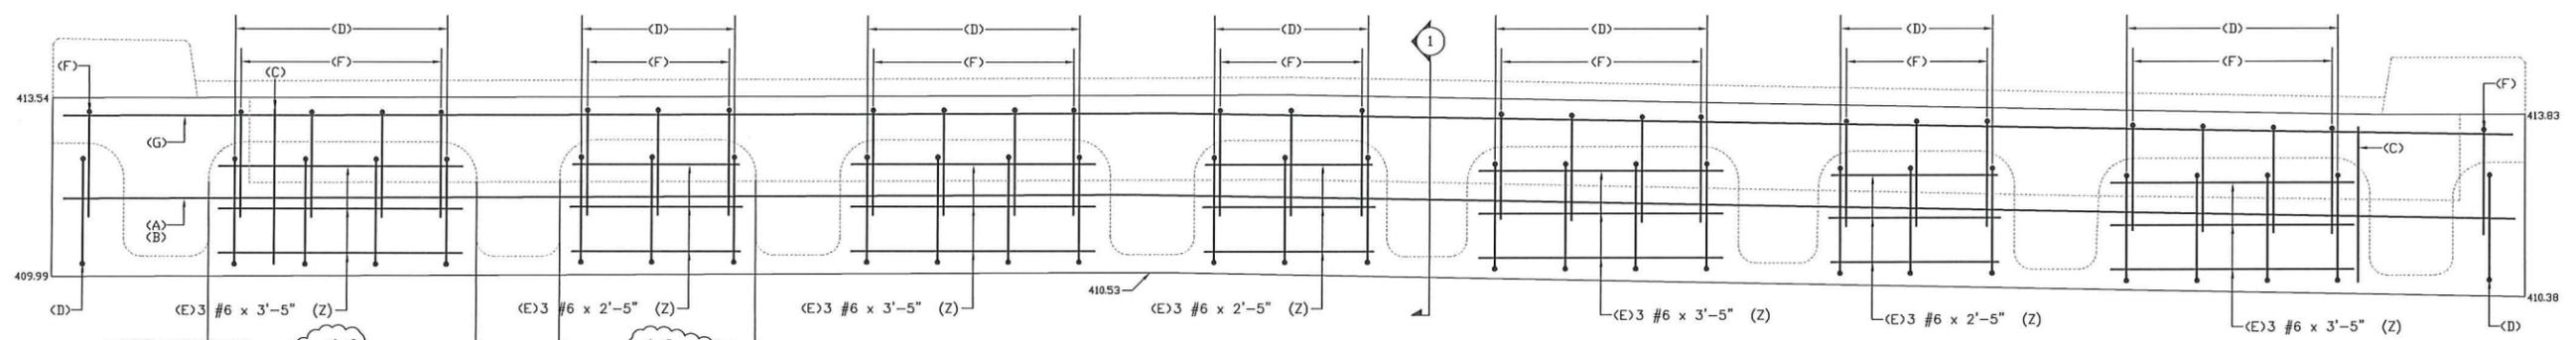

BRIDGE END #2 ELEVATION

PLEASE CONFIRM THIS DIMENSION

PLEASE CONFIRM THIS DIMENSION

Release Number: 004

Bar Mark	Qty	Size	Total Length	Type	'a'	'b'	'c'	'd'	'e'	'f'	'g'	'h'	'j'	'k'	'o'	'r'
5DZ01	27	#5	8'-11"	T1	0'-5 1/2"	1'-8"	2'-4"	1'-8"	2'-4"		0'-5 1/2"					
5DZ08	28	#5	6'-2"	17		2'-7"	1'-0"	2'-7"								


ALL DUAL COATED REINF. DENOTED (Z)

ELEVATIONS & DIMENSIONS SHOWN ON THIS DWG. ARE FOR REINF. DETAILING PURPOSES ONLY AND ARE NOT INTENDED FOR CONSTRUCTION.


REINF. BARS ASTM A615 GRADE 60 DUAL COATED

VERIFICATION OF UNCLEAR INFORMATION MAY BE REQUESTED ON THIS DRAWING. SHOULD VERIFICATION BE LEFT UN-ADDRESSED IT WILL REMAIN AS SHOWN AND ASSUME TO BE CORRECT.

SEE COMMENTS ON PREVIOUS SHEET AND REVISE.

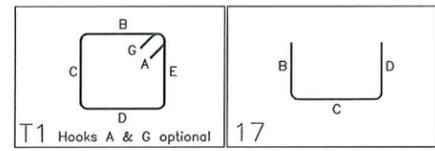

FOR APPROVAL

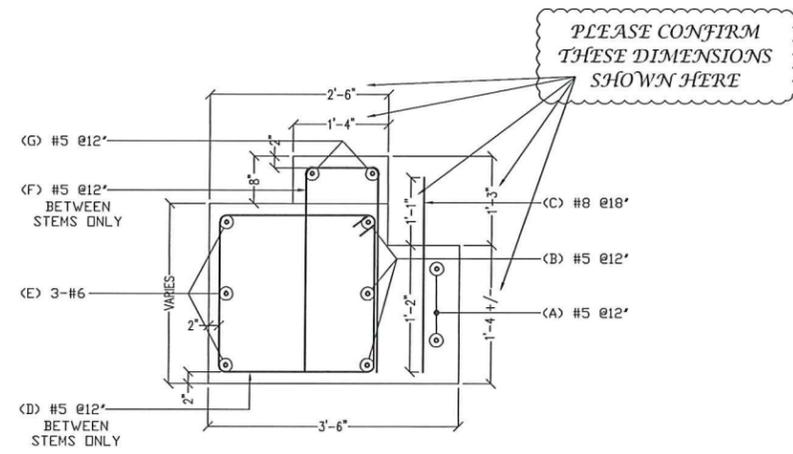

PLEASE CONFIRM THESE DIMENSIONS SHOWN HERE

Vermont Agency of Transportation
RECEIVED
 ON: **May 1, 2015**
 and Checked for
CONFORMANCE
 BY: Jennifer Fitch DATE: 06/08/2015

SHOP DRAWING REVIEW

REVIEWED AS REQUIRED BY THE CONSTRUCTION CONTRACT DOCUMENTS AND APPROVED, BUT ONLY FOR CONFORMANCE TO THE DESIGN CONCEPT OF THE WORK, AND SUBJECT TO FURTHER LIMITATIONS AND REQUIREMENTS CONTAINED IN THE CONSTRUCTION CONTRACT DOCUMENTS.

REJECTED REVISE AND RESUBMIT FURNISH AS CORRECTED

CORRECTIONS OR COMMENTS MADE ON THE SHOP DRAWINGS DURING THIS REVIEW DO NOT RELIEVE CONTRACTOR FROM COMPLIANCE WITH REQUIREMENTS OF THE DRAWINGS AND SPECIFICATIONS. THIS CHECK IS ONLY FOR REVIEW OF GENERAL CONFORMANCE WITH THE DESIGN CONCEPT OF THE PROJECT AND GENERAL COMPLIANCE WITH THE INFORMATION GIVEN IN THE CONTRACT DOCUMENTS. THE CONTRACTOR IS RESPONSIBLE FOR: CONFIRMING AND CORRELATING ALL QUANTITIES AND DIMENSIONS; SELECTING FABRICATION PROCESSES AND TECHNIQUES OF CONSTRUCTION; COORDINATING HIS WORK WITH THAT OF ALL OTHER TRADES; AND PERFORMING HIS WORK IN A SAFE AND SATISFACTORY MANNER.

vhb 40 IDX Drive Building 100, Suite 200 South Burlington, VT 05403 802.497.6100

Job Number: 57632.00
 Reviewed By: E.F. LAWES
 Date: June 8, 2015

DATE	REV.#	SENT FOR
4/29/15		FOR APPROVAL

DIMENSION
 DIMENSION FABRICATORS INC.
 2000 7TH STREET SCORRA, N.Y. 12302
 PH: (518) 374-1336 FAX: (518) 374-1335 www.dimensionfabricators.com

STRUCTURE: CASTLETON BR F 015-2(10)
 CLOSURE POURS REINFORCING

LOCATION: CASTLETON, VT

ARCHITECT: W.M. SCHULTZ CONSTRUCTION INC.

CUSTOMER: W.M. SCHULTZ CONSTRUCTION INC.

DRAWN BY: Ed Eros DATE: 4/29/15 DPT #: 9248

DRAWING COVERS: BRIDGE END #2 DUAL COATED REINFORCING DRAWING #: D