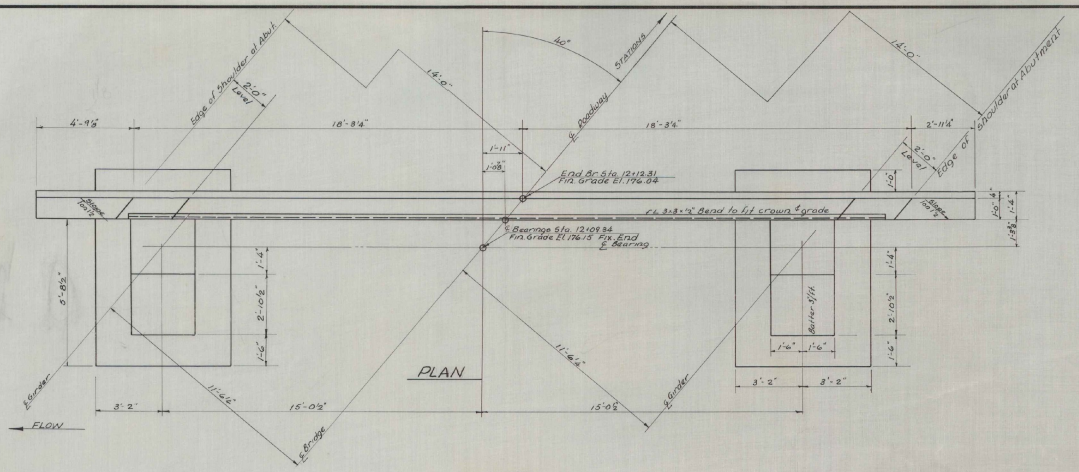

REINFORCING STEEL

MARK	NO.	SIZE	T.L.	DETAILS
F	28	1¼" ⊕	9'-1"	7'-4" 2'-8"
C-1	22	1⅛" ⊕	11'-6"	Straight
C-4	22	¼" ⊕	17'-6"	Straight - Bend to fit in field.
C-12	6	1¼" ⊕	17'-3"	Straight
CW-4	19	⅞" ⊕	42'-8"	11'-0" 9" 18'-6" 9" 11'-0"

cut both ends to fit in field where necessary

CW-5	23	½" ⊕	8'-6"	Straight - cut to fit in field.

NOTES :-

Curtain wall above bridge seats shall be poured after the concrete deck is in place.

Structural steel shown on this sheet is included in the "STEEL SUPERSTRUCTURE" quantity of the superstructure sheet.

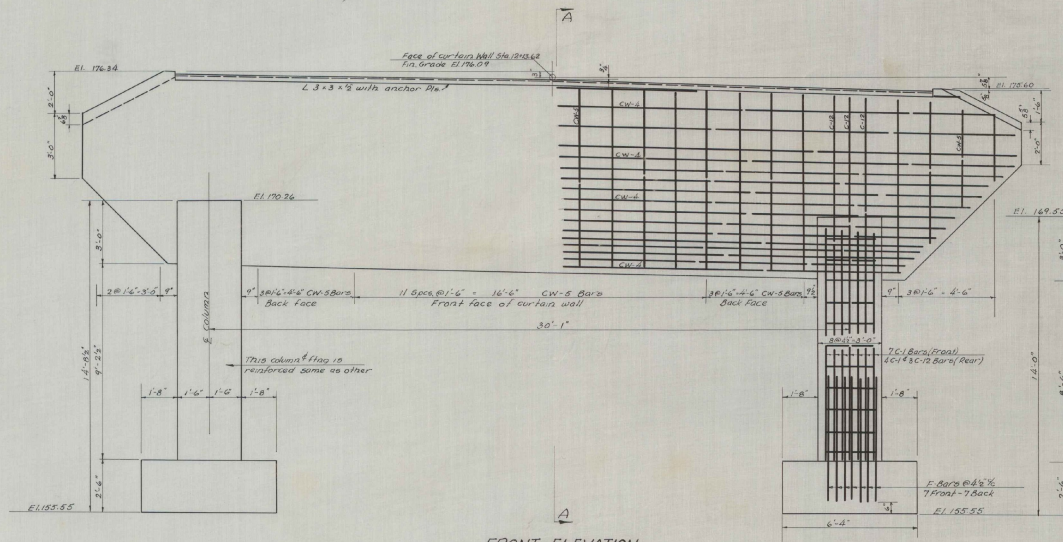

FRONT ELEVATION

(All curtain wall elevations are on front face)

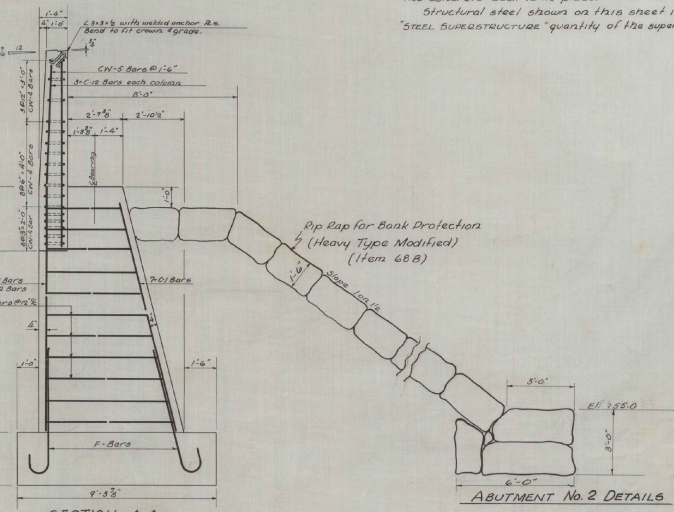

SECTION A-A

ABUTMENT No. 2 DETAILS

SABIN BRIDGE

WESTMINSTER

Scale ⅜" = 1'-0"

ESTIMATED QUANTITIES

Concrete Class "A"	40 C.Y.
Reinforcing Steel	5100 Lbs.
Structure Excav.	80 C.Y.
Channel Excav.	450 C.Y.
Rip Rap for Bank Protect. (H.T.M.)	250 C.Y.

Surveyed by		
Designed by	W.A.S.	
Drawn by	W.A.S.	6-28-40
Traced by	H.N.S.	
Checked by	W.H.D.	
Series	No.	Filed
	Sheet 11 of 31 Sheets	