


ABUTMENT 1 CLOSURE POUR TOP VIEW

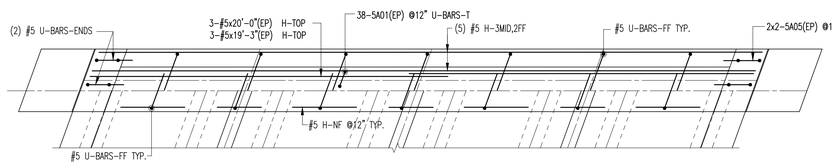


ABUTMENT 1 CLOSURE POUR ELEVATION

PLEASE INCLUDE BAR MARKS SHOWN IN ELEVATION AND TOP VIEW IN SECTION VIEW AS WELL.




ABUTMENT 2 CLOSURE POUR TOP VIEW

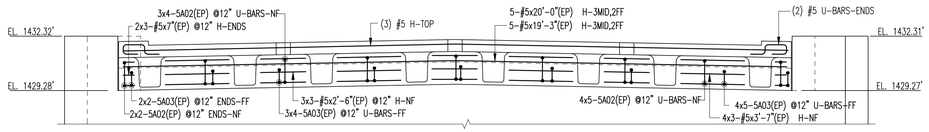ONLY 2? WHAT ABOUT REINFORCING FOR POSTS? (TYP)

INCLUDE BAR MARK

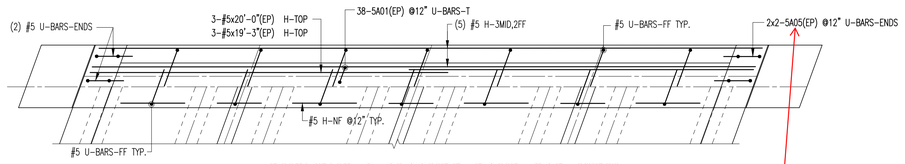


ABUTMENT 2 CLOSURE POUR ELEVATION

INCLUDE BAR MARKS (TYP)

VERIFY DIMENSIONS FOR THICKENED FLANGE

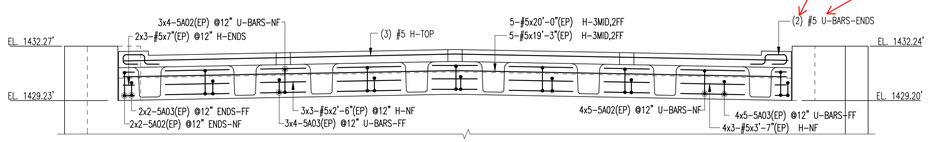


VERIFY DIMENSION

WHAT DOES THIS MEAN? (TYP)

ABUTMENT CLOSURE POUR SECTION

| Drawing Sheet : R01 | | | | | | BAR LIST | | | | | | | | | | | |
|---|---|---|---|---|---|---|---|---|---|---|---|---|---|---|---|---|---|
| Bar Mark | Qty | Size | Total Length | Type | 'A' | 'B' | 'C' | 'D' | 'E' | 'F' | 'G' | 'H' | 'J' | 'K' | 'O' | 'R' |
| 5A01 | 76 | #5 | 4'-11" | 17 | | 2'-0" | 11" | 2'-0" | | | | | | | | |
| 5A02 | 72 | #5 | 5'-8" | 17 | | 2'-1" | 1'-4" | 2'-1" | | | | | | | | |
| 5A03 | 72 | #5 | 5'-1" | 17 | | 2'-2" | 9" | 2'-2" | | | | | | | | |
| 5A05 | 8 | #5 | 4'-1" | H68 | | 10" | 7" | 1'-3" | 7" | 10" | | | | | | 2'-4" |

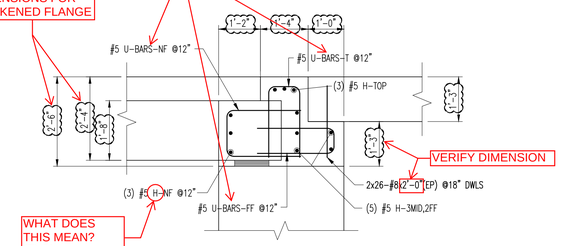


ALL MATERIAL ON THIS DRAWING NOTED AS "EP" SHAL BE ASTM A1055 GR60 "DUAL COATED"

PLACING DRAWING APPROVAL AUTHORITY: VERIFICATION OF DIMENSIONS, DETAILS, ETC ARE REQUESTED WHERE INDICATED. IF EACH VERIFICATION IS NOT NOTED OTHERWISE, IT WILL BE ASSUMED TO BE CORRECT AS SHOWN.

ENG. AND ARCH. PLEASE VERIFY ALL CLOUDED AREAS

LAP CHART-U.N.O.
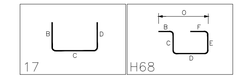
| | | |
|---|---|---|
| #11 | | |
| #10 | | |
| #9 | | |
| #8 | | |
| #7 | | |
| #6 | | |
| #5 | 26" | 26" |
| #4 | | |
| #3 | | |
| SIZE | TOP BARS ★ | OTHER BARS |

★ -Top bars are horiz. bars with more than 12" of concrete cast below the bars.

CLARIFY? (TYP)

PLEASE SHOW THE CLOSURE POURS IN PLAN VIEW.




ALSO INCLUDE A DECK CLOSURE POUR SECTION AT THE THICKENED FLANGE.

DECK CLOSURE POUR REINF.




APPROACH SLAB CLOSURE POUR

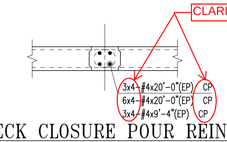PROVIDE 3" CLR

Vermont Agency of Transportation

Vermont Closure Pour Reinforcing (R01).pdf

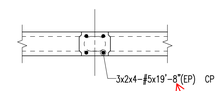RECEIVED

ON: January 20, 2016

and Checked for

CONFORMANCE

BY: Jennifer Fitch DATE: 02/16/2016

## SHOP DRAWING REVIEW

☐ REVIEWED AS REQUIRED BY THE CONSTRUCTION CONTRACT DOCUMENTS AND APPROVED, BUT ONLY FOR CONFORMANCE TO THE DESIGN CONCEPT OF THE WORK, AND SUBJECT TO FURTHER LIMITATIONS AND REQUIREMENTS CONTAINED IN THE CONSTRUCTION CONTRACT DOCUMENTS.

☐ REJECTED ☒ REVISE AND RESUBMIT ☐ FURNISH AS CORRECTED

CORRECTIONS OR COMMENTS MADE ON THE SHOP DRAWINGS DURING THIS REVIEW DO NOT RELIEVE CONTRACTOR FROM COMPLIANCE WITH REQUIRMENTS OF THE DRAWINGS AND SPECIFICATIONS. THIS CHECK IS ONLY FOR REVIEW OF GENERAL CONFORMANCE WITH THE DESIGN CONCEPT OF THE PROJECT AND GENERAL COMPLIANCE WITH THE INFORMATION GIVEN IN THE CONTRACT DOCUMENTS. THE CONTRACTOR IS RESPONSIBLE FOR: CONFIRMING AND CORRELATING ALL QUANTITIES AND DIMENSIONS; SELECTING FABRICATION PROCESSES AND TECHNIQUES OF CONSTRUCTION; COORDINATING HIS WORK WITH THAT OF ALL OTHER TRADES; AND PERFORMING HIS WORK IN A SAFE AND SATISFACTORY MANNER.

vhb
40 IDX Drive
Building 100, Suite 200
South Burlington, VT 05403
802.497.6100

Job Number: BF 013-2(13)
Reviewed By: E.F. LAWES
Date: 02-12-2016

| No. | Description | Date | By |
|---|---|---|---|
| 0 | APPROVAL PRINT | 01/11/16 | CPS |

Revisions and Issue Record

The full intent and purpose of this drawing is the placing of reinforcing steel bars ONLY. It is NOT to be used as a means of communication between the Architect, Engineer, Contractor or any other Sub-trades.

THIS DRAWING IS NOT TO BE SCALED.

HarrisRebar Barker Steel — National Strength. Local Service.

DETAILED AT: CANAAN NEW HAMPSHIRE

Project: WESTON BF 013-2(13)
WESTON VT 05161

Drawing: CLOSURE POURS REINFORCEMENT

Customer: THE BELDON CO.

Engineer: VHB

Refer to Release:

| Date | Drawn | Chkd. | JOB No. | Dwg. No. |
|---|---|---|---|---|
| 01/10/16 | CPS | | 33505888 | R01 |

C:\Users\csample\Desktop\HOME JOBS\33505888\Placing Drawings\DWGs\R01.dwg