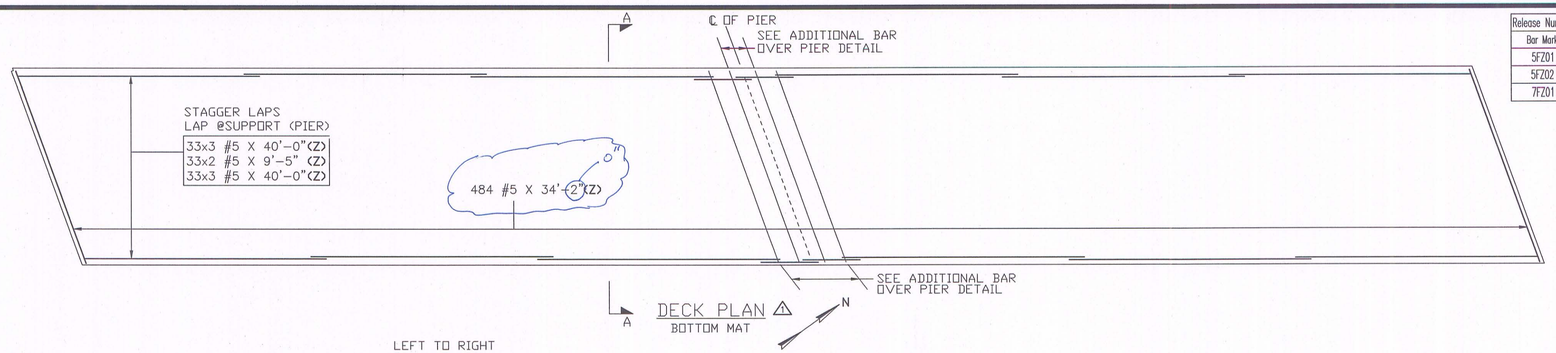

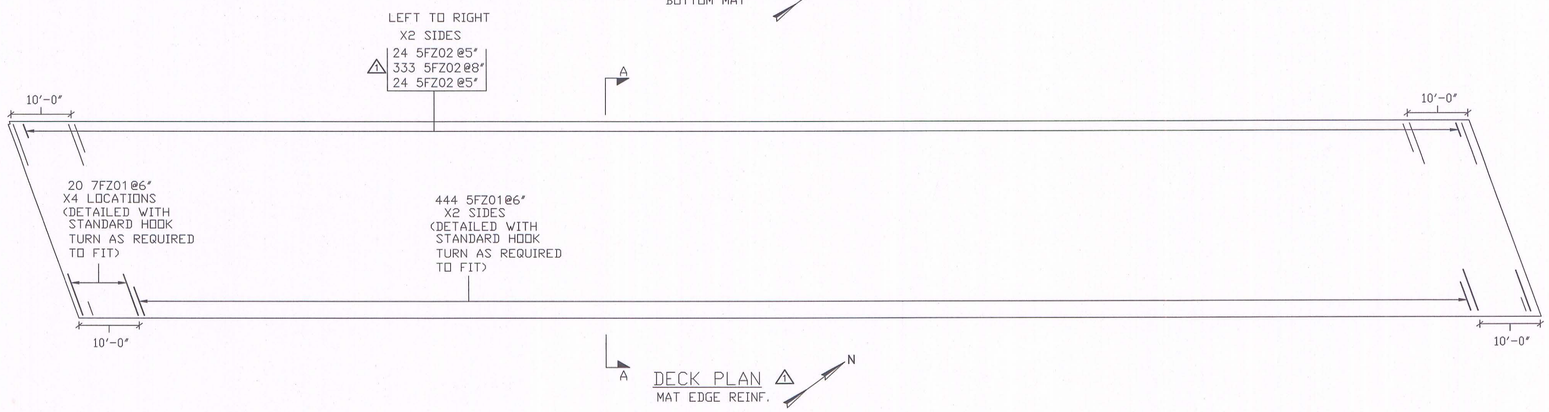

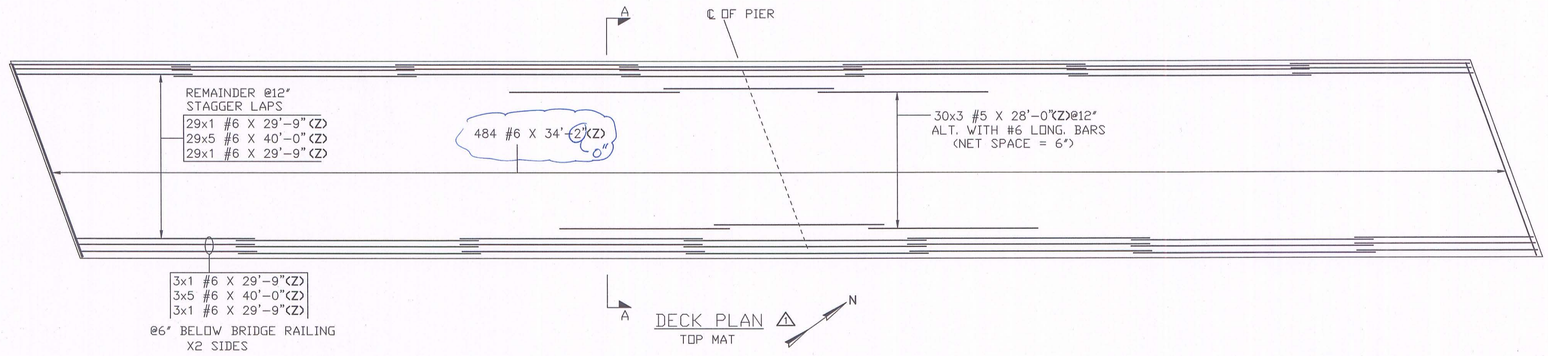

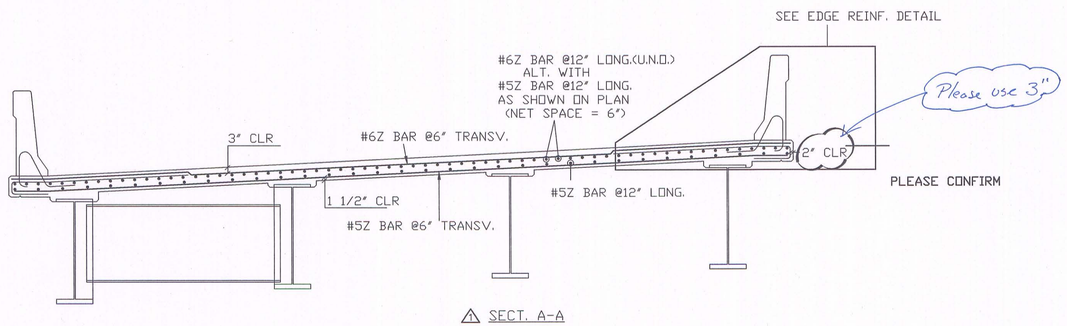

SECT. A-A

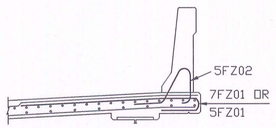

EDGE REINF.
SEE BOTTOM MAT EDGE REINF. PLAN FOR QUANTITY AND SPACING

Release Number: 017					BAR LIST											
Bar Mark	Qty	Size	Total Length	Type	'A'	'B'	'C'	'D'	'E'	'F'	'G'	'H'	'J'	'K'	'O'	'R'
5FZ01	888	#5	5'-11"	1	0'-7"	5'-4"							0'-5"			
5FZ02	762	#5	4'-6 ½"	W45	0'-6"	0'-4 ¾"	0'-11 ¼"	0'-7 ½"	1'-4"	0'-2 ½"	1'-0"					
7FZ01	80	#7	8'-4"	1	0'-10"	7'-6"							0'-7"			

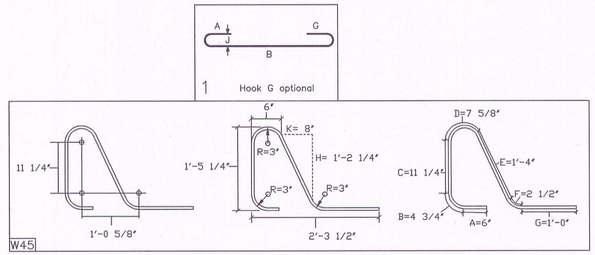

PLEASE CONFIRM

Acceptable

LAP CHART	
BAR SIZE	LAP
#5	2'-6"
#6	3'-0"

Vermont Agency of Transportation

RECEIVED

Jamaica ER BRF 013-2(16) Deck RSS Approved 5-7-2013.pdf

CK'D BY VHB OK'D BY JTS

April 22, 2013

RESUBMIT NO

Approved AsNoted

BY KMH DATE 05/08/13

SHOP DRAWING REVIEW

☐ REVIEWED AS REQUIRED BY THE CONSTRUCTION CONTRACT DOCUMENTS AND APPROVED, BUT ONLY FOR CONFORMANCE TO THE DESIGN CONCEPT OF THE WORK, AND SUBJECT TO FURTHER LIMITATIONS AND REQUIREMENTS CONTAINED IN THE CONSTRUCTION CONTRACT DOCUMENTS.

☐ REJECTED ☐ REVISE AND RESUBMIT ☑ FURNISH AS CORRECTED

CORRECTIONS OR COMMENTS MADE ON THE SHOP DRAWINGS DURING THIS REVIEW DO NOT RELIEVE CONTRACTOR FROM COMPLIANCE WITH REQUIREMENTS OF THE DRAWINGS AND SPECIFICATIONS. THIS CHECK IS ONLY FOR REVIEW OF GENERAL CONFORMANCE WITH THE DESIGN CONCEPT OF THE PROJECT AND GENERAL COMPLIANCE WITH THE INFORMATION GIVEN IN THE CONTRACT DOCUMENTS. THE CONTRACTOR IS RESPONSIBLE FOR: CONFIRMING AND CORRELATING ALL QUANTITIES AND DIMENSIONS; SELECTING FABRICATION PROCESSES AND TECHNIQUES OF CONSTRUCTION; COORDINATING HIS WORK WITH THAT OF ALL OTHER TRADES; AND PERFORMING HIS WORK IN A SAFE AND SATISFACTORY MANNER.

VHB Vanasse Hangen Brustlin, Inc.

Job Number: 57350.00

Reviewed By: G.S. Goodrich

Date: 5-01-2013

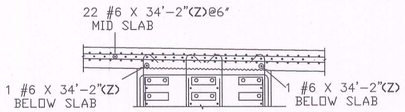

ADDITIONAL BAR OVER PIER

ALL BAR ON THIS DWG. IS DUAL COATED

-ELEVATIONS & DIMENSIONS SHOWN ON THIS DWG. ARE FOR REINF. DETAILING PURPOSES ONLY AND ARE NOT INTENDED FOR CONSTRUCTION.

-DUAL COATED BAR - ASTM A1055M (Z BAR)

-DUAL COATED BAR DENOTED (Z)

FOR APPROVAL

6			
5			
4			
3			
2	04/22/13	⚠	REV'D PER INTERNAL REVIEW/APPROVAL
1	04/19/13	0	APPROVAL
	DATE	REV.#	SENT FOR

DIMENSION
DIMENSION FABRICATORS INC.
2000 7TH STREET
SCOTIA, N.Y. 12302
PH: (518) 374-1936
FAX (518) 374-4830
www.dimensionfabricators.com

STRUCTURE	VTAOT JAMAICA ER BRF 013-1(16)
LOCATION	RTE 1005 JAMAICA, VT
ARCHITECT	
ENGINEER	
CUSTOMER	T. BUCK CONSTRUCTION

DRAWN BY	DATE	DFI #
WAYNE	04/19/13	8421

DRAWING COVERS	DRAWING #
DECK REINF.	F