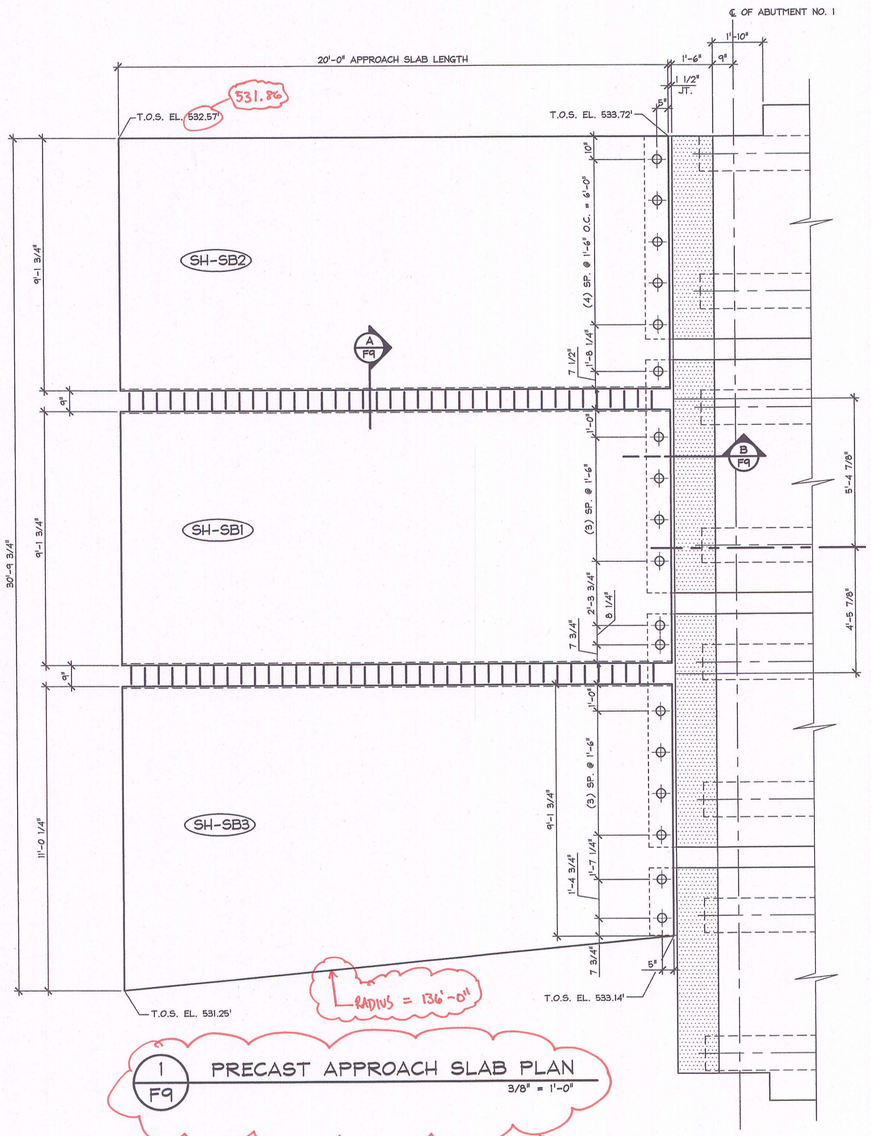

1 / F9 PRECAST APPROACH SLAB PLAN
3/8" = 1'-0"

APPROACH SLAB NO 1 PLAN

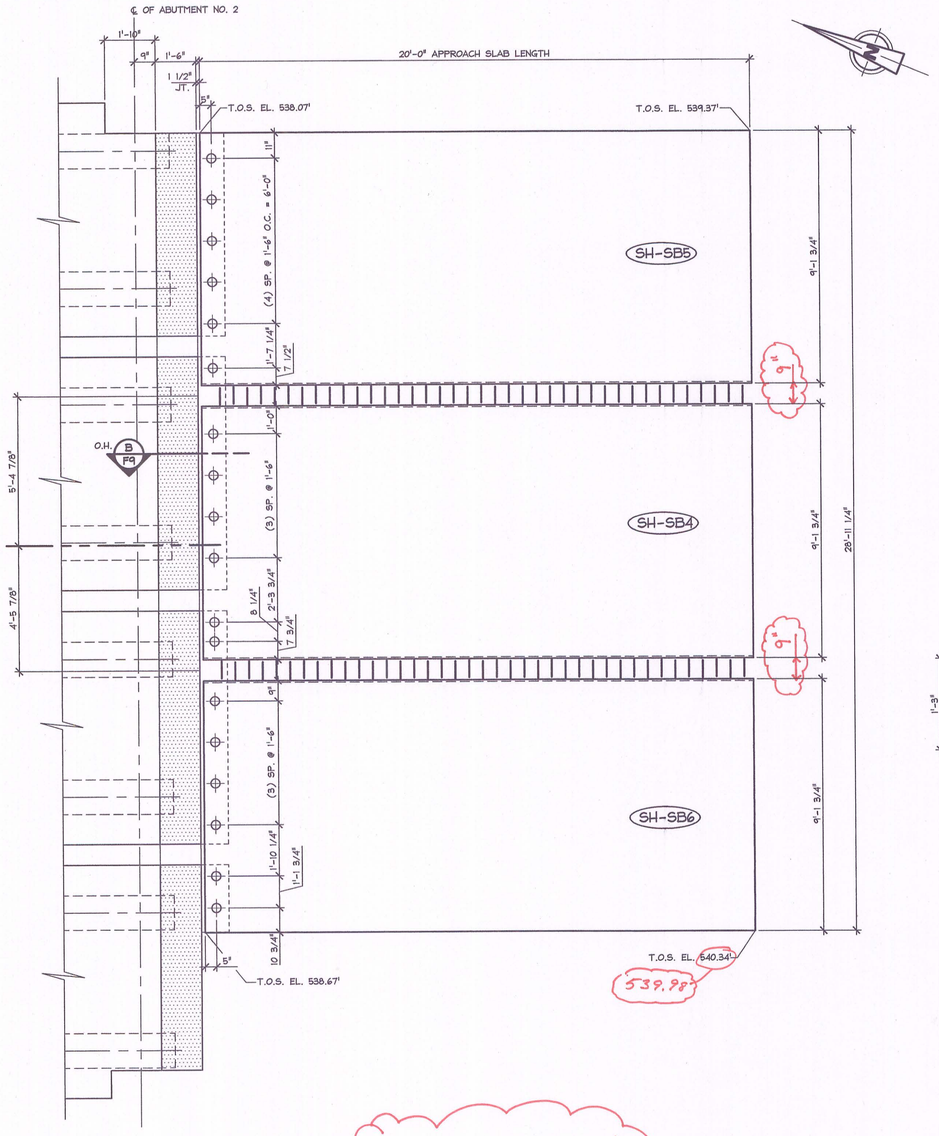

APPROACH SLAB NO 2 PLAN

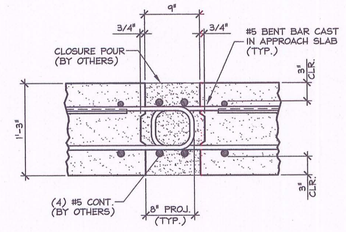

A / F9 CLOSURE POUR
1" = 1'-0"

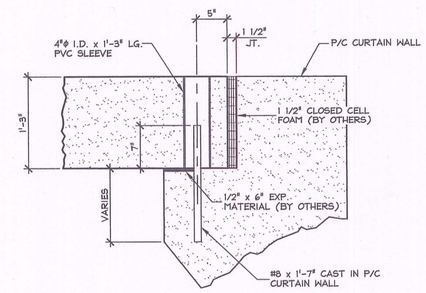

B / F9 BEARING SECTION
1" = 1'-0"

SUBMITTED
DEC 12 2013
J. P. CARRARA & SONS, INC.
MIDDLEBURY, VT 05753

Vermont Agency of Transportation
RECEIVED
ON: December 13, 2013
and Checked for
CONFORMANCE
BY: Jennifer Fitch DATE: 12/23/2013

SHOP DRAWING REVIEW

☐ REVIEWED AS REQUIRED BY THE CONSTRUCTION CONTRACT DOCUMENTS AND APPROVED, BUT ONLY FOR CONFORMANCE TO THE DESIGN CONCEPT OF THE WORK, AND SUBJECT TO FURTHER LIMITATIONS AND REQUIREMENTS CONTAINED IN THE CONSTRUCTION CONTRACT DOCUMENTS.
☐ REJECTED ☑ REVISE AND RESUBMIT ☐ FURNISH AS CORRECTED

CORRECTIONS OR COMMENTS MADE ON THE SHOP DRAWINGS DURING THIS REVIEW DO NOT RELIEVE CONTRACTOR FROM COMPLIANCE WITH REQUIREMENTS OF THE DRAWINGS AND SPECIFICATIONS. THIS CHECK IS ONLY FOR REVIEW OF GENERAL CONFORMANCE WITH THE DESIGN CONCEPT OF THE PROJECT AND GENERAL COMPLIANCE WITH THE INFORMATION GIVEN IN THE CONTRACT DOCUMENTS. THE CONTRACTOR IS RESPONSIBLE FOR: CONFIRMING AND CORRELATING ALL QUANTITIES AND DIMENSIONS; SELECTING FABRICATION PROCESSES AND TECHNIQUES OF CONSTRUCTION; COORDINATING HIS WORK WITH THAT OF ALL OTHER TRADES; AND PERFORMING HIS WORK IN A SAFE AND SATISFACTORY MANNER.

VHB Vanasse Hangen Brustlin, Inc.
Job Number: 57434.00
Reviewed By: G.S. Goodrich
Date: 12-19-2013

APPROVAL STAMP:

J.P. CARRARA & SONS INC.
Precast & Prestress Manufacturer
2464 CASE STR., MIDDLEBURY, VERMONT 05753 Phone:(802)388-6361 Fax:(802)388-9010

T. BUCK CONSTRUCTION
CONTRACTOR
AUBURN, MAINE

STATE OF VERMONT AGENCY OF TRANSPORTATION
COUNTY OF ADDISON

TOWN OF MIDDLEBURY
ROUTE NO. VT 125, EAST MIDDLEBURY GORGE
BRIDGE NO.: 13 PROJECT NO.: RS 0174(8)

APPROACH SLAB LAYOUT

DATE:	OCT. 9, 2013
SCALE:	NOTED
CHKD:	DFTM: T.D.
JOB NO:	
DWG. NO:	F9

F:\VT-Bridges\East Middlebury Gorge\23411-013 F9.dwg, 12/12/2013 11:12:08 AM

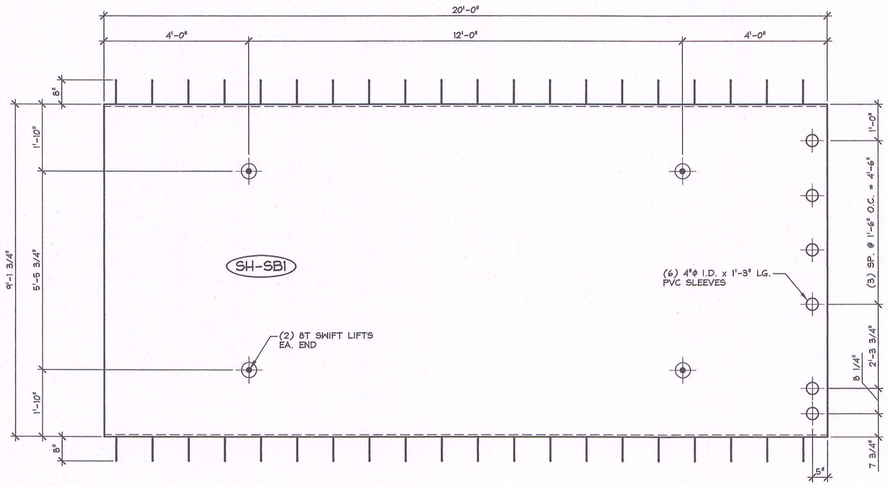

1 / AS1 PLAN VIEW IN FORM
1/2" = 1'-0"

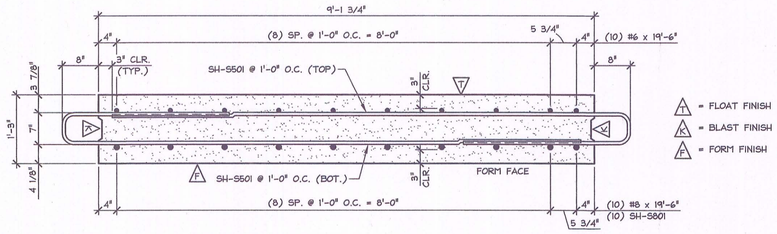

A / AS1 REINFORCING SECTION
3/4" = 1'-0"

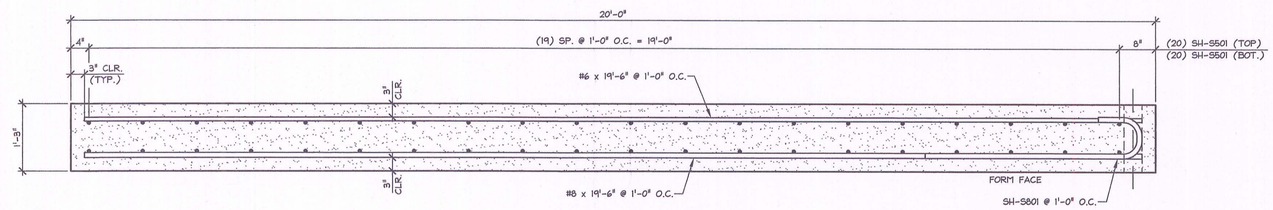

B / AS1 REINFORCING SECTION
3/4" = 1'-0"

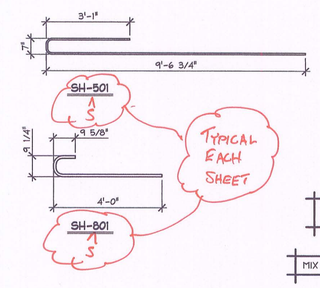

3500 PSI @ RELEASE
5000 PSI @ 28 DAYS

MIX DESIGN: 445MSCC

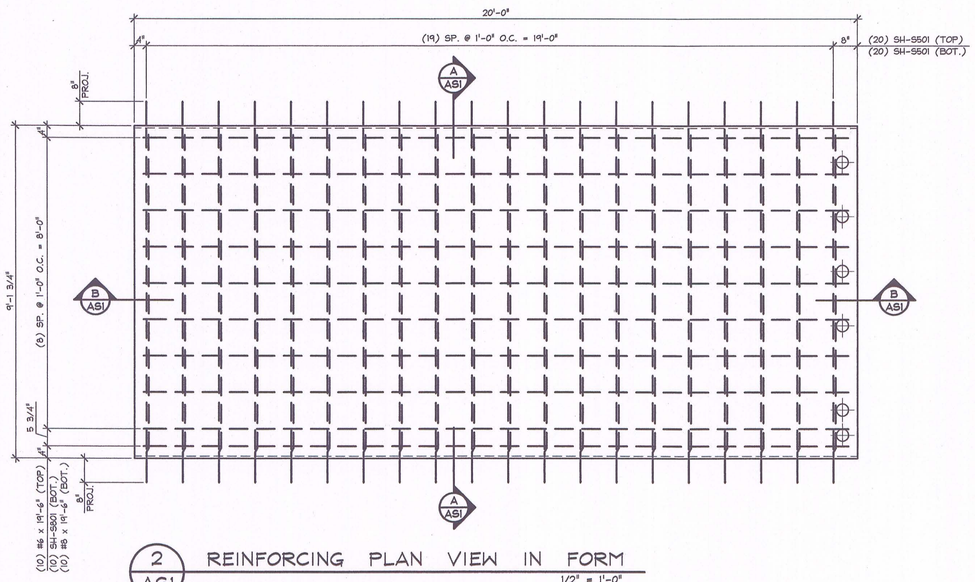

2 / AS1 REINFORCING PLAN VIEW IN FORM
1/2" = 1'-0"

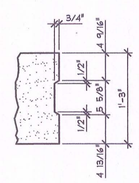

KEYWAY DETAIL
1" = 1'-0"

MARK: SH-SB1	QTY.: 1	WT.: 17.08 T	VOL.: 8.43 cy

MATERIAL LIST / ARCH PANEL

ITEM	MARK	DESCRIPTION	QTY.
1		#6 x 19'-6" BLACK	10
2		#8 x 19'-6" BLACK	10
3			
4			
5	SH-5501	#5 BENT BAR BLACK	40
6	SH-5801	#8 BENT BAR BLACK	10
7			
8			
9			
10		DAYTON 8T x 10' SWIFT LIFT ANCHORS (WITH RECESS PLUG)	4
11			
12		4"Ø I.D. x 1'-3" LG. PVC SLEEVE	6
13			
14			
15			

Vermont Agency of Transportation
RECEIVED
ON: December 13, 2013
and Checked for
CONFORMANCE
BY: Jennifer Fitch DATE: 12/23/2013

SUBMITTED
DEC 12 2013
J. P. CARRARA & SONS, INC.
MIDDLEBURY, VT 05753

SHOP DRAWING REVIEW
☐ REVIEWED AS REQUIRED BY THE CONSTRUCTION CONTRACT DOCUMENTS AND APPROVED, BUT ONLY FOR CONFORMANCE TO THE DESIGN CONCEPT OF THE WORK, AND SUBJECT TO FURTHER LIMITATIONS AND REQUIREMENTS CONTAINED IN THE CONSTRUCTION CONTRACT DOCUMENTS.
☐ REJECTED ☑ REVISE AND RESUBMIT ☐ FURNISH AS CORRECTED
CORRECTIONS OR COMMENTS MADE ON THE SHOP DRAWINGS DURING THIS REVIEW DO NOT RELIEVE CONTRACTOR FROM COMPLIANCE WITH REQUIREMENTS OF THE DRAWINGS AND SPECIFICATIONS. THIS CHECK IS ONLY FOR REVIEW OF GENERAL CONFORMANCE WITH THE DESIGN CONCEPT OF THE PROJECT AND GENERAL COMPLIANCE WITH THE INFORMATION GIVEN IN THE CONTRACT DOCUMENTS. THE CONTRACTOR IS RESPONSIBLE FOR: CONFIRMING AND CORRELATING ALL QUANTITIES AND DIMENSIONS; SELECTING FABRICATION PROCESSES AND TECHNIQUES OF CONSTRUCTION; COORDINATING HIS WORK WITH THAT OF ALL OTHER TRADES; AND PERFORMING HIS WORK IN A SAFE AND SATISFACTORY MANNER.
VHB Vanasse Hangen Brustlin, Inc.
Job Number: 37938.00
Reviewed By: G.S. Goldrick
Date: 12-19-2013

APPROVAL STAMP:

J.P. CARRARA & SONS INC.
Precast & Prestress Manufacturer
2464 CASE STR., MIDDLEBURY, VERMONT 05753 Phone:(802)388-6361 Fax:(802)388-9010

T. BUCK CONSTRUCTION
CONTRACTOR
AUBURN, MAINE

STATE OF VERMONT AGENCY OF TRANSPORTATION
COUNTY OF ADDISON

TOWN OF MIDDLEBURY
ROUTE NO. VT 125, EAST MIDDLEBURY GORGE
BRIDGE NO.: 13 PROJECT NO.: RS 0174(8)

APPROACH SLAB DETAILS

DATE: OCT. 9, 2013
SCALE: NOTED
CHKD: DFTM: T.D.
JOB NO:
DWG. NO: AS1

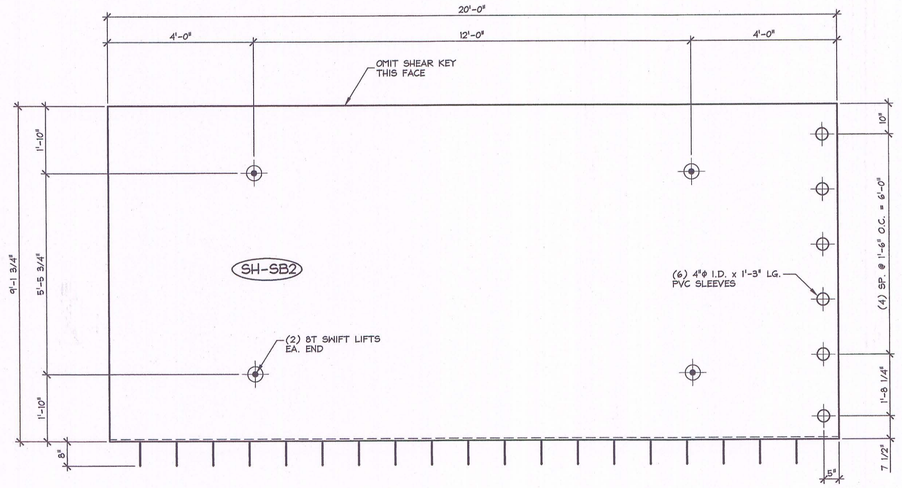

1 / AS2 PLAN VIEW IN FORM
1/2" = 1'-0"

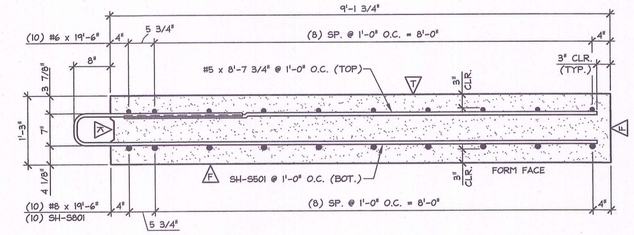

A = FLOAT FINISH
B = BLAST FINISH
F = FORM FINISH

A / AS2 REINFORCING SECTION
3/4" = 1'-0"

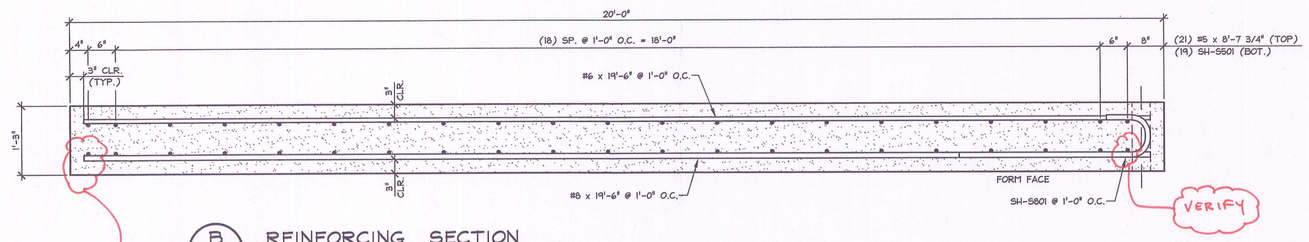

VERIFY

B / AS2 REINFORCING SECTION
3/4" = 1'-0"

VERIFY BAR SIZE, TYPE AND QUANTITY (TYPICAL)

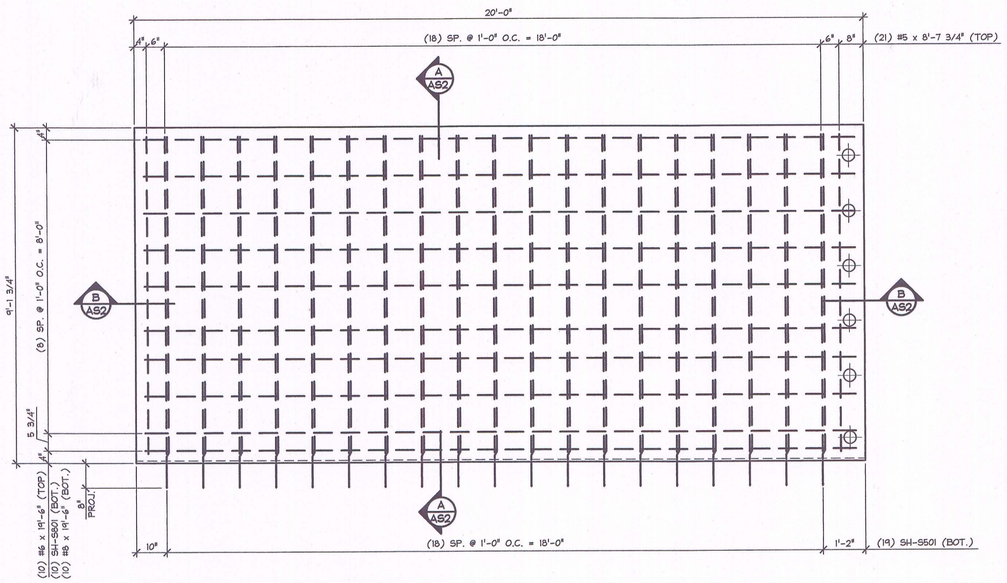

2 / AS2 REINFORCING PLAN VIEW IN FORM
1/2" = 1'-0"

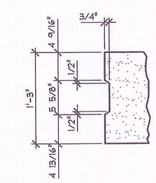

KEYWAY DETAIL
1" = 1'-0"

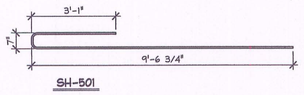

SH-501

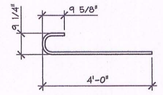

SH-801

3500 PSI @ RELEASE
5000 PSI @ 28 DAYS

MIX DESIGN: 445MSCC

MARK: SH-SB2	QTY.: 1	WT.: 17.08 T	VOL.: 8.43 cy

MATERIAL LIST / ARCH PANEL

ITEM	MARK	DESCRIPTION	QTY.
1		#6 x 19'-6" BLACK	10
2		#8 x 19'-6" BLACK	10
3		#5 x 8'-7 3/4" BLACK	21
4			
5	SH-S501	#5 BENT BAR BLACK	19
6	SH-S801	#8 BENT BAR BLACK	10
7			
8			
9			
10		DAYTON 8T x 10" SWIFT LIFT ANCHORS (WITH RECESS PLUG)	4
11			
12		4"Φ I.D. x 1'-3" LG. PVC SLEEVE	6
13			
14			
15			

Vermont Agency of Transportation
RECEIVED
ON: December 13, 2013
and Checked for
CONFORMANCE
BY: Jennifer Fitch DATE: 12/23/2013

SUBMITTED
DEC 12 2013
J. P. CARRARA & SONS, INC.
MIDDLEBURY, VT 05753

SHOP DRAWING REVIEW

☐ REVIEWED AS REQUIRED BY THE CONSTRUCTION CONTRACT DOCUMENTS AND APPROVED, BUT ONLY FOR CONFORMANCE TO THE DESIGN CONCEPT OF THE WORK, AND SUBJECT TO FURTHER LIMITATIONS AND REQUIREMENTS CONTAINED IN THE CONSTRUCTION CONTRACT DOCUMENTS.
☐ REJECTED ☑ REVISE AND RESUBMIT ☐ FURNISH AS CORRECTED

CORRECTIONS OR COMMENTS MADE ON THE SHOP DRAWINGS DURING THIS REVIEW DO NOT RELIEVE CONTRACTOR FROM COMPLIANCE WITH REQUIREMENTS OF THE DRAWINGS AND SPECIFICATIONS. THIS CHECK IS ONLY FOR REVIEW OF GENERAL CONFORMANCE WITH THE DESIGN CONCEPT OF THE PROJECT AND GENERAL COMPLIANCE WITH THE INFORMATION GIVEN IN THE CONTRACT DOCUMENTS. THE CONTRACTOR IS RESPONSIBLE FOR: CONFIRMING AND CORRELATING ALL QUANTITIES AND DIMENSIONS; SELECTING FABRICATION PROCESSES AND TECHNIQUES OF CONSTRUCTION; COORDINATING HIS WORK WITH THAT OF ALL OTHER TRADES; AND PERFORMING HIS WORK IN A SAFE AND SATISFACTORY MANNER.

VHB Vanasse Hangen Brustlin, Inc.
Job Number: 5743.2.00
Reviewed By: G.S. Goodrich
Date: 12-19-2013

APPROVAL STAMP:

J.P. CARRARA & SONS INC.
Precast & Prestress Manufacturer
2464 CASE STR., MIDDLEBURY, VERMONT 05753 Phone:(802)388-6361 Fax:(802)388-9010

T. BUCK CONSTRUCTION
CONTRACTOR
AUBURN, MAINE

STATE OF VERMONT AGENCY OF TRANSPORTATION
COUNTY OF ADDISON

TOWN OF MIDDLEBURY
ROUTE NO. VT 125, EAST MIDDLEBURY GORGE
BRIDGE NO.: 13 PROJECT NO.: RS 0174(8)

APPROACH SLAB DETAILS

DATE: OCT. 9, 2013
SCALE: NOTED
CHKD: DFTM: T.D.
JOB NO:
DWG. NO: AS2

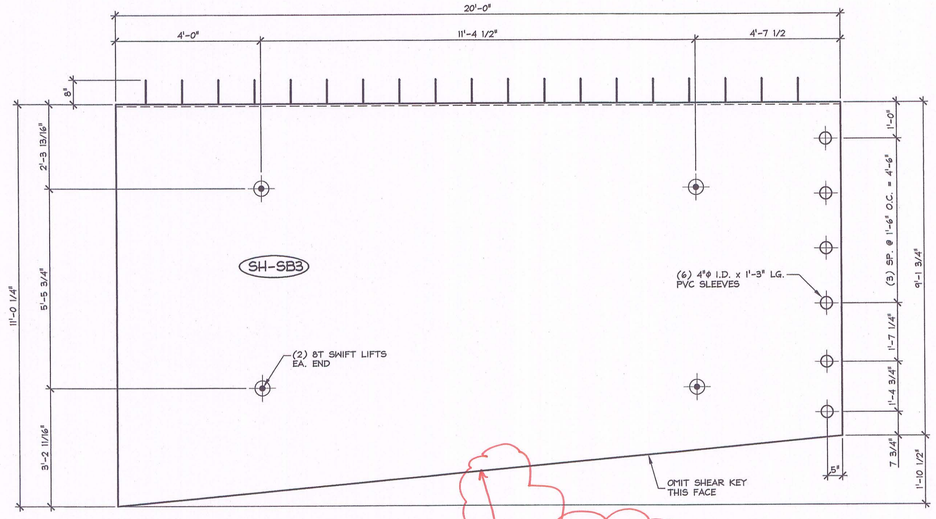

RADIUS = 136'-0"

1 / AS3 PLAN VIEW IN FORM
1/2" = 1'-0"

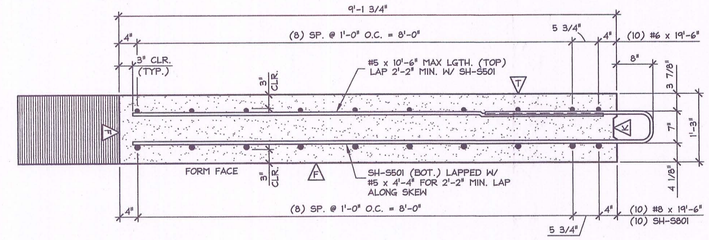

A / AS3 REINFORCING SECTION
3/4" = 1'-0"

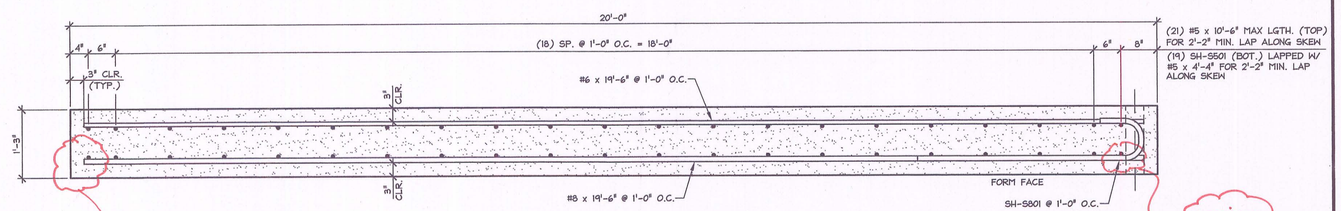

VERIFY

B / AS3 REINFORCING SECTION
3/4" = 1'-0"

VERIFY BAR SIZE, TYPE AND QUANTITY (TYP.)

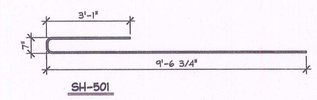

SH-501

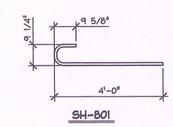

SH-801

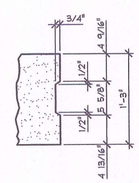

KEYWAY DETAIL
1" = 1'-0"

3500 PSI @ RELEASE
5000 PSI @ 28 DAYS

MIX DESIGN: 445MSCC

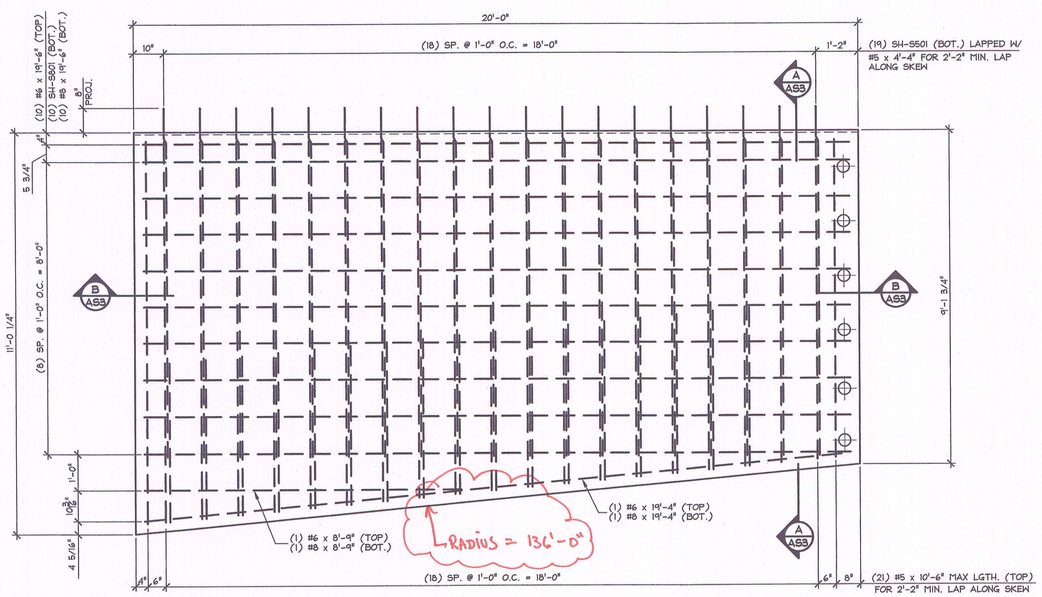

RADIUS = 136'-0"

2 / AS3 REINFORCING PLAN VIEW IN FORM
1/2" = 1'-0"

MARK: SH-SB3	QTY.: 1	WT.: 18,91 T	VOL.: 9.33 cy

MATERIAL LIST / ARCH PANEL

ITEM	MARK	DESCRIPTION	QTY.
1		#8 x 19'-6" BLACK	10
2		#8 x 19'-4" BLACK	1
3		#8 x 8'-9" BLACK	1
4		#6 x 19'-6" BLACK	10
5		#6 x 19'-4" BLACK	1
6		#6 x 8'-9" BLACK	1
7		#5 x 10'-6" BLACK	21
8		#5 x 4'-4" BLACK	17
9			
10	SH-S501	#5 BENT BAR BLACK	19
11	SH-S801	#8 BENT BAR BLACK	10
12			
13		DAYTON 8T x 10" SWIFT LIFT ANCHORS (WITH RECESS PLUG)	4
14		4"Φ I.D. x 1'-3" LG. PVC SLEEVE	6
15			

Vermont Agency of Transportation
RECEIVED
ON: December 13, 2013
and Checked for
CONFORMANCE
BY: Jennifer Fitch DATE: 12/23/2013

SUBMITTED
DEC 12 2013
J. P. CARRARA & SONS, INC.
MIDDLEBURY, VT 05753

SHOP DRAWING REVIEW

☐ REVIEWED AS REQUIRED BY THE CONSTRUCTION CONTRACT DOCUMENTS AND APPROVED, BUT ONLY FOR CONFORMANCE TO THE DESIGN CONCEPT OF THE WORK, AND SUBJECT TO FURTHER LIMITATIONS AND REQUIREMENTS CONTAINED IN THE CONSTRUCTION CONTRACT DOCUMENTS.

☐ REJECTED ☑ REVISE AND RESUBMIT ☐ FURNISH AS CORRECTED

CORRECTIONS OR COMMENTS MADE ON THE SHOP DRAWINGS DURING THIS REVIEW DO NOT RELIEVE CONTRACTOR FROM COMPLIANCE WITH REQUIREMENTS OF THE DRAWINGS AND SPECIFICATIONS. THIS CHECK IS ONLY FOR REVIEW OF GENERAL CONFORMANCE WITH THE DESIGN CONCEPT OF THE PROJECT AND GENERAL COMPLIANCE WITH THE INFORMATION GIVEN IN THE CONTRACT DOCUMENTS. THE CONTRACTOR IS RESPONSIBLE FOR: CONFIRMING AND CORRELATING ALL QUANTITIES AND DIMENSIONS; SELECTING FABRICATION PROCESSES AND TECHNIQUES OF CONSTRUCTION; COORDINATING HIS WORK WITH THAT OF ALL OTHER TRADES; AND PERFORMING HIS WORK IN A SAFE AND SATISFACTORY MANNER.

VHB Vanasse Hangen Brustlin, Inc.
Job Number: 57453.00
Reviewed By: G.S. Goodrich
Date: 12-19-2013

APPROVAL STAMP:

J.P. CARRARA & SONS INC.
Precast & Prestress Manufacturer
2464 CASE STR., MIDDLEBURY, VERMONT 05753 Phone:(802)388-6361 Fax:(802)388-9010

T. BUCK CONSTRUCTION
CONTRACTOR
AUBURN, MAINE

STATE OF VERMONT AGENCY OF TRANSPORTATION
COUNTY OF ADDISON

TOWN OF MIDDLEBURY
ROUTE NO. VT 125, EAST MIDDLEBURY GORGE
BRIDGE NO.: 13 PROJECT NO.: RS 0174(8)

APPROACH SLAB DETAILS

DATE: OCT. 9, 2013
SCALE: NOTED
CHKD: DFTM: T.D.
JOB NO:
DWG. NO: AS3

F:\VT-Bridges\East Middlebury Gorge\23411-013 AS3.dwg, 12/12/2013 12:16:37 PM

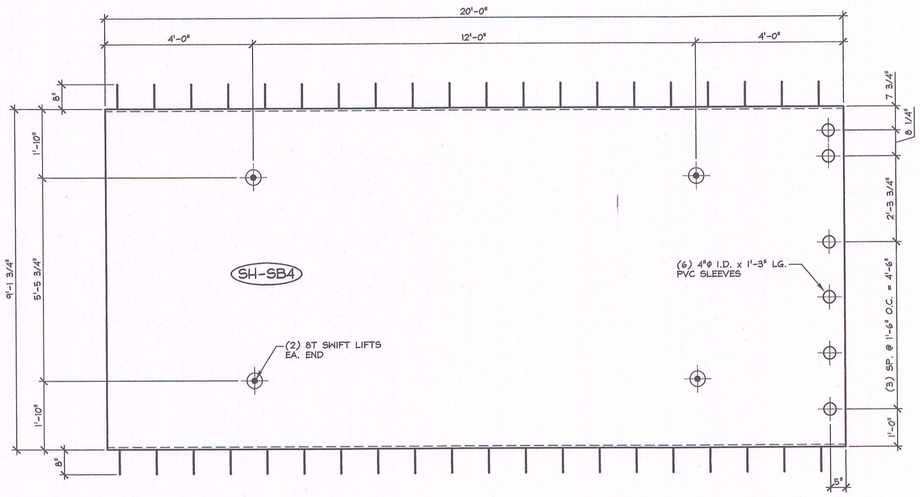

1 AS4 PLAN VIEW IN FORM
1/2" = 1'-0"

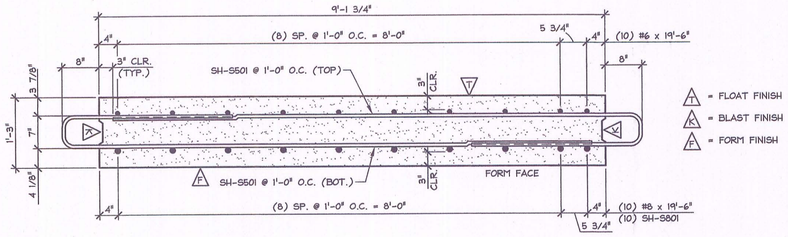

A AS4 REINFORCING SECTION
3/4" = 1'-0"

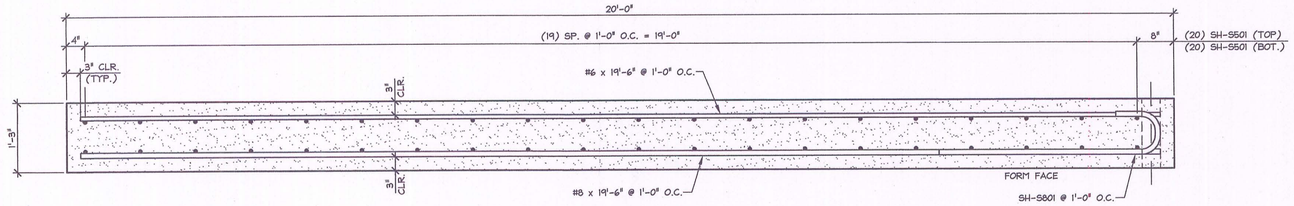

B AS4 REINFORCING SECTION
3/4" = 1'-0"

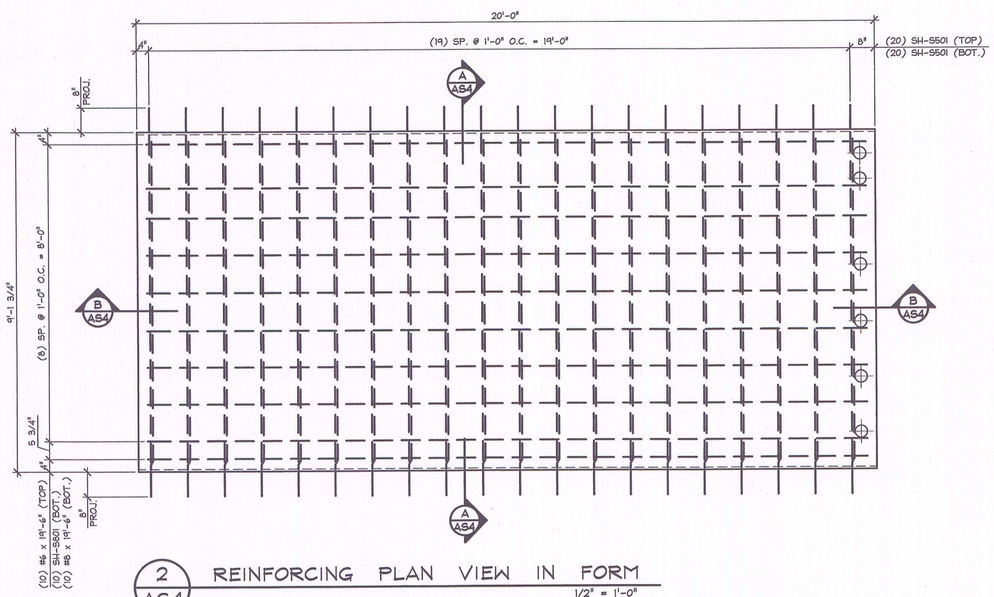

2 AS4 REINFORCING PLAN VIEW IN FORM
1/2" = 1'-0"

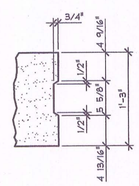

KEYWAY DETAIL
1" = 1'-0"

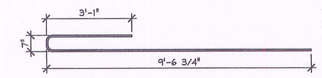

SH-501

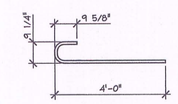

SH-801

3500 PSI @ RELEASE
5000 PSI @ 28 DAYS

MIX DESIGN: 445MSCC

MARK: SH-SB4	QTY.: 1	WT.: 17.08 T	VOL.: 8.43 cy

MATERIAL LIST / ARCH PANEL

ITEM	MARK	DESCRIPTION	QTY.
1		#6 x 19'-6" BLACK	10
2		#8 x 19'-6" BLACK	10
3			
4			
5	SH-S501	#5 BENT BAR BLACK	40
6	SH-S801	#8 BENT BAR BLACK	10
7			
8			
9			
10		DAYTON 8T x 10" SWIFT LIFT ANCHORS (WITH RECESS PLUG)	4
11			
12		4"ϕ I.D. x 1'-3" LG. PVC SLEEVE	6
13			
14			
15			

Vermont Agency of Transportation
RECEIVED
ON: December 13, 2013
and Checked for
CONFORMANCE
BY: Jennifer Fitch DATE: 12/23/2013

SUBMITTED
DEC 12 2013
J. P. CARRARA & SONS, INC.
MIDDLEBURY, VT 05753

SHOP DRAWING REVIEW
☐ REVIEWED AS REQUIRED BY THE CONSTRUCTION CONTRACT DOCUMENTS AND APPROVED, BUT ONLY FOR CONFORMANCE TO THE DESIGN CONCEPT OF THE WORK, AND SUBJECT TO FURTHER LIMITATIONS AND REQUIREMENTS CONTAINED IN THE CONSTRUCTION CONTRACT DOCUMENTS.
☐ REJECTED ☑ REVISE AND RESUBMIT ☐ FURNISH AS CORRECTED
CORRECTIONS OR COMMENTS MADE ON THE SHOP DRAWINGS DURING THIS REVIEW DO NOT RELIEVE CONTRACTOR FROM COMPLIANCE WITH REQUIREMENTS OF THE DRAWINGS AND SPECIFICATIONS. THIS CHECK IS ONLY FOR REVIEW OF GENERAL CONFORMANCE WITH THE DESIGN CONCEPT OF THE PROJECT AND GENERAL COMPLIANCE WITH THE INFORMATION GIVEN IN THE CONTRACT DOCUMENTS. THE CONTRACTOR IS RESPONSIBLE FOR: CONFIRMING AND CORRELATING ALL QUANTITIES AND DIMENSIONS; SELECTING FABRICATION PROCESSES AND TECHNIQUES OF CONSTRUCTION; COORDINATING HIS WORK WITH THAT OF ALL OTHER TRADES; AND PERFORMING HIS WORK IN A SAFE AND SATISFACTORY MANNER.
VHB Vanasse Hangen Brustlin, Inc.
Job Number: 57458.00
Reviewed By: G.S. Gordon
Date: 12-19-2013

APPROVAL STAMP:

J.P. CARRARA & SONS INC.
Precast & Prestress Manufacturer
2464 CASE STR., MIDDLEBURY, VERMONT 05753 Phone:(802)388-6361 Fax:(802)388-9010

T. BUCK CONSTRUCTION
CONTRACTOR
AUBURN, MAINE

STATE OF VERMONT AGENCY OF TRANSPORTATION
COUNTY OF ADDISON

TOWN OF MIDDLEBURY
ROUTE NO. VT 125, EAST MIDDLEBURY GORGE
BRIDGE NO.: 13 PROJECT NO.: RS 0174(8)

APPROACH SLAB DETAILS

DATE: OCT. 9, 2013
SCALE: NOTED
CHKD: DFTM: T.D.
JOB NO:
DWG. NO: AS4

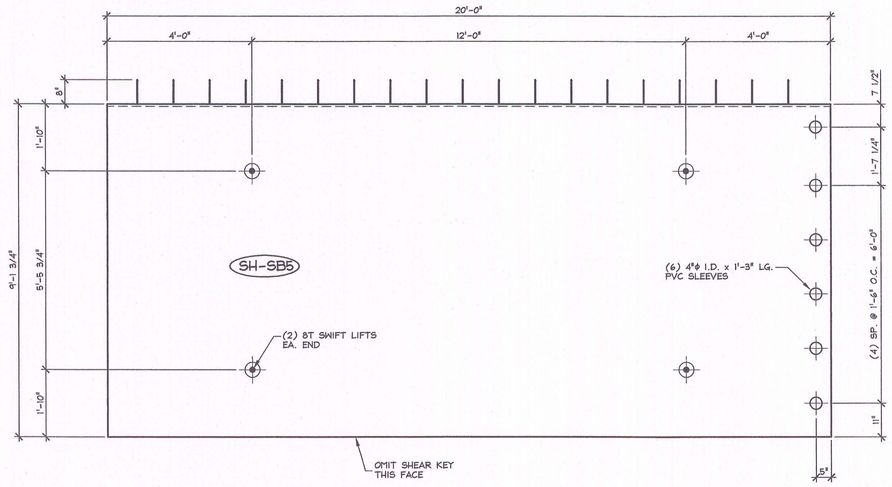

1 AS5 PLAN VIEW IN FORM
1/2" = 1'-0"

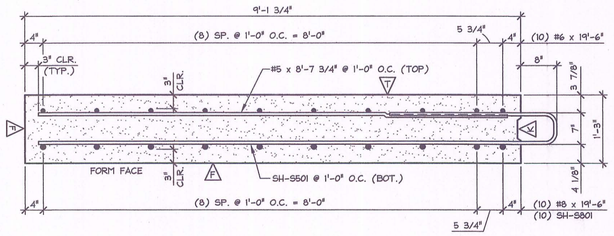

A = FLOAT FINISH
B = BLAST FINISH
F = FORM FINISH

A AS5 REINFORCING SECTION
3/4" = 1'-0"

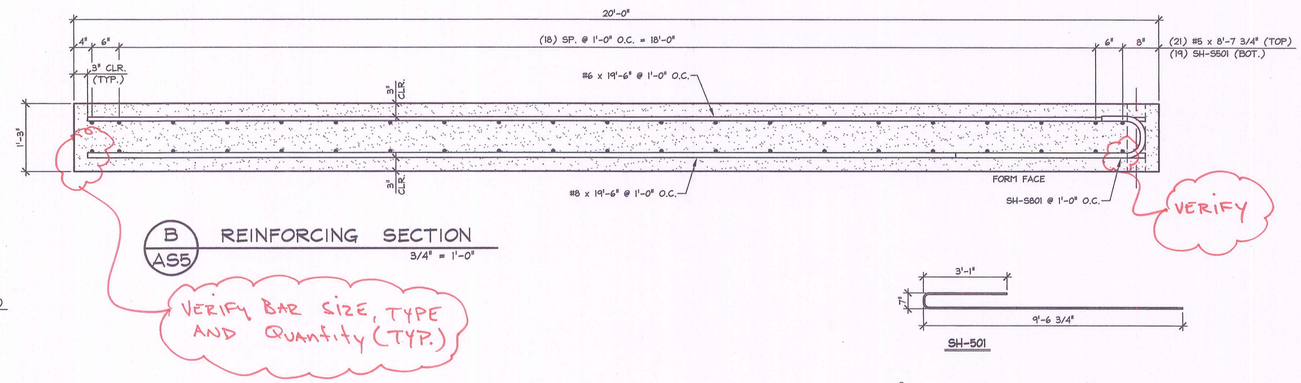

B AS5 REINFORCING SECTION
3/4" = 1'-0"

VERIFY BAR SIZE, TYPE AND QUANTITY (TYP.)

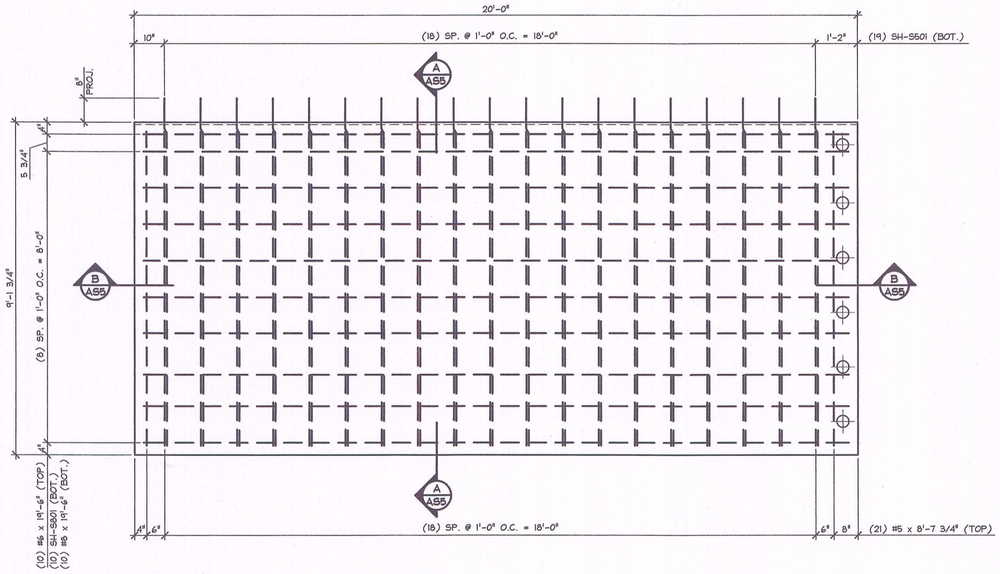

2 AS5 REINFORCING PLAN VIEW IN FORM
1/2" = 1'-0"

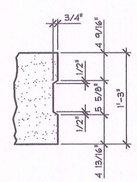

KEYWAY DETAIL
1" = 1'-0"

SH-501

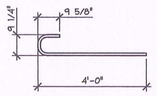

SH-801

3500 PSI @ RELEASE
5000 PSI @ 28 DAYS

MIX DESIGN: 445MSCC

MARK: SH-SB5	QTY.: 1	WT.: 17.08 T	VOL.: 8.43 cy

MATERIAL LIST / ARCH PANEL

ITEM	MARK	DESCRIPTION	QTY.
1		#6 x 19'-6" BLACK	10
2		#8 x 19'-6" BLACK	10
3		#5 x 8'-7 3/4" BLACK	21
4			
5	SH-S501	#5 BENT BAR BLACK	19
6	SH-S801	#8 BENT BAR BLACK	10
7			
8			
9			
10		DAYTON 8T x 10" SWIFT LIFT ANCHORS (WITH RECESS PLUG)	4
11			
12		4"ϕ I.D. x 1'-3" LG. PVC SLEEVE	6
13			
14			
15			

Vermont Agency of Transportation
RECEIVED
ON: December 13, 2013
and Checked for
CONFORMANCE
BY: Jennifer Fitch DATE: 12/23/2013

SUBMITTED
DEC 12 2013
J. P. CARRARA & SONS, INC.
MIDDLEBURY, VT 05753

SHOP DRAWING REVIEW

☐ REVIEWED AS REQUIRED BY THE CONSTRUCTION CONTRACT DOCUMENTS AND APPROVED, BUT ONLY FOR CONFORMANCE TO THE DESIGN CONCEPT OF THE WORK, AND SUBJECT TO FURTHER LIMITATIONS AND REQUIREMENTS CONTAINED IN THE CONSTRUCTION CONTRACT DOCUMENTS.
☐ REJECTED ☑ REVISE AND RESUBMIT ☐ FURNISH AS CORRECTED

CORRECTIONS OR COMMENTS MADE ON THE SHOP DRAWINGS DURING THIS REVIEW DO NOT RELIEVE CONTRACTOR FROM COMPLIANCE WITH REQUIREMENTS OF THE DRAWINGS AND SPECIFICATIONS. THIS CHECK IS ONLY FOR REVIEW OF GENERAL CONFORMANCE WITH THE DESIGN CONCEPT OF THE PROJECT AND GENERAL COMPLIANCE WITH THE INFORMATION GIVEN IN THE CONTRACT DOCUMENTS. THE CONTRACTOR IS RESPONSIBLE FOR: CONFIRMING AND CORRELATING ALL QUANTITIES AND DIMENSIONS; SELECTING FABRICATION PROCESSES AND TECHNIQUES OF CONSTRUCTION; COORDINATING HIS WORK WITH THAT OF ALL OTHER TRADES; AND PERFORMING HIS WORK IN A SAFE AND SATISFACTORY MANNER.

VHB Vanasse Hangen Brustlin, Inc.
Job Number: 57433.00
Reviewed By: G.E. Goodrich
Date: 12-19-2013

APPROVAL STAMP:

J.P. CARRARA & SONS INC.
Precast & Prestress Manufacturer
2464 CASE STR., MIDDLEBURY, VERMONT 05753 Phone:(802)388-6361 Fax:(802)388-9010

T. BUCK CONSTRUCTION
CONTRACTOR
AUBURN, MAINE

STATE OF VERMONT AGENCY OF TRANSPORTATION
COUNTY OF ADDISON

TOWN OF MIDDLEBURY
ROUTE NO. VT 125, EAST MIDDLEBURY GORGE
BRIDGE NO.: 13 PROJECT NO.: RS 0174(8)

APPROACH SLAB DETAILS

DATE: OCT. 9, 2013
SCALE: NOTED
CHKD: DFTM: T.D.
JOB NO:
DWG. NO: AS5

F:\VT-Bridges\East Middlebury Gorge\23411-013 AS5.dwg, 12/12/2013 11:44:01 AM

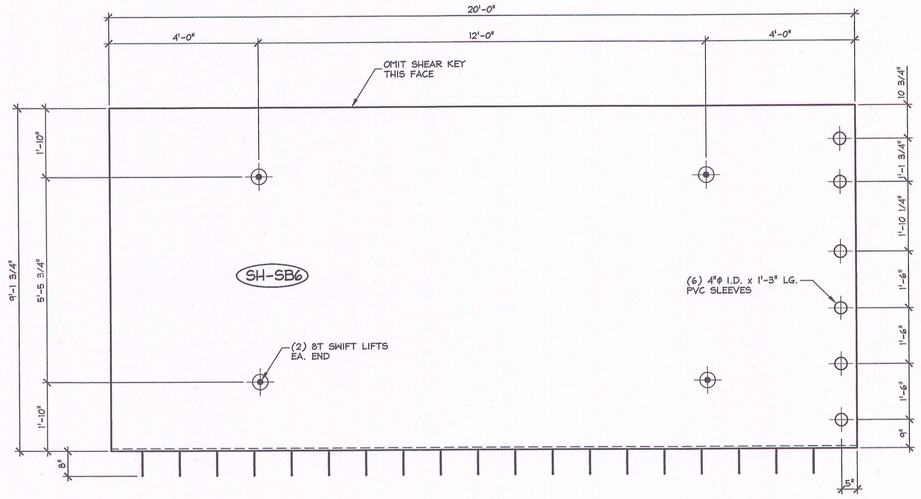

1 AS6 PLAN VIEW IN FORM
1/2" = 1'-0"

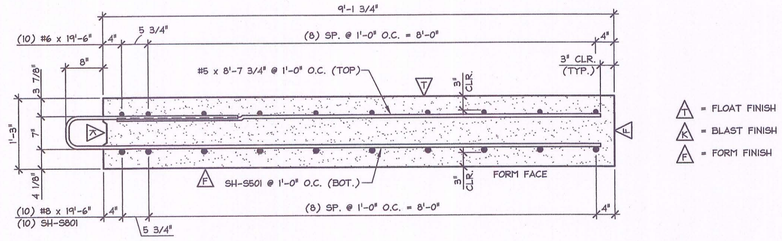

A AS6 REINFORCING SECTION
3/4" = 1'-0"

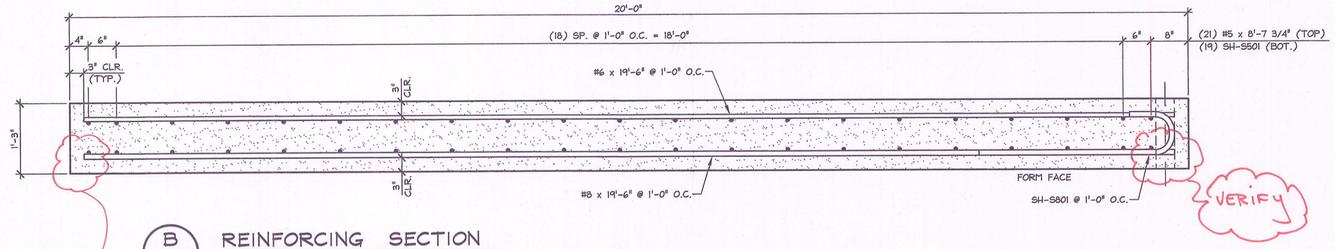

B AS6 REINFORCING SECTION
3/4" = 1'-0"

VERIFY BAR SIZE, TYPE AND QUANTITY (TYP.)

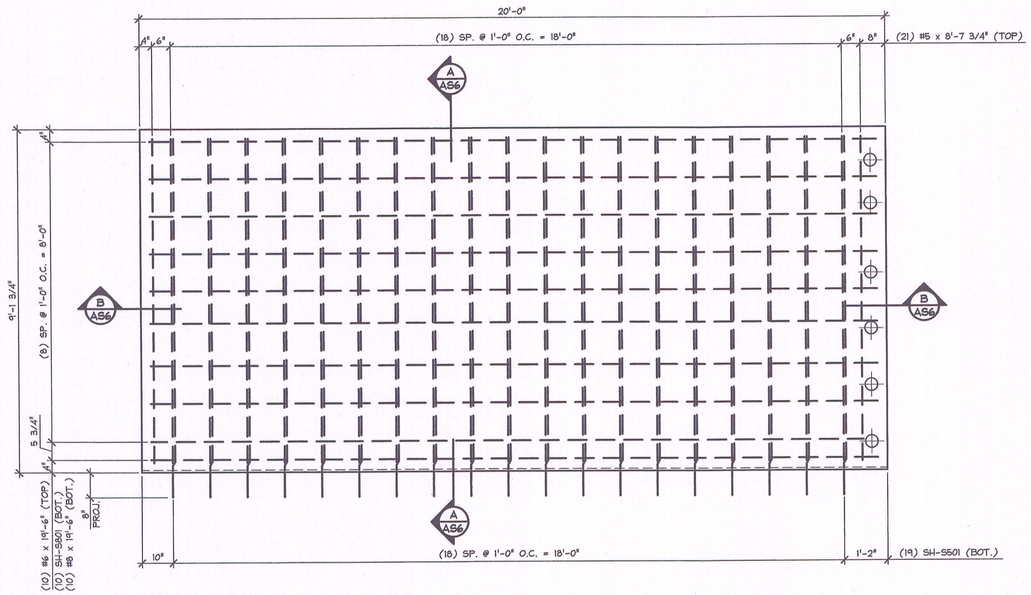

2 AS6 REINFORCING PLAN VIEW IN FORM
1/2" = 1'-0"

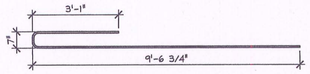

SH-501

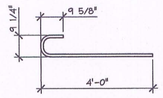

SH-801

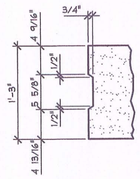

KEYWAY DETAIL
1" = 1'-0"

3500 PSI @ RELEASE
5000 PSI @ 28 DAYS

MIX DESIGN: 445MSCC

MARK: SH-SB6	QTY.: 1	WT.: 17.08 T	VOL.: 8.43 cy

MATERIAL LIST / ARCH PANEL

ITEM	MARK	DESCRIPTION	QTY.
1		#6 x 19'-6" BLACK	10
2		#8 x 19'-6" BLACK	10
3		#5 x 8'-7 3/4" BLACK	21
4			
5	SH-S501	#5 BENT BAR BLACK	19
6	SH-S801	#8 BENT BAR BLACK	10
7			
8			
9			
10		DAYTON 8T x 10" SWIFT LIFT ANCHORS (WITH RECESS PLUG)	4
11			
12		4"ϕ I.D. x 1'-3" LG. PVC SLEEVE	6
13			
14			
15			

Vermont Agency of Transportation
RECEIVED
ON: December 13, 2013
and Checked for
CONFORMANCE
BY: Jennifer Fitch DATE: 12/23/2013

SUBMITTED
DEC 12 2013
J. P. CARRARA & SONS, INC.
MIDDLEBURY, VT 05753

SHOP DRAWING REVIEW
☐ REVIEWED AS REQUIRED BY THE CONSTRUCTION CONTRACT DOCUMENTS AND APPROVED, BUT ONLY FOR CONFORMANCE TO THE DESIGN CONCEPT OF THE WORK, AND SUBJECT TO FURTHER LIMITATIONS AND REQUIREMENTS CONTAINED IN THE CONSTRUCTION CONTRACT DOCUMENTS.
☐ REJECTED ☑ REVISE AND RESUBMIT ☐ FURNISH AS CORRECTED
CORRECTIONS OR COMMENTS MADE ON THE SHOP DRAWINGS DURING THIS REVIEW DO NOT RELIEVE CONTRACTOR FROM COMPLIANCE WITH REQUIREMENTS OF THE DRAWINGS AND SPECIFICATIONS. THIS CHECK IS ONLY FOR REVIEW OF GENERAL CONFORMANCE WITH THE DESIGN CONCEPT OF THE PROJECT AND GENERAL COMPLIANCE WITH THE INFORMATION GIVEN IN THE CONTRACT DOCUMENTS. THE CONTRACTOR IS RESPONSIBLE FOR: CONFIRMING AND CORRELATING ALL QUANTITIES AND DIMENSIONS; SELECTING FABRICATION PROCESSES AND TECHNIQUES OF CONSTRUCTION; COORDINATING HIS WORK WITH THAT OF ALL OTHER TRADES; AND PERFORMING HIS WORK IN A SAFE AND SATISFACTORY MANNER.
VHB Vanasse Hangen Brustlin, Inc.
Job Number: 52438.00
Reviewed By: G.S. Goodrich
Date: 12-17-2013

APPROVAL STAMP:

J.P. CARRARA & SONS INC.
Precast & Prestress Manufacturer
2464 CASE STR., MIDDLEBURY, VERMONT 05753 Phone:(802)388-6361 Fax:(802)388-9010

T. BUCK CONSTRUCTION
CONTRACTOR
AUBURN, MAINE

STATE OF VERMONT AGENCY OF TRANSPORTATION
COUNTY OF ADDISON

TOWN OF MIDDLEBURY
ROUTE NO. VT 125, EAST MIDDLEBURY GORGE
BRIDGE NO.: 13 PROJECT NO.: RS 0174(8)

APPROACH SLAB DETAILS

DATE: OCT. 9, 2013
SCALE: NOTED
CHKD: DFTM: T.D.
JOB NO:
DWG. NO: AS6