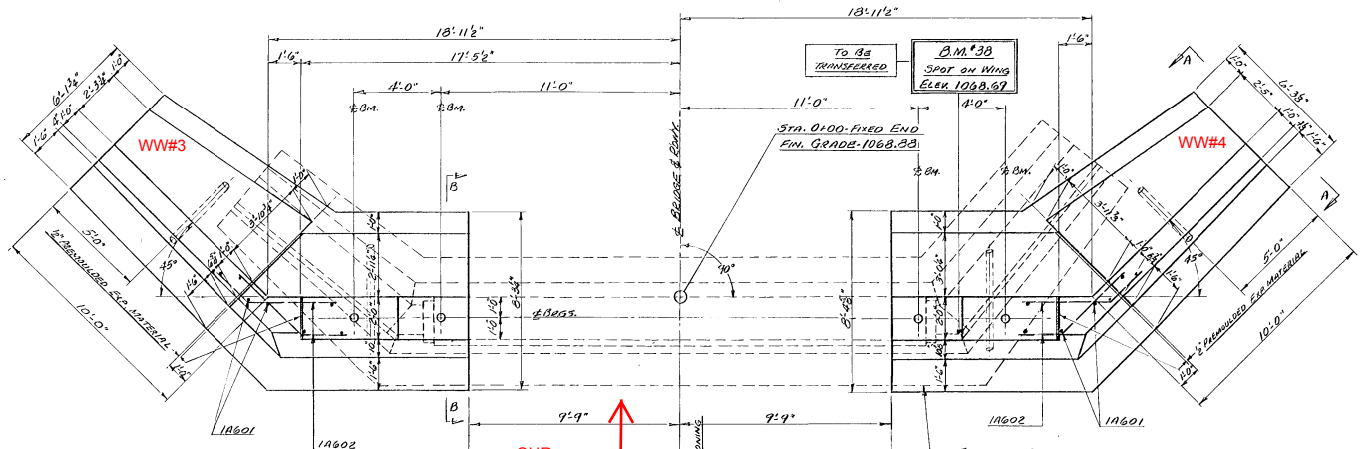

ELEVATION

NOTE

WHEN THE EXCAVATION BEGINS FOR NEW PORTIONS OF THE ABUTMENT, WOOD SHEET PILES TO BE DRIVEN ALONG THE FACES OF THE CUT LINES AND LEFT IN PLACE TO PREVENT UNDER-CUTTING OF EXISTING ABUTMENT. WOOD SHEET PILES TO BE CUT OFF AT AN ELEVATION BELOW PERMANENT WATER LEVEL. LENGTH OF THE WOOD SHEET PILES TO BE DETERMINED BY THE ENGINEER. WORK AND MATERIALS TO BE INCLUDED IN UNIT BID PRICE FOR STRUCTURE EXCAVATION, ITEM 107.

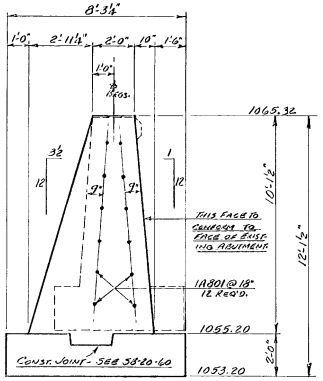

SECTION B-B

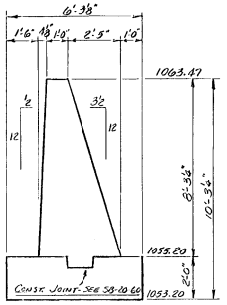

VIEW A-A

— LIST OF SHEETS —

1	DETAILS OF ABUTMENT NO. 1
2	DETAILS OF ABUTMENT NO. 2
3	SUPERSTRUCTURE DETAILS
4	REINFORCING STEEL DETAILS
5	CHANNEL SECTIONS
6	STD. DWG. 38-SG-60 (SH. 2)
7	" " 318-30 (11-20)
8	" " SCB-D-60
9	" " 38-20-60
10	" " E-2

— SUMMARY OF QUANTITIES —

ITEM No.	ITEM	UNIT	NET	OVERRUN	TOTAL	FINAL
106-A	CHAN. EXCAV. OF EARTH	C.Y.				
106-B	CHAN. EXCAV. OF ROCK	C.Y.				
106-C	UNCLASS. CHAN. EXCAV.	C.Y.				
107	STRUCT. EXCAV.	C.Y.	100	10	110	
401-B	CONC. CLASS B (MOD.)	C.Y.	71	4	75	
402	REINF. STEEL (See Reinf. Steel Dets.)	LBS.				
407	ASPHALTIC-ASB. COATING	S.Y.				
502-B	TREATED TIMBER PILING	L.F.				
503	SPLICES FOR STEEL PILING	EA.				
504	STEEL PILING	L.F.				
502-A	UNTREATED TIMBER PILING	L.F.				
101-B	SOLID ROCK EXCAVATION	C.Y.	5	-	5	

ITEM No.	ITEM	UNIT	NET	OVRUN	TOTAL	FINAL
101-B	SOLID ROCK EXCAVATION	C.Y.	20	-	20	
107	STRUCTURE EXCAVATION	C.Y.	230	23	253	
318	TAR EMULSION FOR BRIDGE FLOORS	GAL.	62	-	62	
361-B	BITUMINOUS CONC. PAVEMENT (MOD)	TON	20	3	23	
372	JOINT SEALER, HOT POURED ELASTIC TYPE	L.F.	92	-	92	
401-B	CONCRETE CLASS B (MOD)	C.Y.	174	9	183	
402	REINFORCING STEEL	LB.	5980	-	5980	
404-A	STRUCTURAL STEEL	LB.	22,786	496	23,282	
536-C	GRANITE BRIDGE CURB (MOD)	L.F.	92	-	92	
572	BRIDGE RAILING (2 RAIL GALVANIZED)	L.F.	92	-	92	
574	PIER SUPERSTRUCTURE FOR WIDENING	L.S.	1	-	1	

STATE OF VERMONT
DEPARTMENT OF HIGHWAYS

TOWN OF ANDOVER
ROUTE NO. VT. 11 LOG STA. 140+79
DETAILS OF ~~ABUTMENT NO. 1~~ ABUTMENT #2
SCALE 3/8" = 1'-0"
SURVEYED BY BURLEY
DRAWN BY RKJ 3/28 CHECKED BY RLM 3-26-38
PROJECT NO. MA 253(25)03M/1960
SHEET 1 OF 10

PROJECT NUMBER MA-253(25)03M/1960 LENGTH ML
TYPE Bridge widening YEAR 19
CONTRACTOR
LOCATION Rt #11 - Log Sta. 140+79

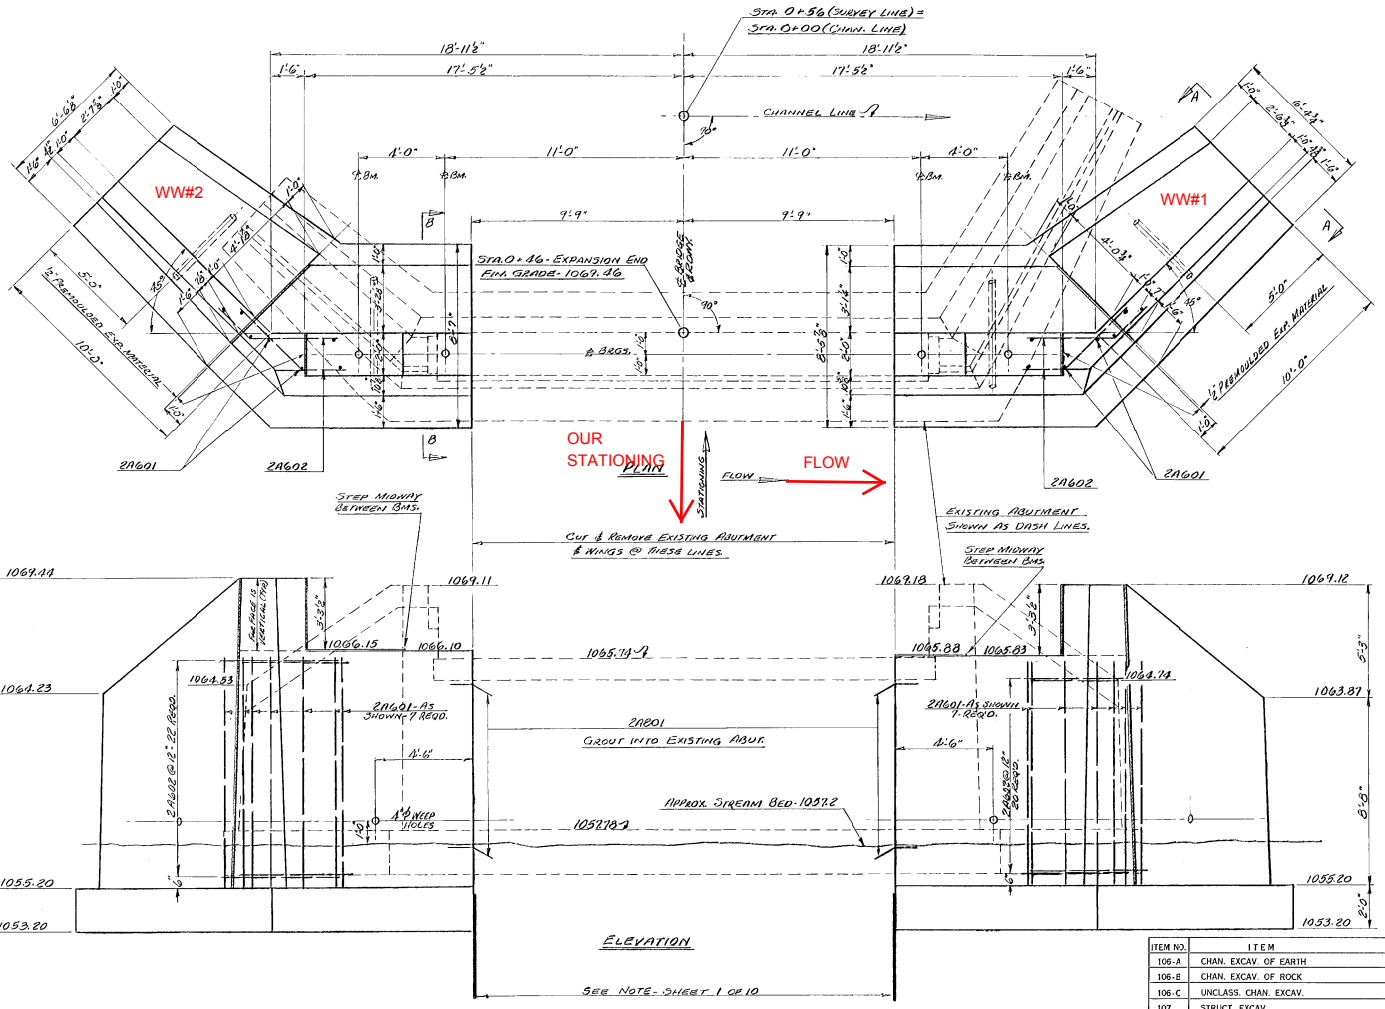

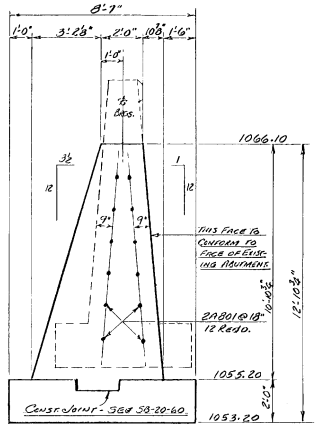

SECTION B-B

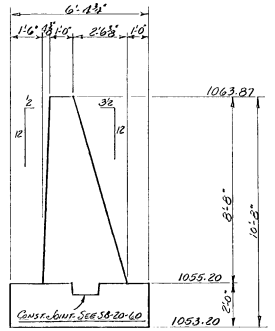

VIEW A-A

ITEM NO.	ITEM	UNIT	NET	OVERRUN	TOTAL	FINAL
106-A	CHAN. EXCAV. OF EARTH	C.Y.				
106-B	CHAN. EXCAV. OF ROCK	C.Y.				
106-C	UNCLASS. CHAN. EXCAV.	C.Y.				
107	STRUCT. EXCAV.	C.Y.	130	13	143	
401-B	CONC. CLASS B (MOD.)	C.Y.	76	4	80	
402	REINF. STEEL (See Reinf. Steel Dets.)	LBS.				
407	ASPHALTIC-ASB. COATING	S.Y.				
502-B	TREATED TIMBER PILING	L.F.				
503	SPLICES FOR STEEL PILING	EA.				
504	STEEL PILING	L.F.				
502-A	UNTREATED TIMBER PILING	L.F.				
101-B	SOLID ROCK EXCAVATION	C.Y.	15	–	15	

STATE OF VERMONT
DEPARTMENT OF HIGHWAYS

TOWN OF ANDOVER
ROUTE NO. Vt. 11 LOG STA. 110+72
DETAILS OF ~~ABUTMENT NO. 2~~
ABUTMENT #1
SCALE 3/8" = 1'-0"
SURVEYED BY BURLEY
DRAWN BY R.E.B. 3/62 CHECKED BY RLM 3-22-62
PROJECT NO. BIA 237(25)03M/1960
SHEET 2 OF 10

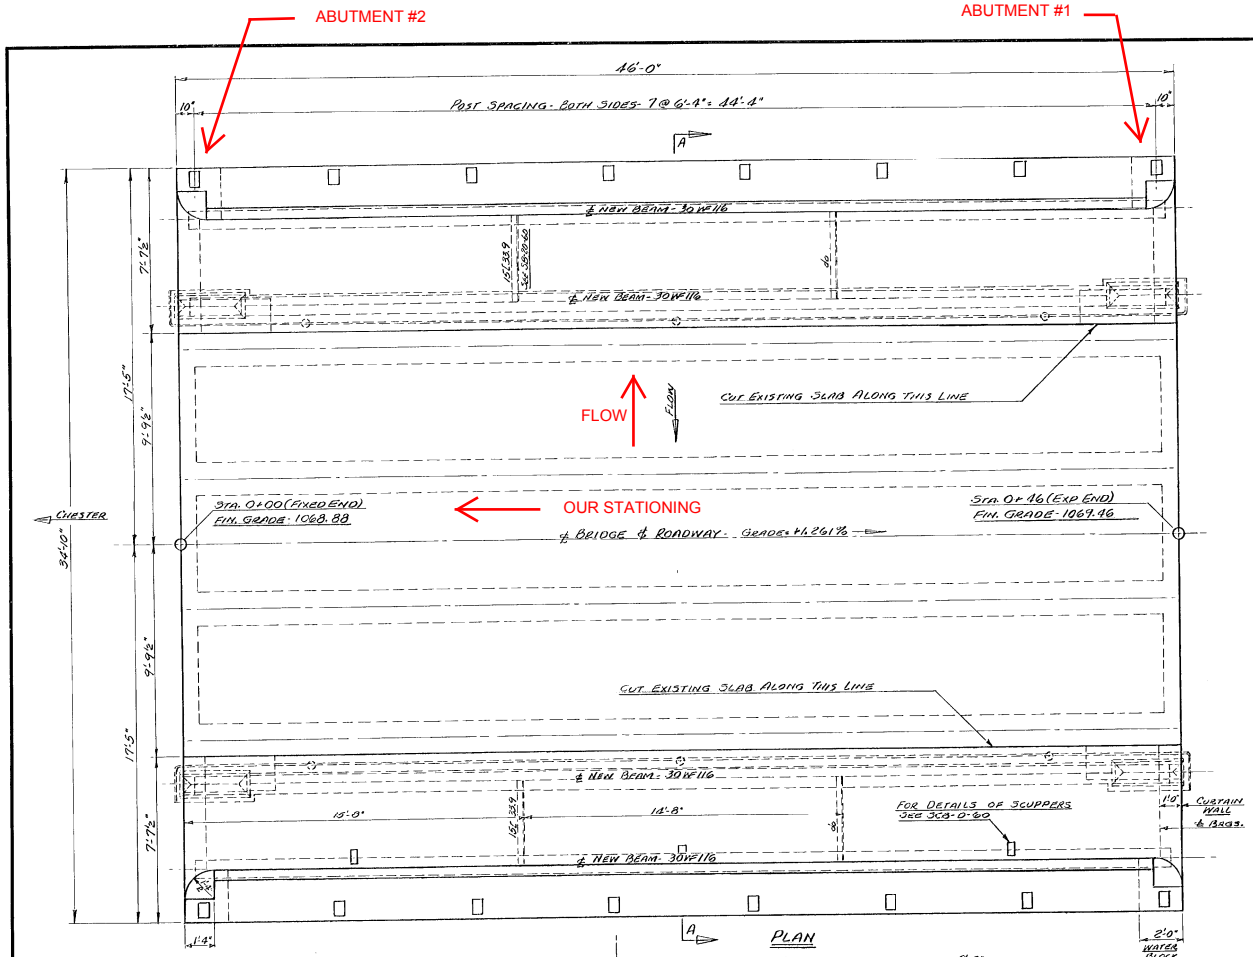

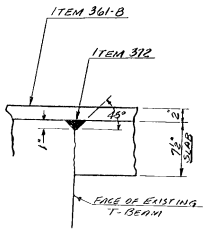

VIEW A
SCALE - 1½" = 1'-0"

~NOTES~

FOR DETAILS NOT SHOWN, REFER TO THE FOLLOWING STANDARD DRAWINGS:
3A-5G-60 (SHEET 2)
3I8-30 (11-20)
3C8-D-60
3B-20-60
E-2

REMOVE PRESENT BITUMINOUS WEARING SURFACE FROM EXISTING STRUCTURE. COST OF SUCH WORK TO BE INCLUDED IN UNIT PRICE BID FOR ITEM 574.

RETAIN TRANSVERSE REINFORCING STEEL IN SLABS WHEN REMOVING PRESENT CURB AND RAIL, AND SPLICE TO 3501 BARS.

BEAMS TO BE UNCAMBERED.

ITEM NO.	ITEM	UNIT	NET	OVERRUN	TOTAL	FINAL
106-A	CHAN. EXCAV. OF EARTH	C. Y.				
106-B	CHAN. EXCAV. OF ROCK	C. Y.				
106-C	UNCLASS. CHAN. EXCAV.	C. Y.				
107	STRUCT. EXCAV.	C. Y.				
401-B	CONC. CLASS B (MOD.)	C. Y.	27	1	28	
402	REINF. STEEL (SEE REINF STEEL DETS.)	LBS.				
404-A	STRUCTURAL STEEL	LB.	22,706	456	23,202	
502-B	TREATED TIMBER PILING	L. F.				
503	SPLICES FOR STEEL PILING	EA.				
504	STEEL PILING	L. F.				
502-A	UNTREATED TIMBER PILING	L. F.				
318	TAR EMULSION FOR BRIDGE FLOORS	GAL.	68	—	68	
361-B	BITUMINOUS CONCRETE PAVT. (MOD.)	TON	20	3	23	
372	JOINT SEALER, HOT-POURED ELASTIC TYPE	L.F.	92	-	92	
556-C	GRANITE BRIDGE CURB (MOD.)	L.F.	92	-	92	
572	BRIDGE RAILING (2 TUBE-GALVANIZED)	L.F.	92	-	92	
574	PREP SUPERSTRUCTURE FOR WIDENING	L.S.	1	-	1	

STATE OF VERMONT
DEPARTMENT OF HIGHWAYS

TOWN OF ANDOVER
ROUTE NO. VT. 11 LOG STA. 140+79
SUPERSTRUCTURE DETAILS

SCALE 3/8" = 1'-0"
SURVEYED BY BUREAU
DRAWN BY BJG 9/62 CHECKED BY RLM 3-22-62
PROJECT NO. 81A257/F5033(1)1960
SHEET 3 OF 10

Item	No. Pieces	Size	Length	Mark	Type	A	B	C	D	E	F	G	H	J	K	R	O
153																	
154	14	6	9-10	1AG01	STR.												
155	40	6	6-0	1AG02	19			2-0	4-0	NONE				1-5		1-5	
156	24	8	2-0	1AB01	19			1-0	1-0	NONE				0-6		0-10⅜	
157																	
158																	
159	14	6	10-4	2AG01	STR.												
170	42	6	6-0	2AG02	19			2-0	4-0	NONE				1-5		1-5	
171	24	8	2-0	2AB01	19			1-0	1-0	NONE				0-6		0-10⅜	
172																	
173																	
174																	
175																	
176																	
177	68	4	23-9	5401	STR.												
178	392	5	7-8	3501	STR.												
179	8	6	24-0	3601	STR.												
180																	
181	80	4	5-1	5403	33	0-5	1-5	1-5	1-5			0-5	0-3				
182	24	4	5-11	5402	52	0-5	3-2½	0-8	2-2½			0-5	0-3				
183																	
184																	
185																	
186																	
187																	
188																	
189																	
190																	

- ABUTMENT NO. 1 -

- ABUTMENT NO 2 -

- SUPERSTRUCTURE -

TYPICAL BAR BENDS

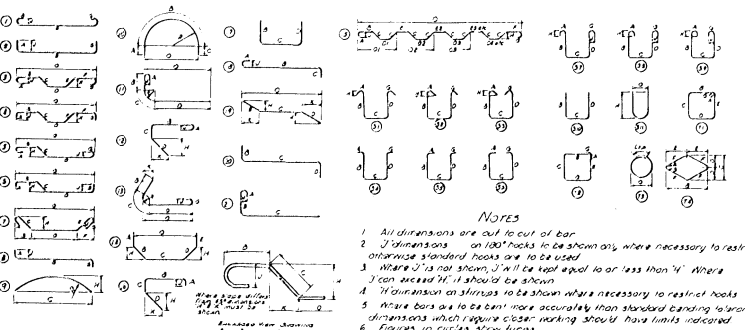

Expansion Hook Spacing Bar Bending Details

NOTES

1. All dimensions are out to out of bar.
2. 'J' dimensions on 180° hooks to be shown only where necessary to restrict hook size otherwise standard hooks are to be used.
3. Where 'J' is not shown, 'J' will be kept equal to or less than 'H'. Where 'J' can exceed 'H', it should be shown.
4. 'H' dimension on stirrups to be shown where necessary to restrict hooks.
5. Where bars are to be bent more accurately than standard bending tolerances, bending dimensions which require closer working should have limits indicated.
6. Figures in circle show types.
7. No allowance for bend curvature is to be made except for standard hook & loops in excess of 360°.

GNT

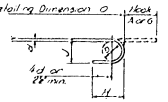

STANDARD HOOK DETAIL

BAR SIZES

Equivalent Size	Present (Numbers)
¼"	#2
⅜"	#3
½"	#4
⅝"	#5
¾"	#6
⅞"	#7
1"	#8
1 1/8"	#9
1 3/8"	#10
1 3/4"	#11

All Bar reinforcement material shall conform to the requirements of the Standard Specifications for new Billet-Steel Concrete Reinforcement Bars (Intermediate Grade) Serial Designation AASHO M31-49 or ASTM A305-49.
All bars shall be determined to conform with A.S.T.M. Specifications A 305-49.

ESTIMATED QUANTITIES

Location	Pounds
ABUTMENT NO. 1	696
ABUTMENT NO. 2	724
SUPERSTRUCTURE	4560
TOTAL	5980

ANDOVER

REINFORCING STEEL DETAILS

MA259/2503M/1960

CED RLM

SHEET 4 OF 10

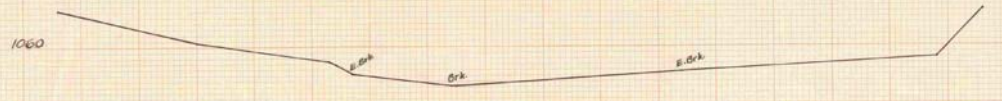

0+42

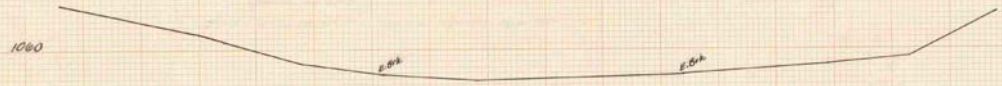

0+32 ABUTMENT No. 2
STA. 0+29 = EARD OF STRUCTURE EXCAVATION - ITEM 107

ABUTMENT No. 1
STA. 0+29 = EARD OF STRUCTURE EXCAVATION - ITEM 107

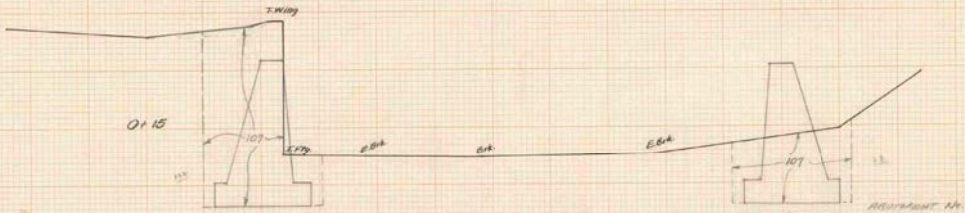

ABUTMENT No. 2
STA. 0+9.75 = BEGIN STRUCTURE EXCAVATION - ITEM 107

ABUTMENT No. 1
STA. 0+9.75 = BEGIN STRUCTURE EXCAVATION - ITEM 107

1 INCH = 5 FEET

ANDOVER
CHANNEL SECTIONS

LEVELS BY BUKLEY
SECTIONS PLOTTED BY K.T.S. CKD. BY R.L.D.
PLANIMETERED BY K.T.S. CKD. BY L.L.F.
EXAMINED BY
M0259 NO. 65031M FILED 1960
SHEET 5 OF 10

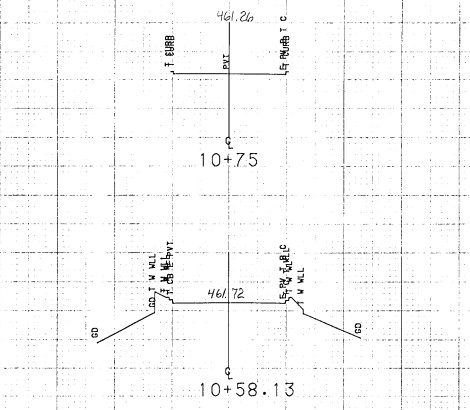

STA 10+55.75

BEGIN BRIDGE

STA 10+56 RT END STONE FILL TYPE II

STA 10+50
END APPROACH
BEGIN PROJECT

STONE FILL TYPE II

STA 10+40 RT BEGIN STONE FILL TYPE II

STA 10+18
BEGIN APPROACH
MATCH 5" NEW PAVEMENT TH 3
INTO EDGE OF PAVEMENT VT. 14

SCALE 10 FEET

FROM STA. 10+00		TO STA. 10+75	
PROJECT NAME	SHARON M4		
NO.	TH2504		PLOTTED 03/12/93
SURVEYED BY	WARNER	01/93	C376
SHEET 20 OF 55 SHEETS			

Vermont Agency of
Transportation
PHASE 1-INTERSTATE
#12302-01

INITIALS

DONE

Box 932

1962

ANDOVER
MA259/25.03m/1960

1962